


EUREKA No 8

BERWIND WHITE COAL MINING CO.

1 INCH = 100 FT

Eureka 8

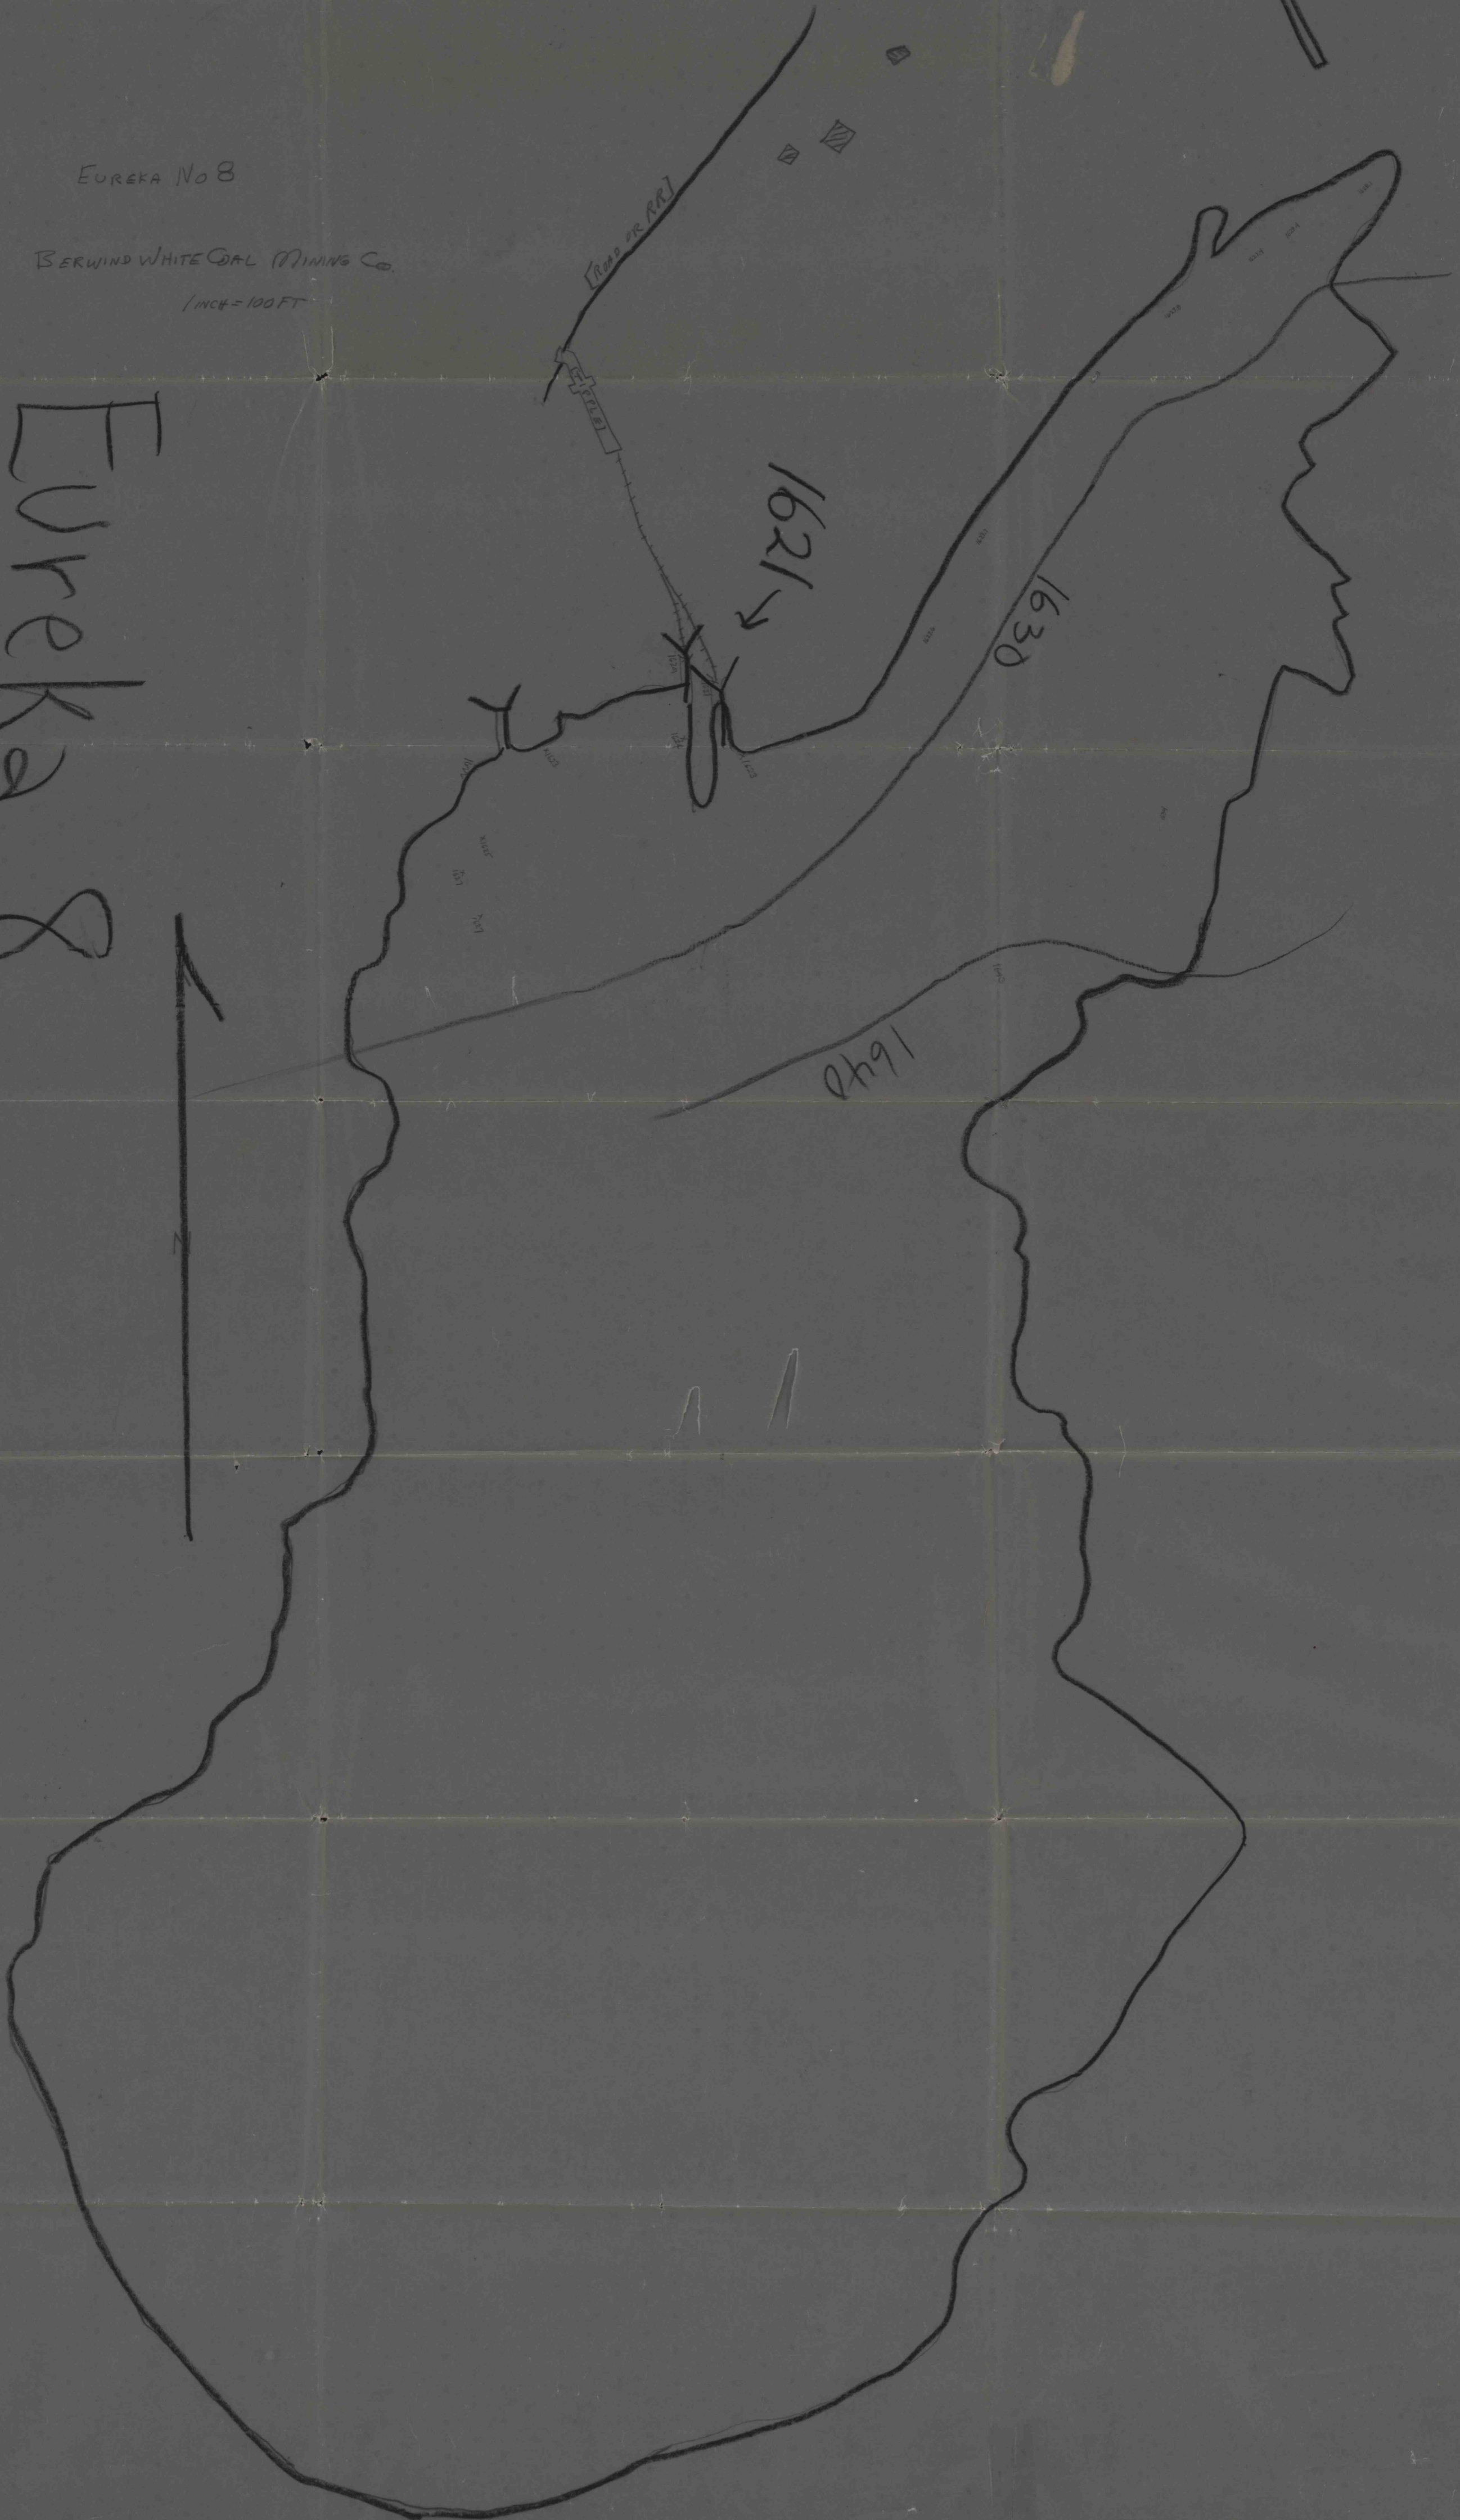

1000