


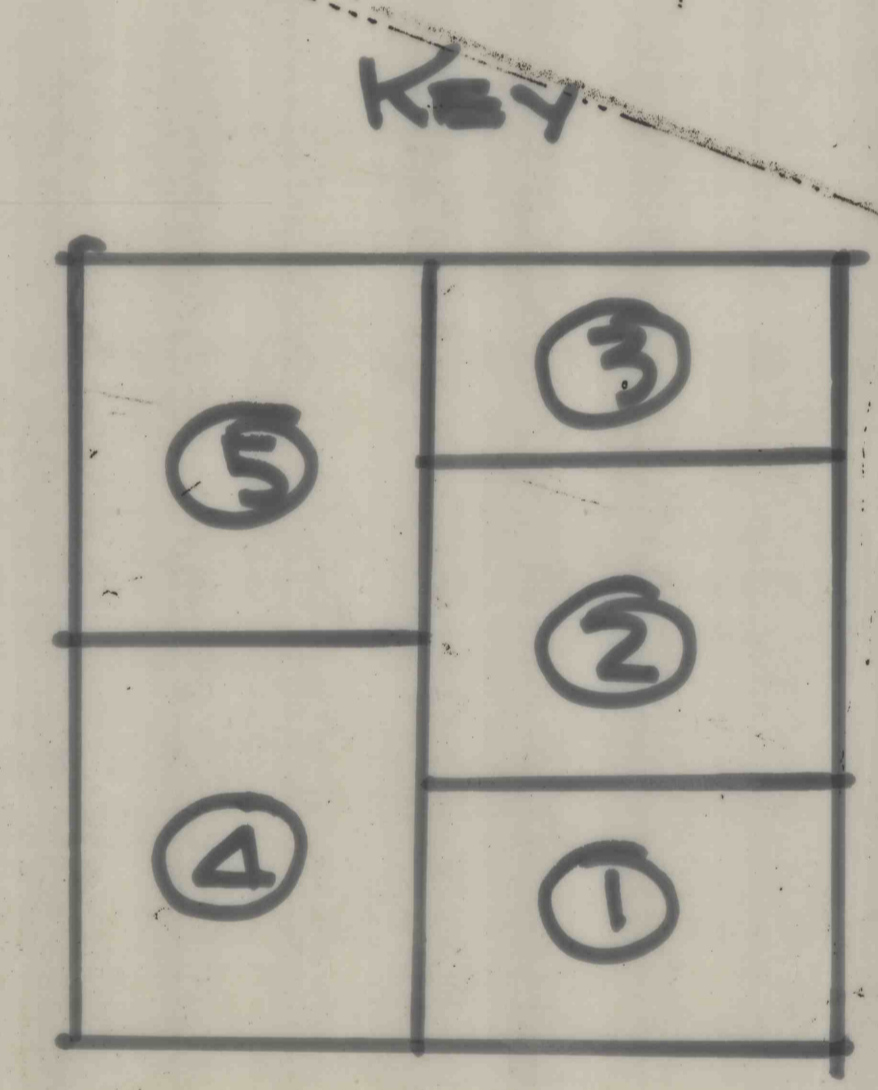

JARRIN
RKINS



BUTTS GANNEL COAL CO.
MAP OF
BESSEMER MINE

SITUATE IN
 MARION & VENANGO TWP BUTLER CO., PA
 scale 1/4" = 100 feet

located at Deegans on Hillards #5

LEGEND

Symbol	Date of Survey	Surveyor
A	APR 1914	B.J.L.
B	MAR 1915	H.W.B.
C	MAR 1916	E.G.

Note
 All property lines and section of mine workings shown on this map and distances are not shown, are copied from other maps.
 All elevations are referred to mean tide, Sandy Bay, N.S.

USGS MICRO FILM # 316207

PLEASE
 do not touch

