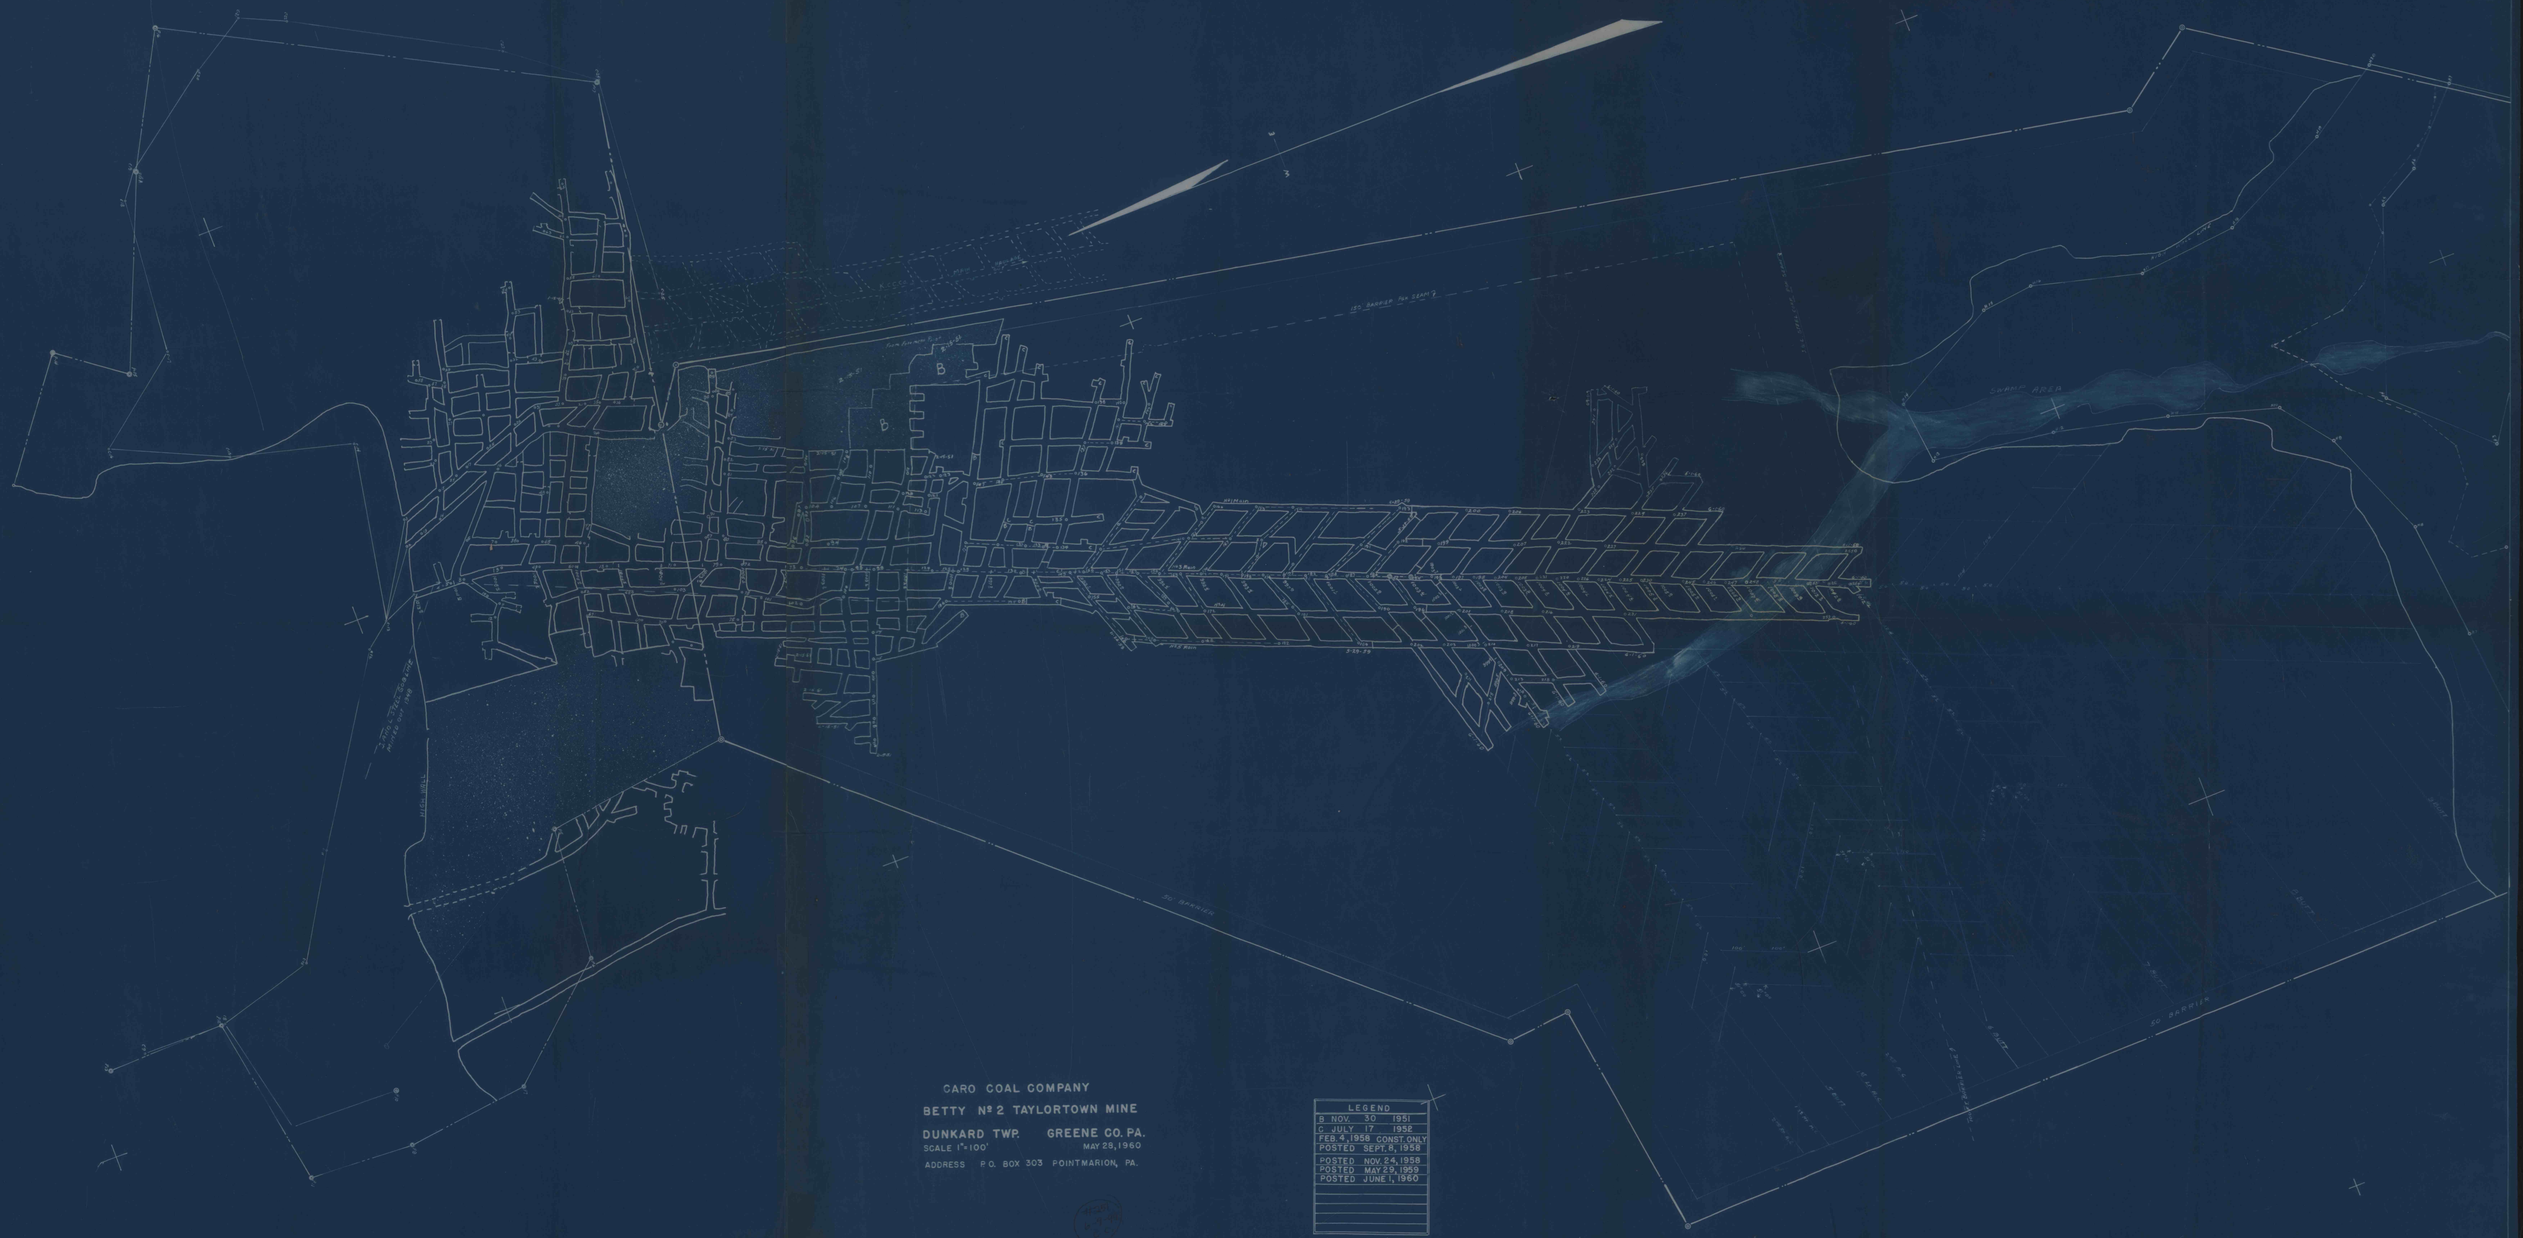

CARO COAL COMPANY

BETTY Nº 2 TAYLORTOWN MINE

DUNKARD TWP. GREENE CO. PA.

SCALE 1"=100' MAY 28, 1960

ADDRESS P.O. BOX 303 POINTMARION, PA.

LEGEND
B NOV. 30 1951
C JULY 17 1952
FEB. 4, 1958 CONST. ONLY
POSTED SEPT. 8, 1958
POSTED NOV. 24, 1958
POSTED MAY 29, 1959
POSTED JUNE 1, 1960