


PENNY SHAFT

1191 (1191/1192)

Coal

6.

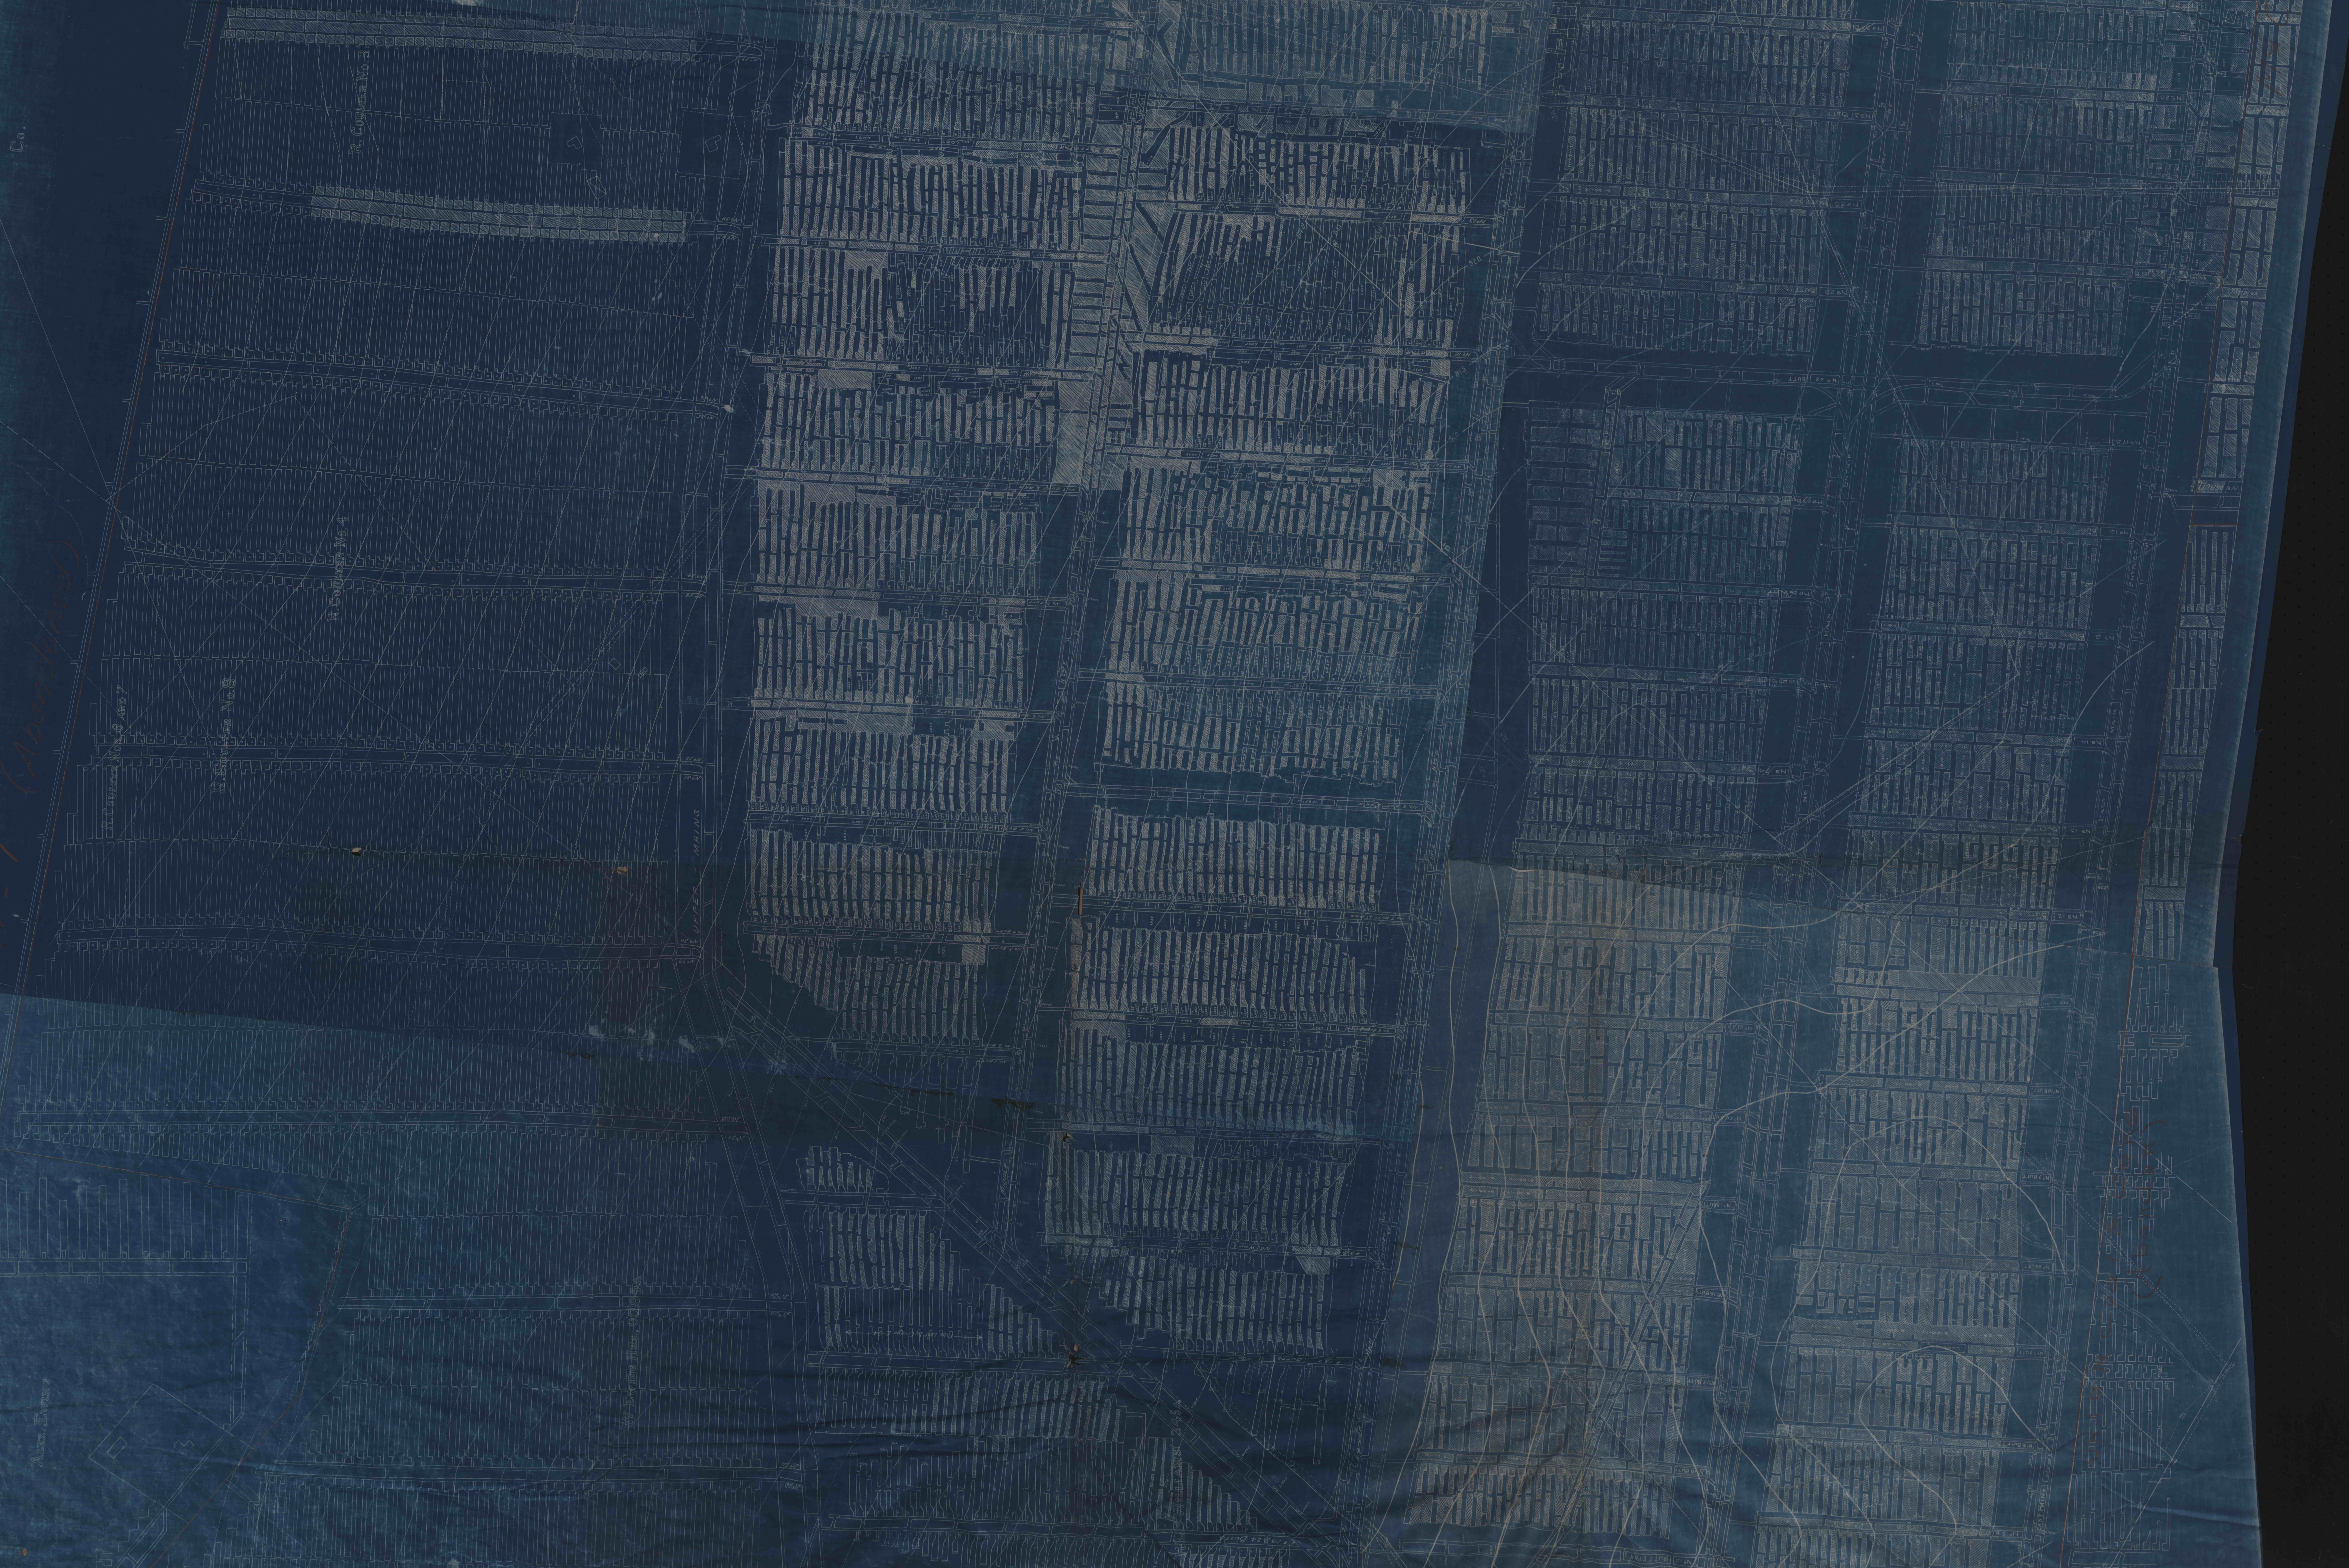






