


BIDDLE MINE  
WESTMORELAND COAL CO  
Scale 1"=100'

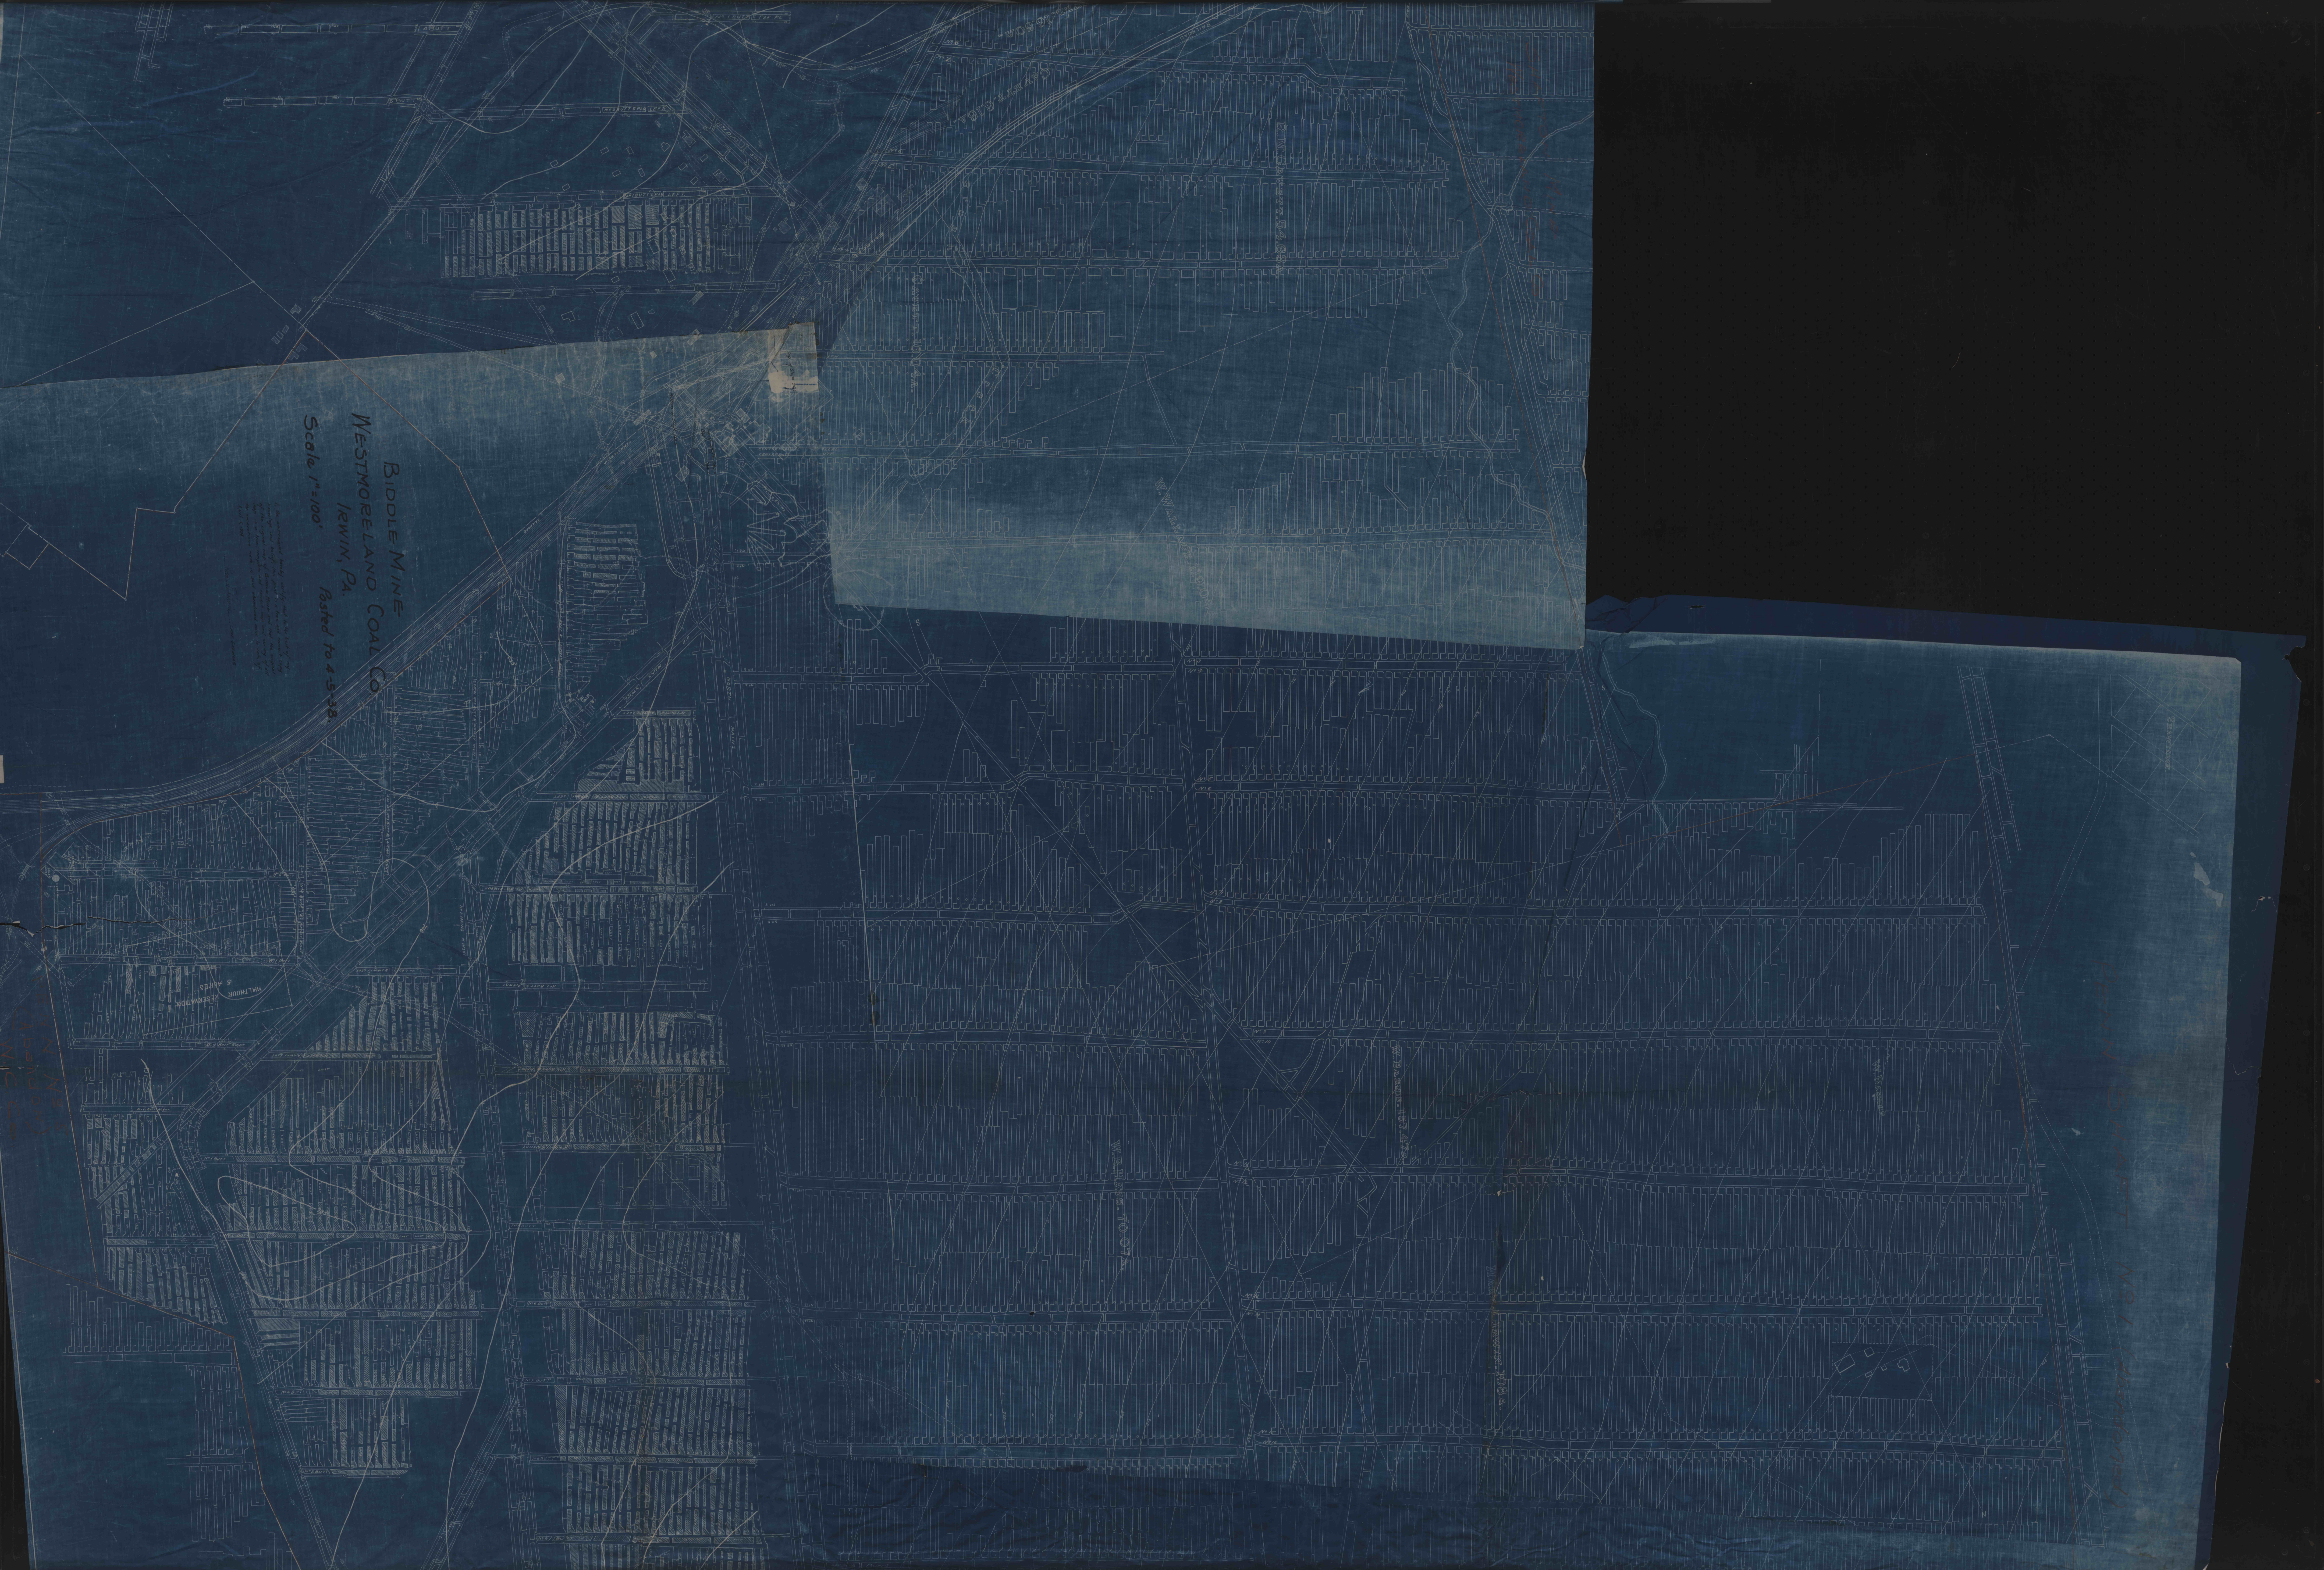

