

ALEXANDER CARSON

10 FACE RT.


CRESCENT # 2 MINE

BIGGIES MINE

MINES FINISHED 12-2-48

BIGGIES MINE  
BIGGIES COAL Co.  
FALLOWFIELD TWP.  
WASHINGTON Co.  
PENNA.

SCALE - 1" = 100'

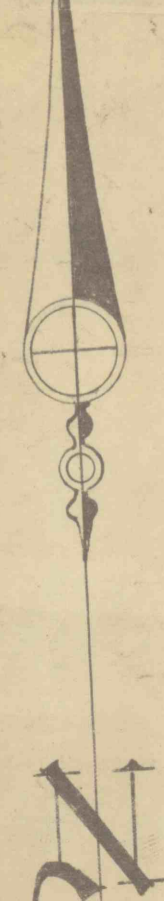

#262  
6-10-99  
C.C.

