

Average coal height
 D seam - 47 inches
 E " - 42 "
 C Prime " 52 "




D workings
 9 3/4 A. Workable D seam
 4 A. " E seam

5 1/2 A. Workable D seam
 2 1/2 A. " E seam

HERMAN KIRKPATRICK
 1 A. Workable D seam
 NO " E "

16.75 A. Workable D seam
 6.00 A. " E seam

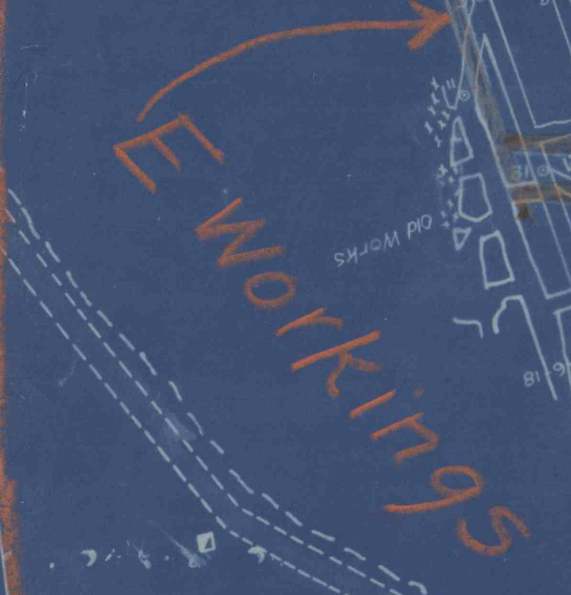

MAP OF
 COAL LANDS
 SITUATE IN
 ELDER TOWNSHIP
 CAMBRIA CO., PA.
 OPERATED BY
 BINDER BROTHERS COAL CO.
 JULY, 1920
 I. J. Feister, Eng'r
 Spangler, Pa.

LEGEND
 D & E Seams leased from Penna. coal & coke Co (Red)
 D & E seams leased from Blubaker Coal Co. (Brown)
 D & E seams leased from Herman Kirkpatrick (Yellow)
 C Prime seam leased from Blubaker Coal Co. (White)

ARCHIE KIRKPATRICK

JAMES KIRKPATRICK

ARCHIE KIRKPATRICK
 4.3 ACRES
 21 A. WORKABLE C PRIME COAL
 LEASED FROM BLUBAKER COAL CO.

JAMES KIRKPATRICK

Jos. McMullen
 5 1/2 A.

FRANCIS HUBER
 1 1/2 A. Coal

HERMAN KIRKPATRICK
 1 A. Coal

FRANCIS HUBER

Reservation
 5 A.

4.6 A

