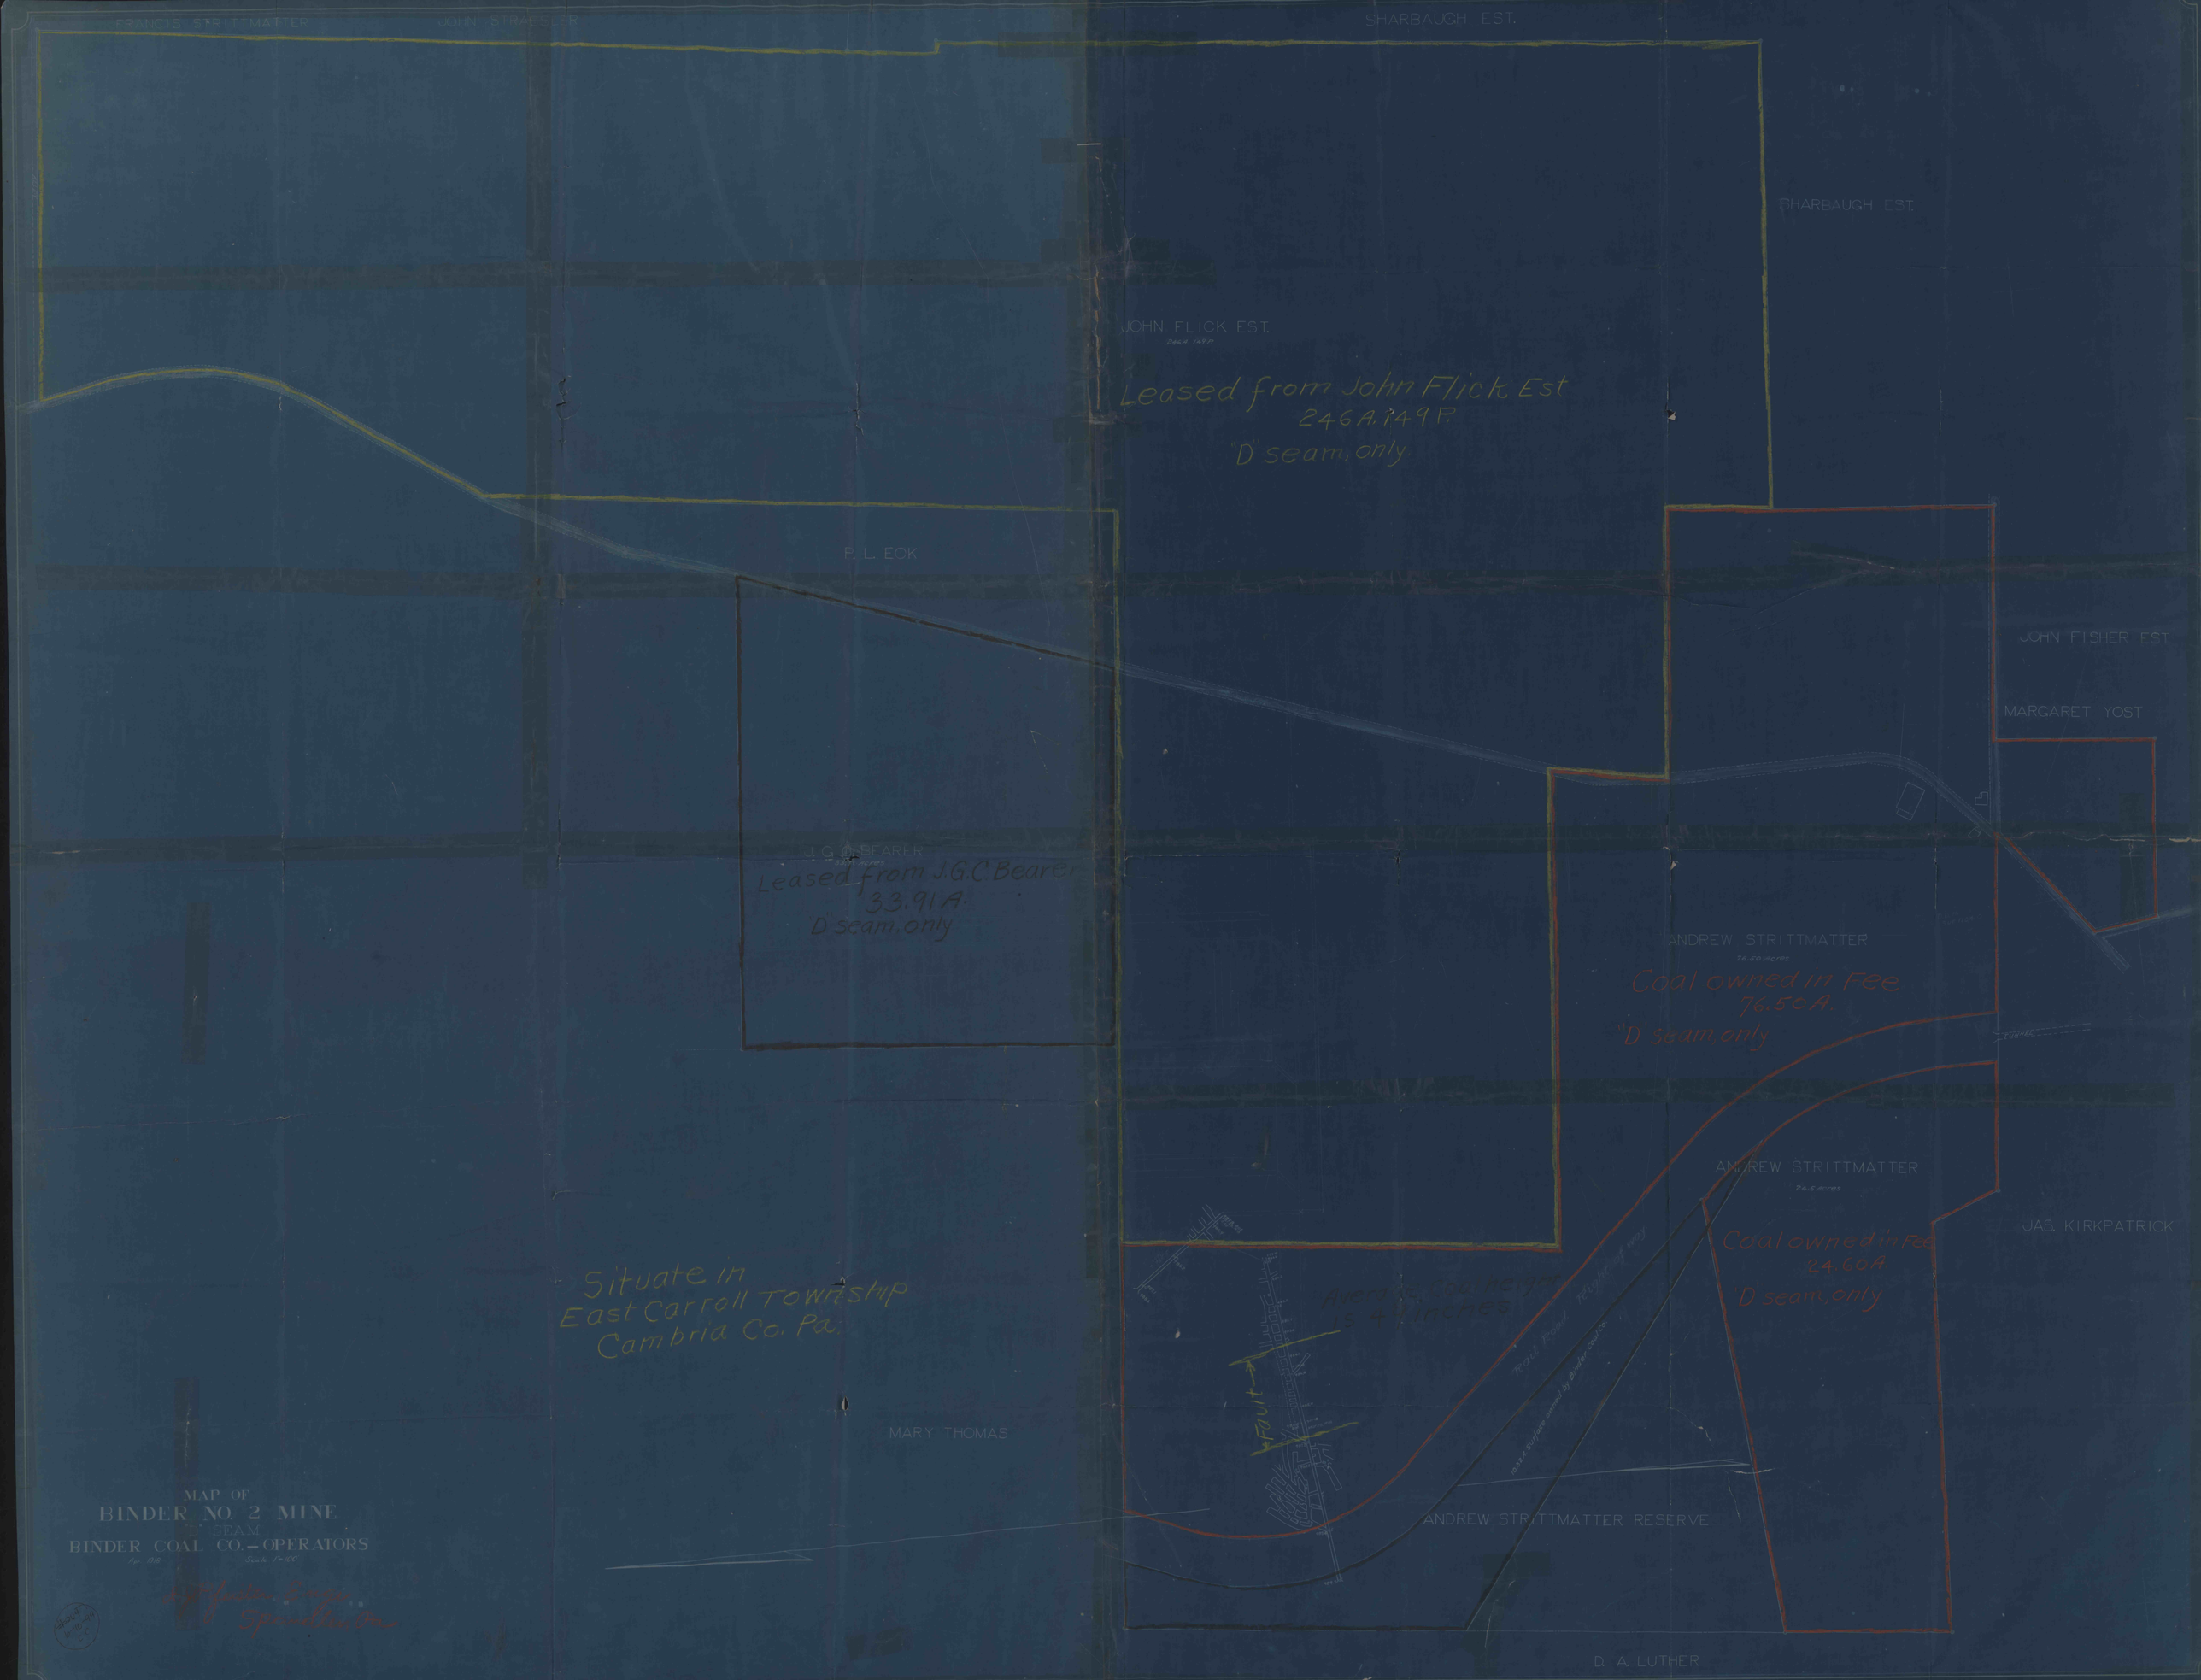
FRANCIS STRITTMATTER
JOHN STRASSLER
SHARBAUGH EST.
SHARBAUGH EST.
JOHN FLICK EST.
Leased from John Flick Est
246A. 149P.
"D" seam, only
P. L. EOK
JOHN FISHER EST
MARGARET YOST
J. G. C. BEARER
Leased from J.G.C. Bearer
33.91A.
"D" seam, only
ANDREW STRITTMATTER
Coal owned in Fee
76.50A.
"D" seam, only
ANDREW STRITTMATTER
Coal owned in Fee
24.60A.
"D" seam, only
JAS. KIRKPATRICK
Situate in
East Carroll Township
Cambria Co. Pa.
Average Coal height
is 4 inches
Fault
MARY THOMAS
ANDREW STRITTMATTER RESERVE
D. A. LUTHER
MAP OF
BINDER NO. 2 MINE
"D" SEAM
BINDER COAL CO. — OPERATORS