


STERLING COAL CO.

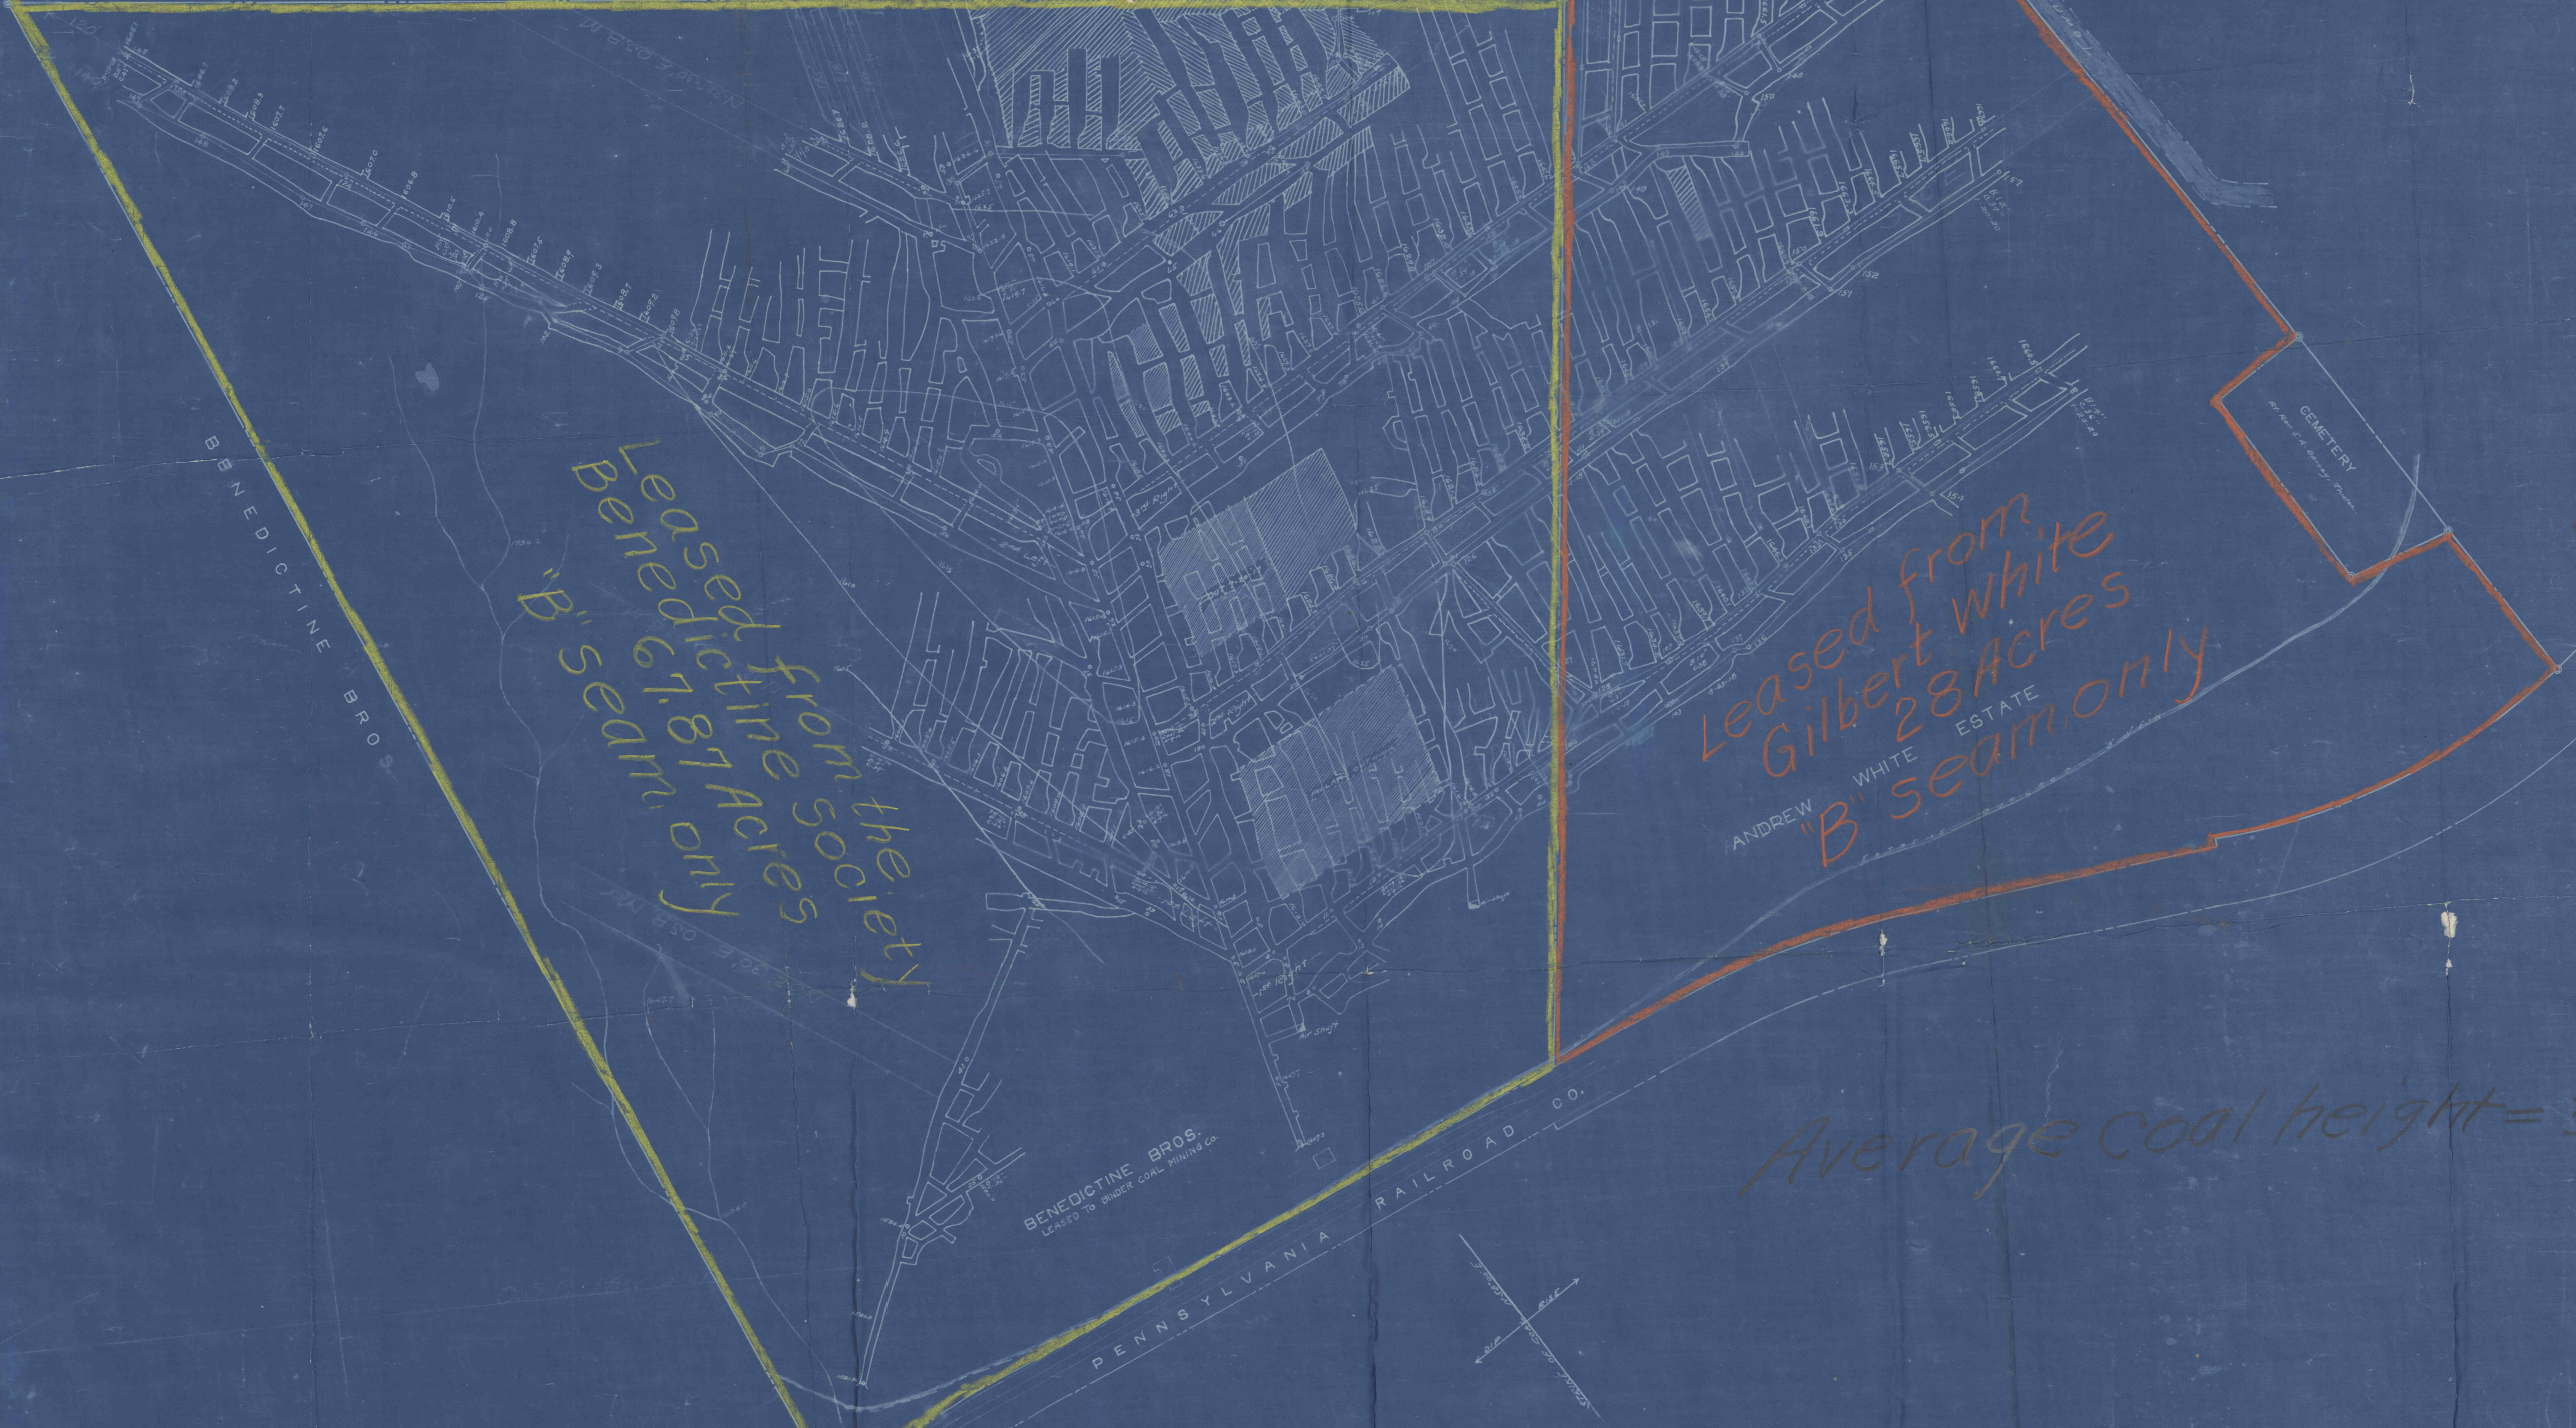

 "B" seam only

Leased from
 Gilbert White
 28 Acres
 ANDREW WHITE ESTATE
 "B" seam only

Average coal height = 37"

Situate in
 West Carroll Township
 Cambria Co., Pa.

MAP
 OF
 BINDER COAL CO.'S
 MINE No. 1
 NEAR
 BAKERTON, PA.
 SCALE 1"=100'

Spangler & Sons
 Engineers
 "B" seam

#245
 6-10-97
 C.C.