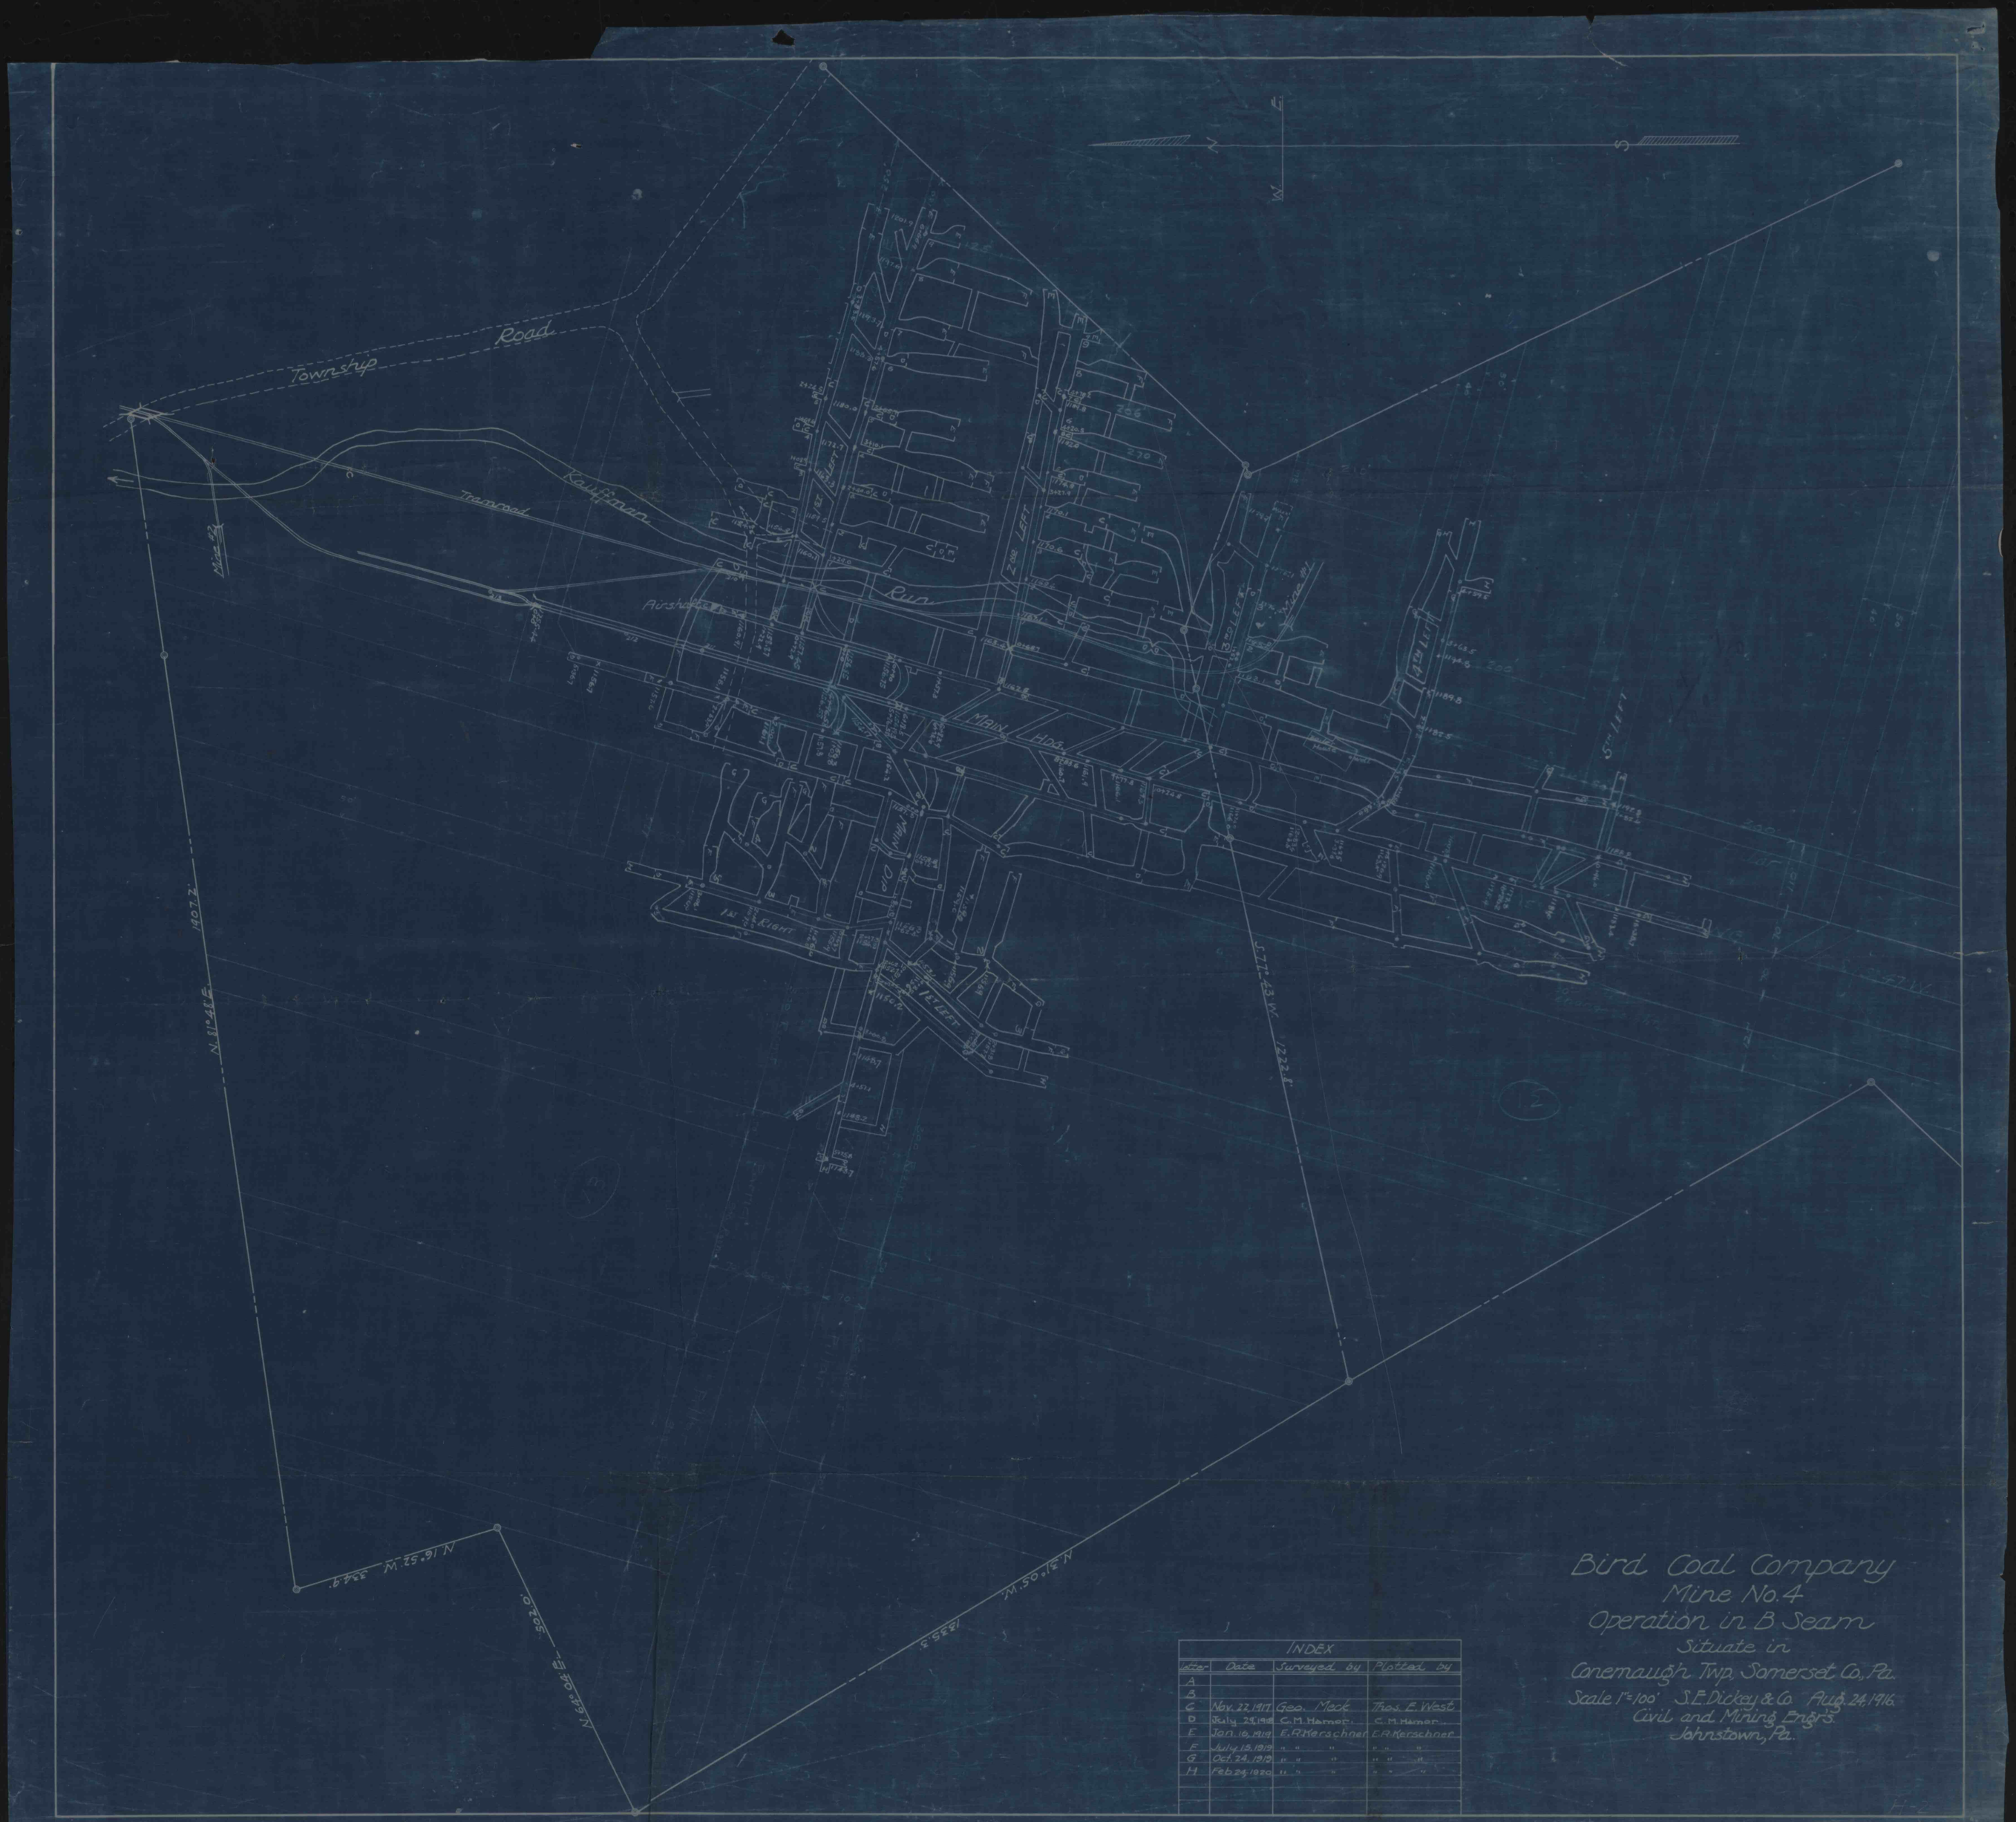


INDEX

| Letter | Date | Surveyed by | Plotted by |
|---|---|---|---|
| A | | | |
| B | | | |
| C | Nov. 27, 1917 | Geo. Mack | Thos. E. West |
| D | July 29, 1918 | C. M. Hamer | C. M. Hamer |
| E | Jan. 16, 1919 | E. R. Kerschner | E. R. Kerschner |
| F | July 15, 1919 | " " | " " |
| G | Oct. 24, 1919 | " " | " " |
| H | Feb. 24, 1920 | " " | " " |

# Bird Coal Company
## Mine No. 4
## Operation in B Seam
Situate in
Conemaugh Twp, Somerset Co, Pa.
Scale 1" = 100' S. E. Dickey & Co Aug. 24, 1916.
Civil and Mining Engrs.
Johnstown, Pa.