


TANDOM COAL COMPANY
BLACK BEAUTY NO.1 MINE
YOUNG TWP., INDIANA CO., PA.

SURVEYED OCT. 5, 1963 BY H. BASH

SCALE: 1" = 100'

REVISED 7-6-65
9-26-66
3-18-67
12-8-67

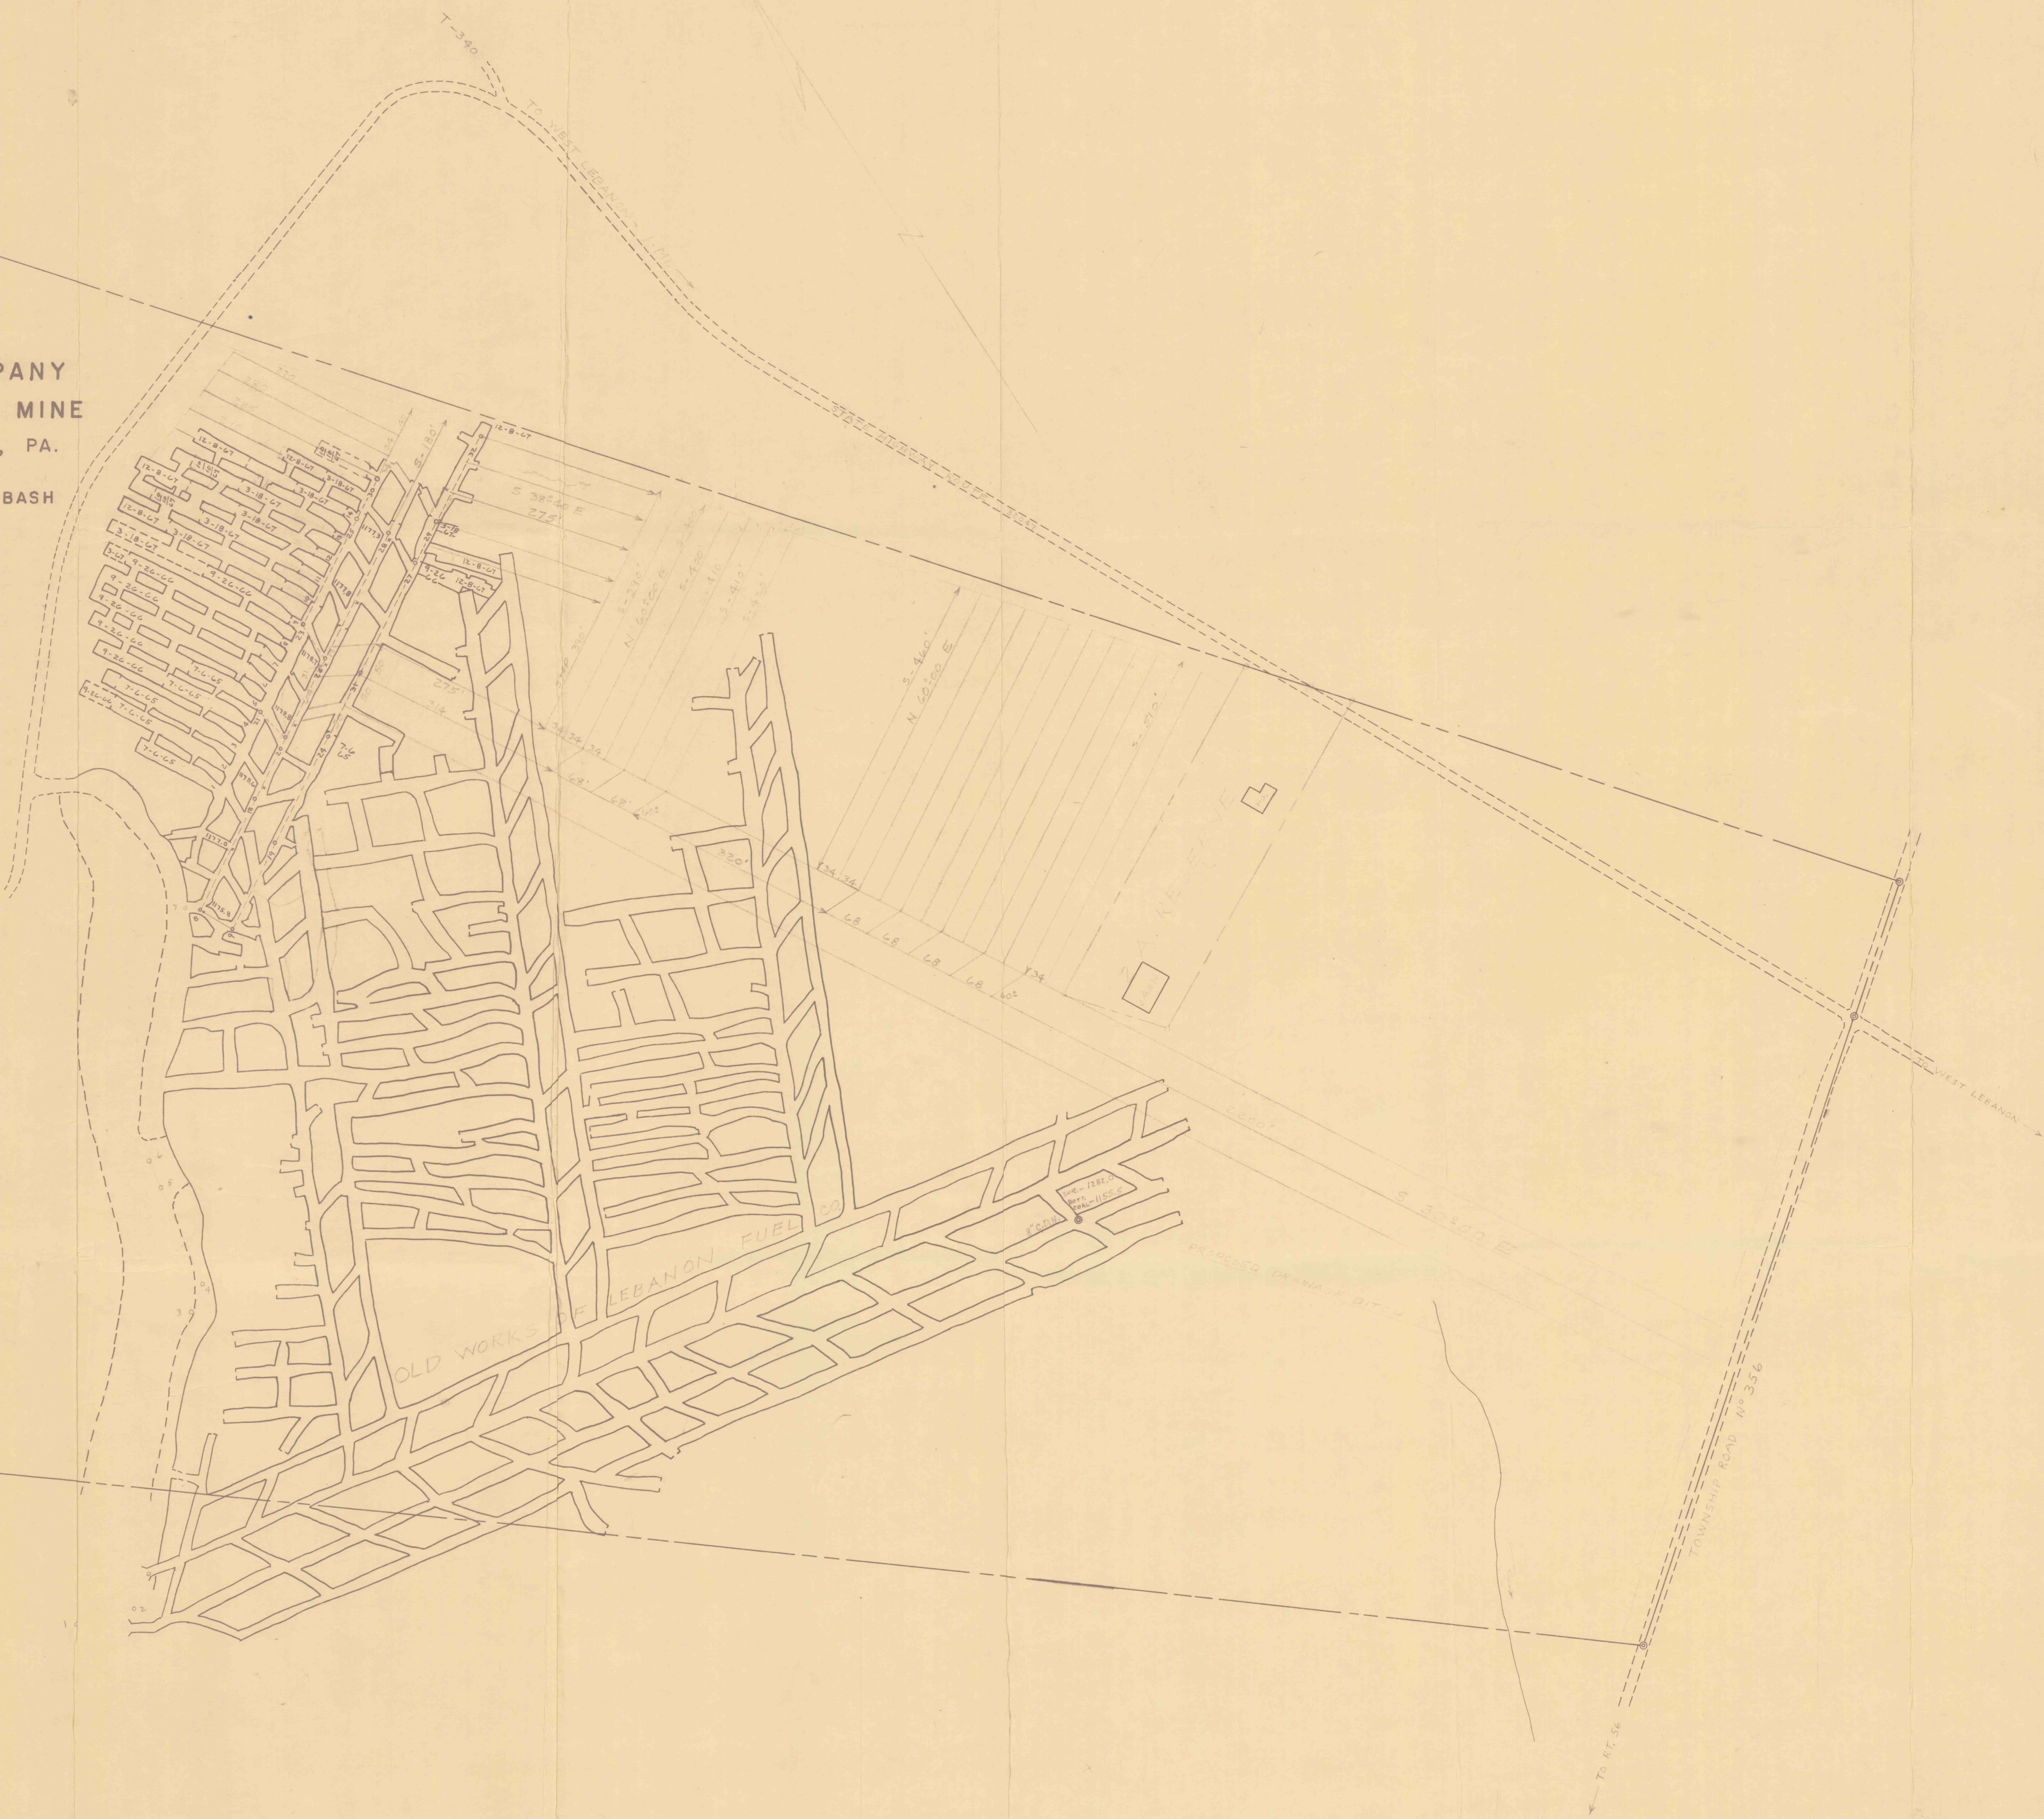

#270
6-11-99
C.C.