

#277
6-11-99
cc.

TRAY FIELD ENV.

TANDOM COAL COMPANY
BLACK BEAUTY NO.1 MINE
YOUNG TWP., INDIANA CO., PA.
(PITTSBURGH SEAM)


SURVEYED OCT. 5, 1963 BY H. BASH
SCALE: 1" = 100'

- REVISED 7-2-65
- 9-26-66
- 3-18-67
- 12-8-67
- 4-11-68
- 10-2-68
- 2-11-69

Graft Engineering Co
Blairsville Pa

- Mining - April 11, 1963 to October 11, 1963
- Supported Area
- Mining Completed
- Reserve

Survey Date April 11, 1963

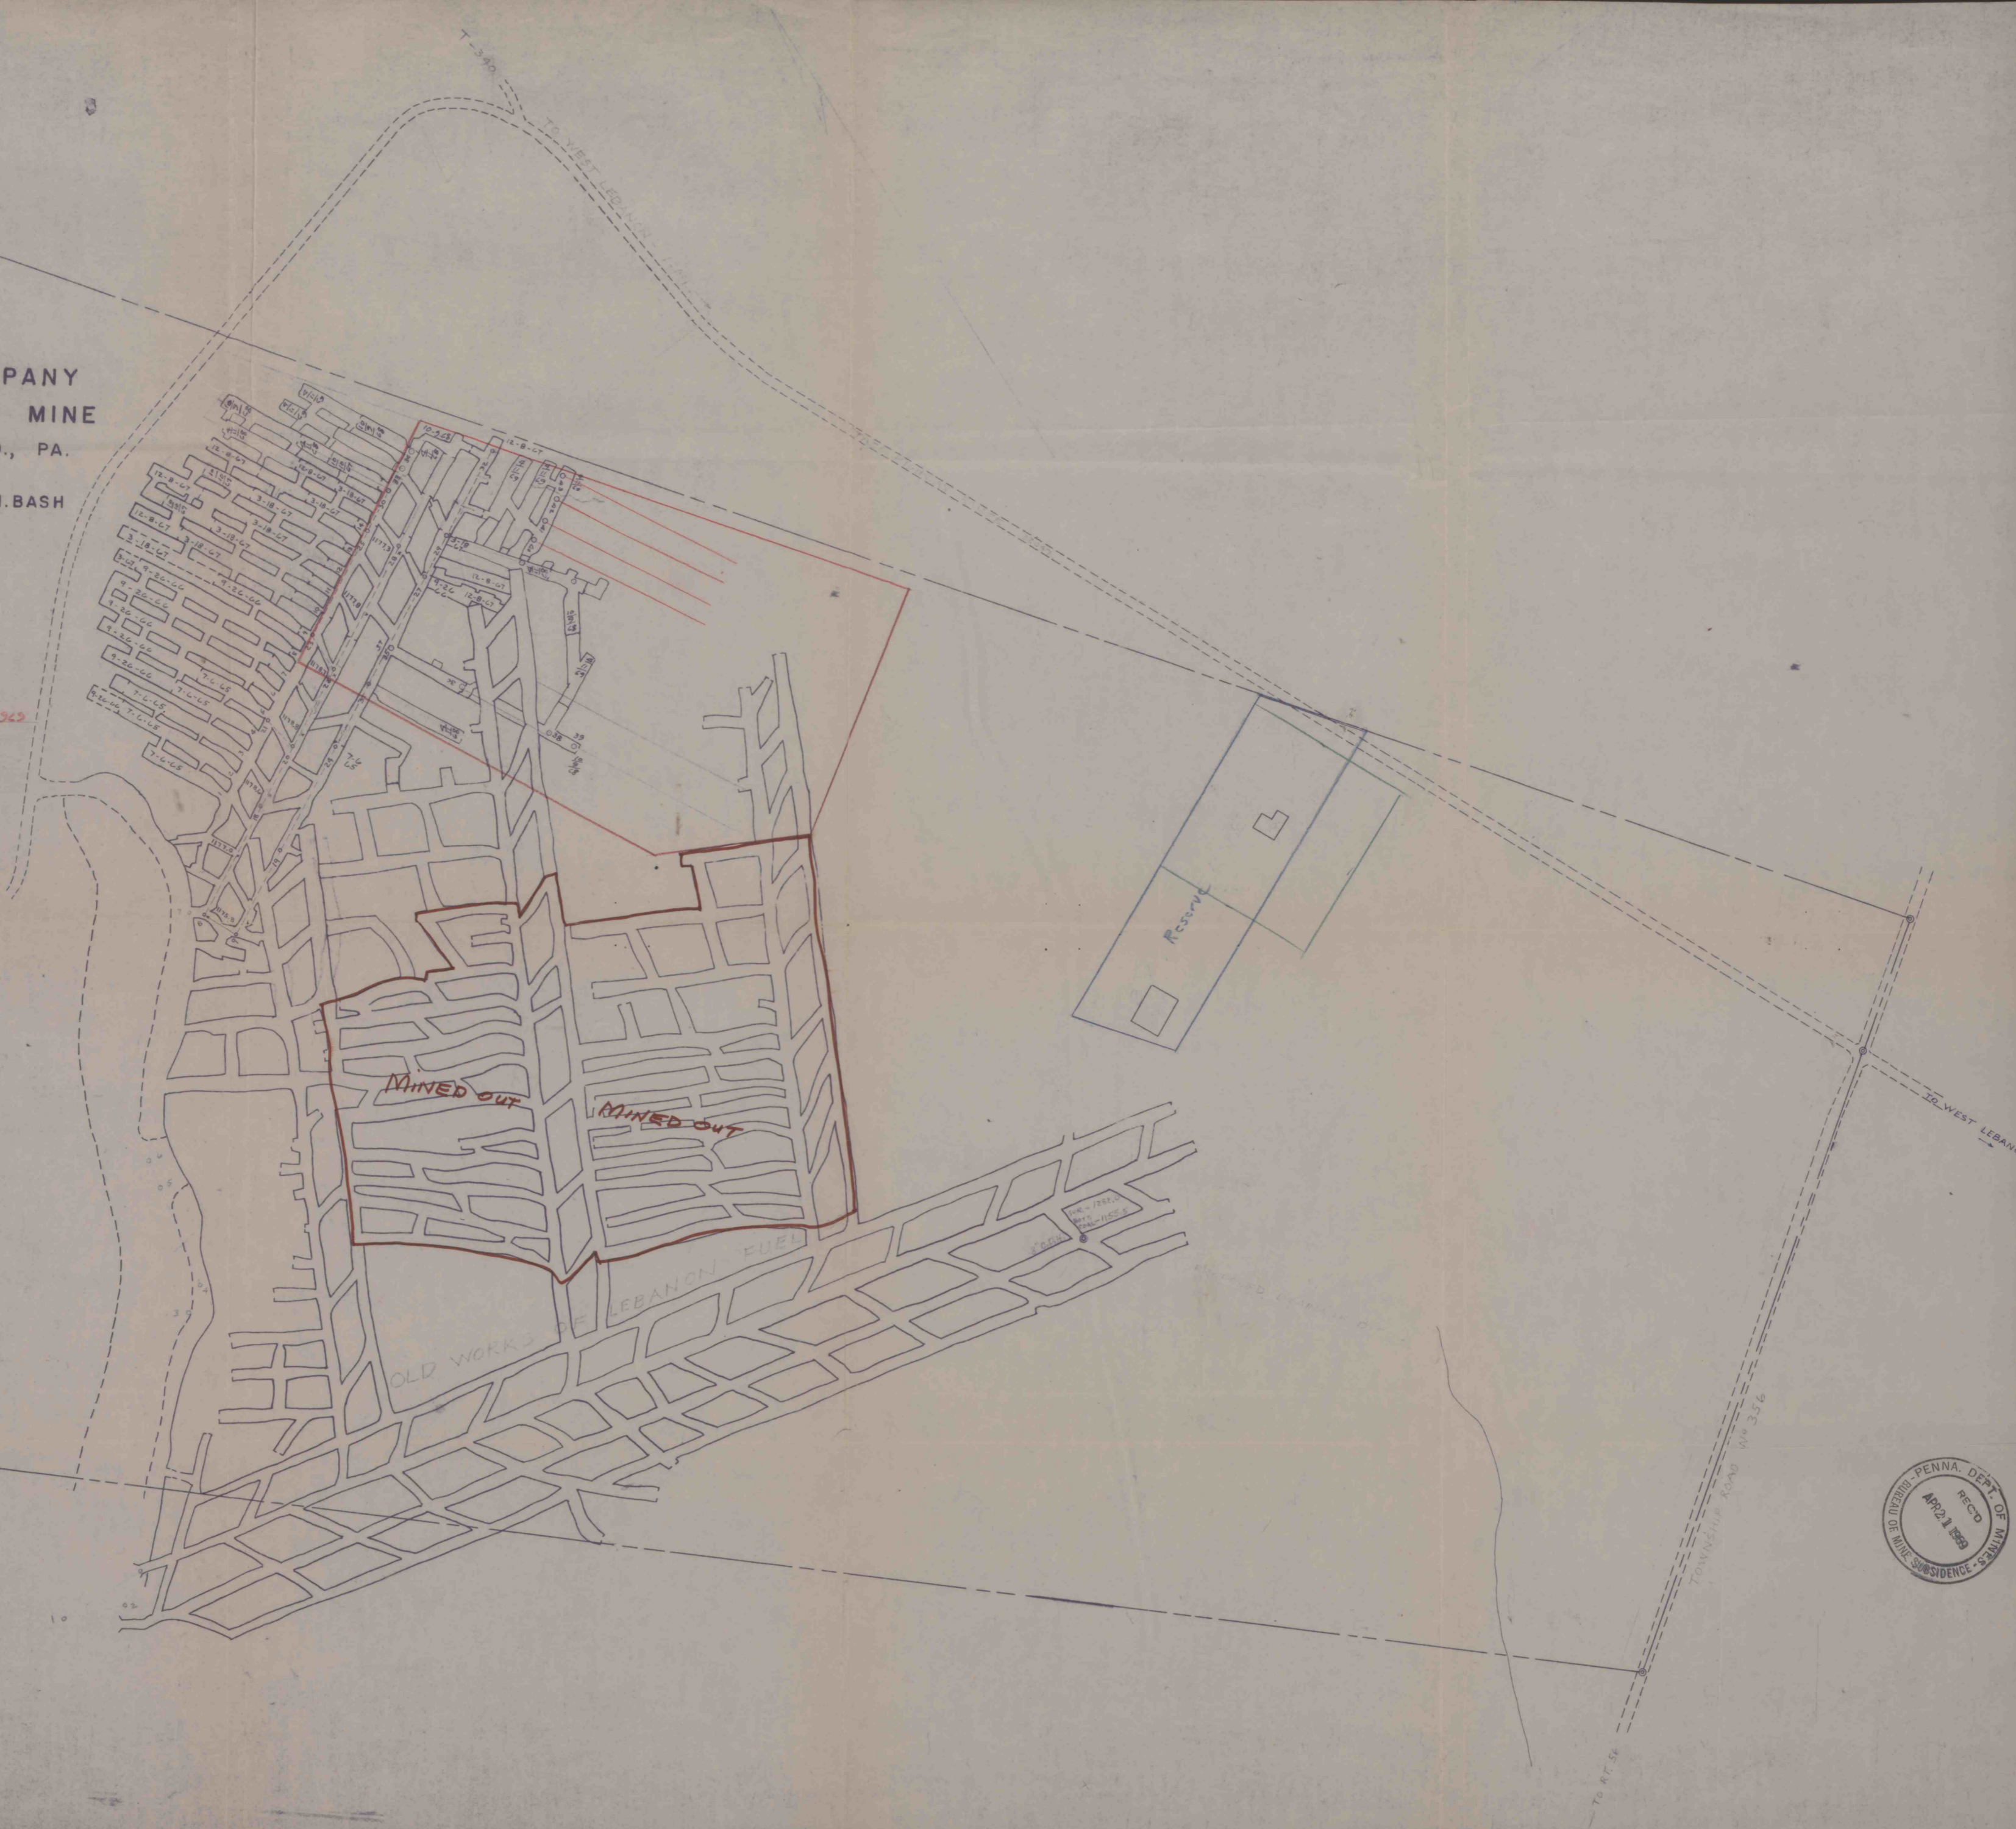

PENNA. DEPT. OF MINES & REVENUE
RECORDED
APR 21 1969
DEPT. OF MINE SUBSIDENCE & REVENUE