


A.S. 20  
 S. 10  
 W. 10  
 L.B. 10  
 Q. 10  
 M. 10

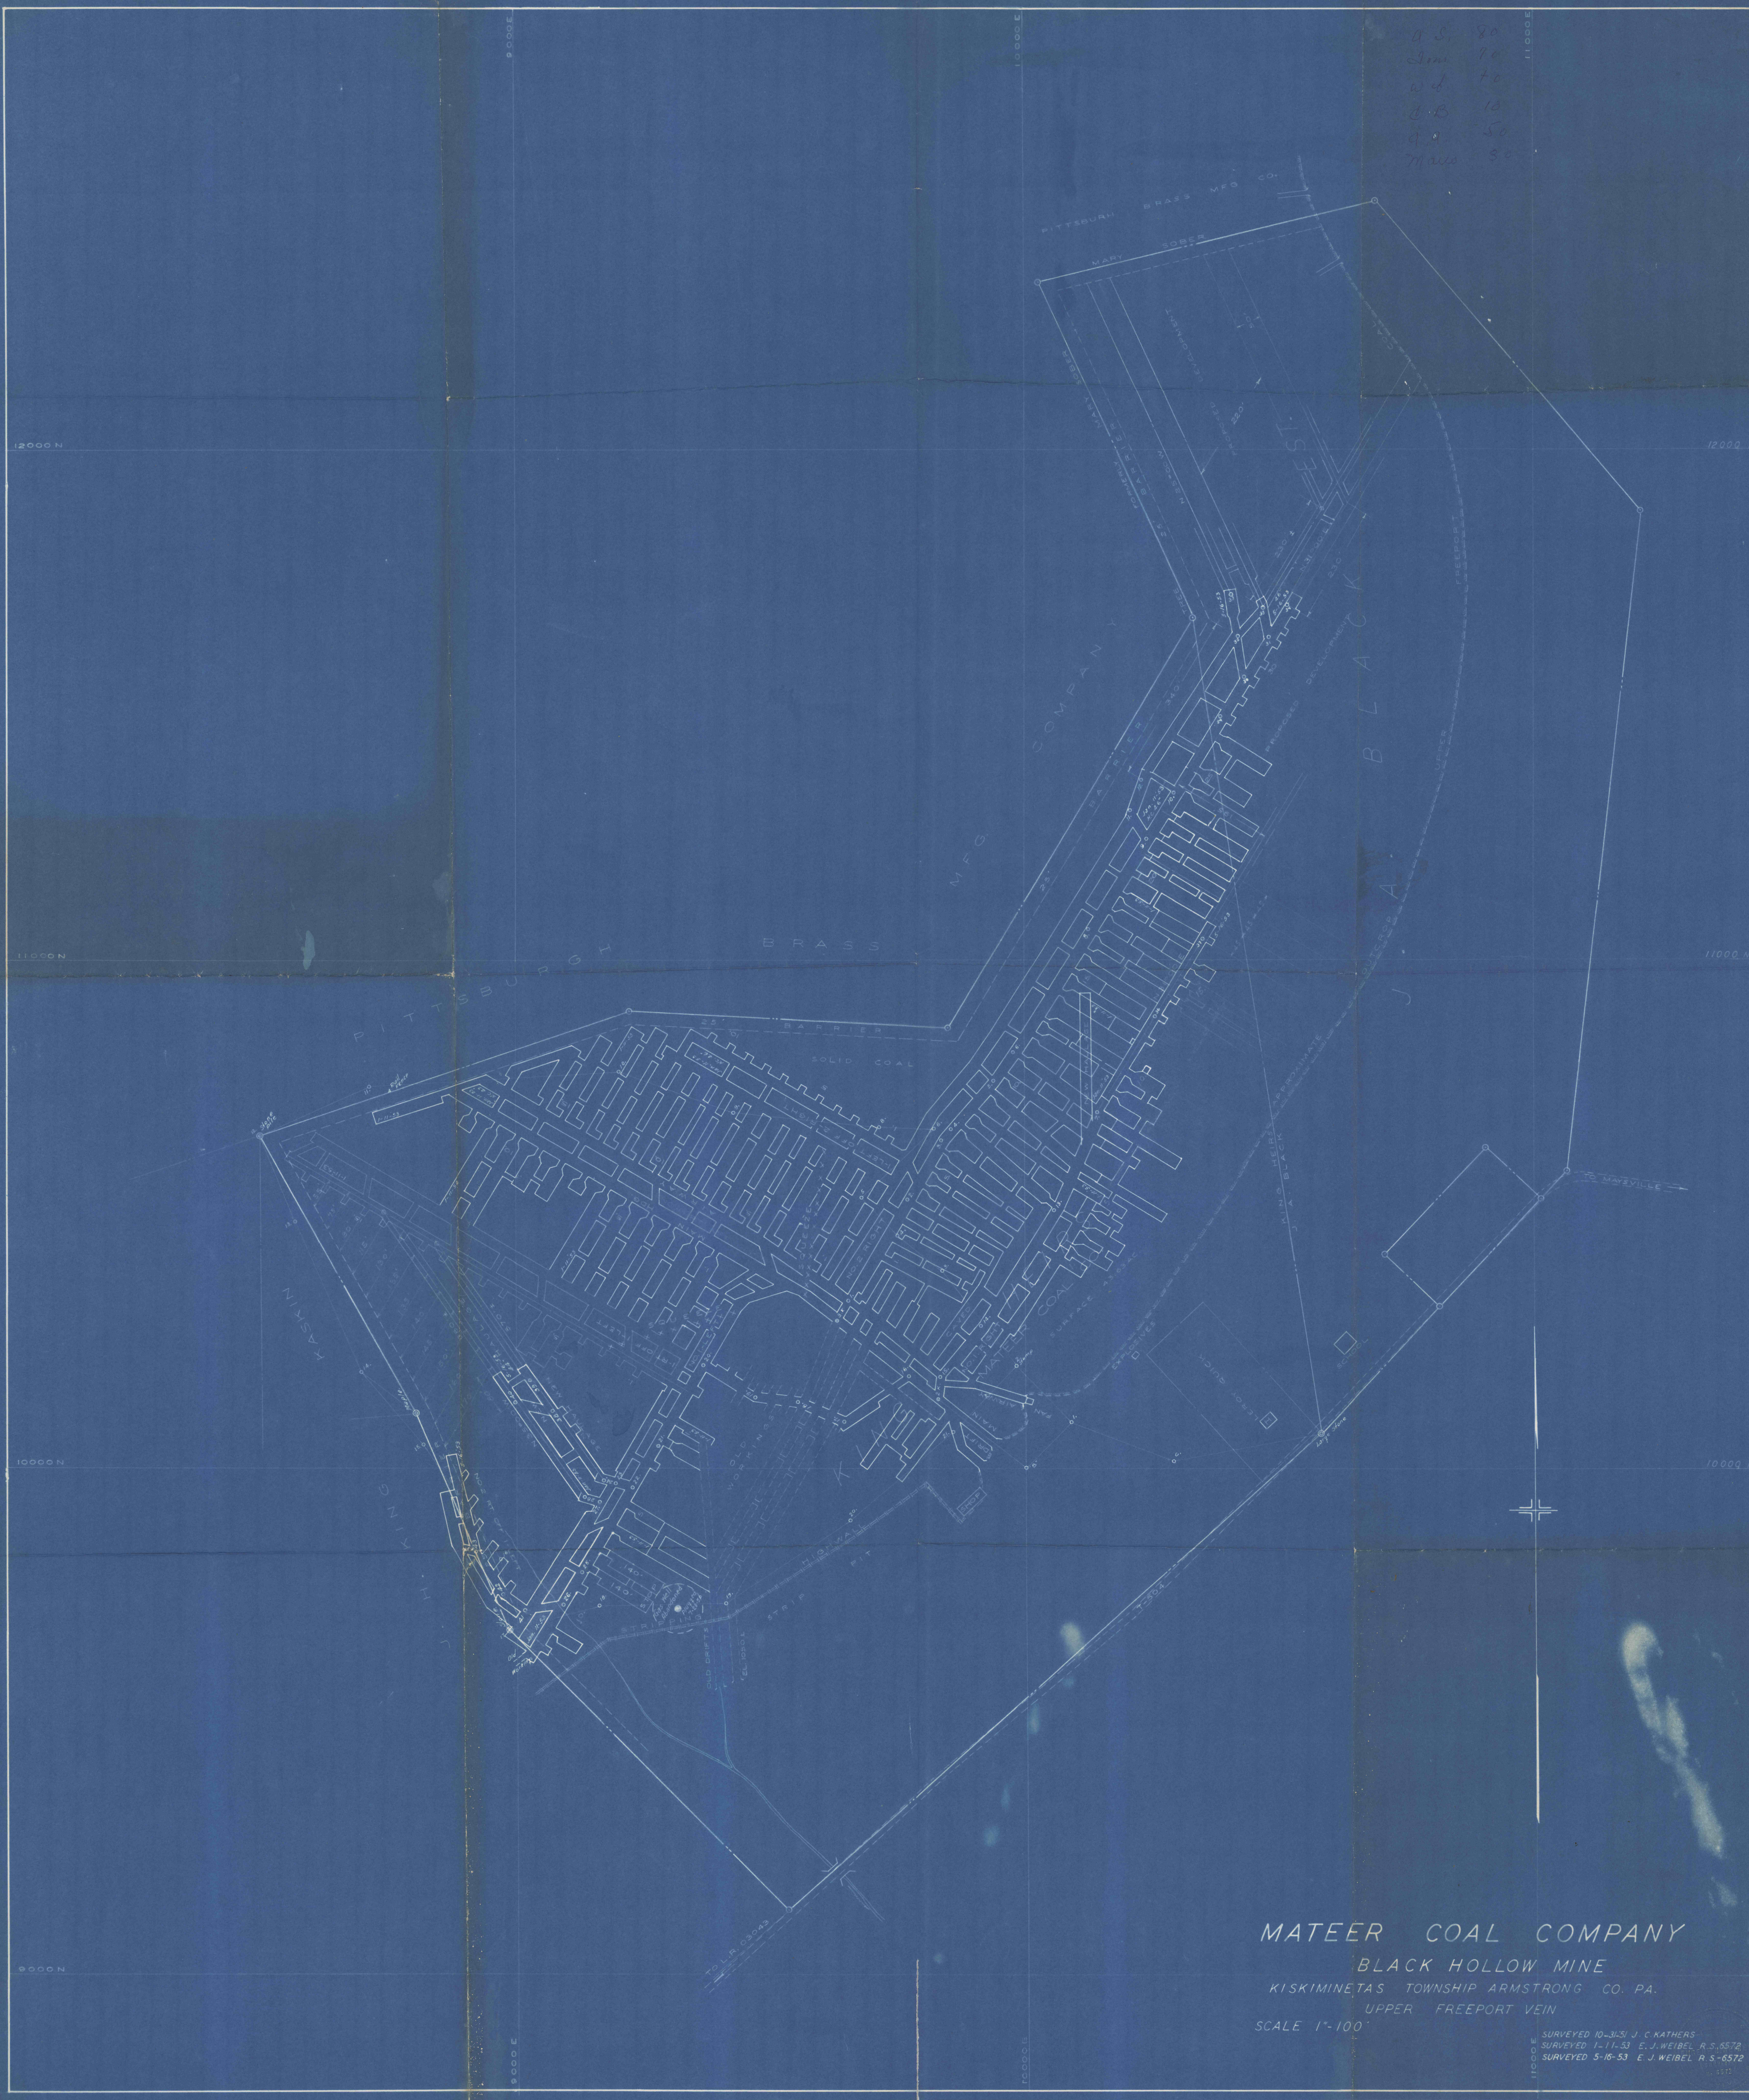

**MATEER COAL COMPANY**  
**BLACK HOLLOW MINE**  
 KISKIMINETAS TOWNSHIP ARMSTRONG CO. PA.  
 UPPER FREEPORT VEIN  
 SCALE 1"=100'

SURVEYED 10-31-51 J. C. KATHERS  
 SURVEYED 1-11-53 E. J. WEIBEL R.S.-6572  
 SURVEYED 5-16-53 E. J. WEIBEL R.S.-6572