

MINE MAP of the GRAFF COAL CO., BLACKLICK PA.

Scale 1 inch = 100 Feet

Albert Smith
Engineer



Surveys
Nov 1 1899
To
Feb 6 1902

ISSUED

Oct 20 1903

ISSUED


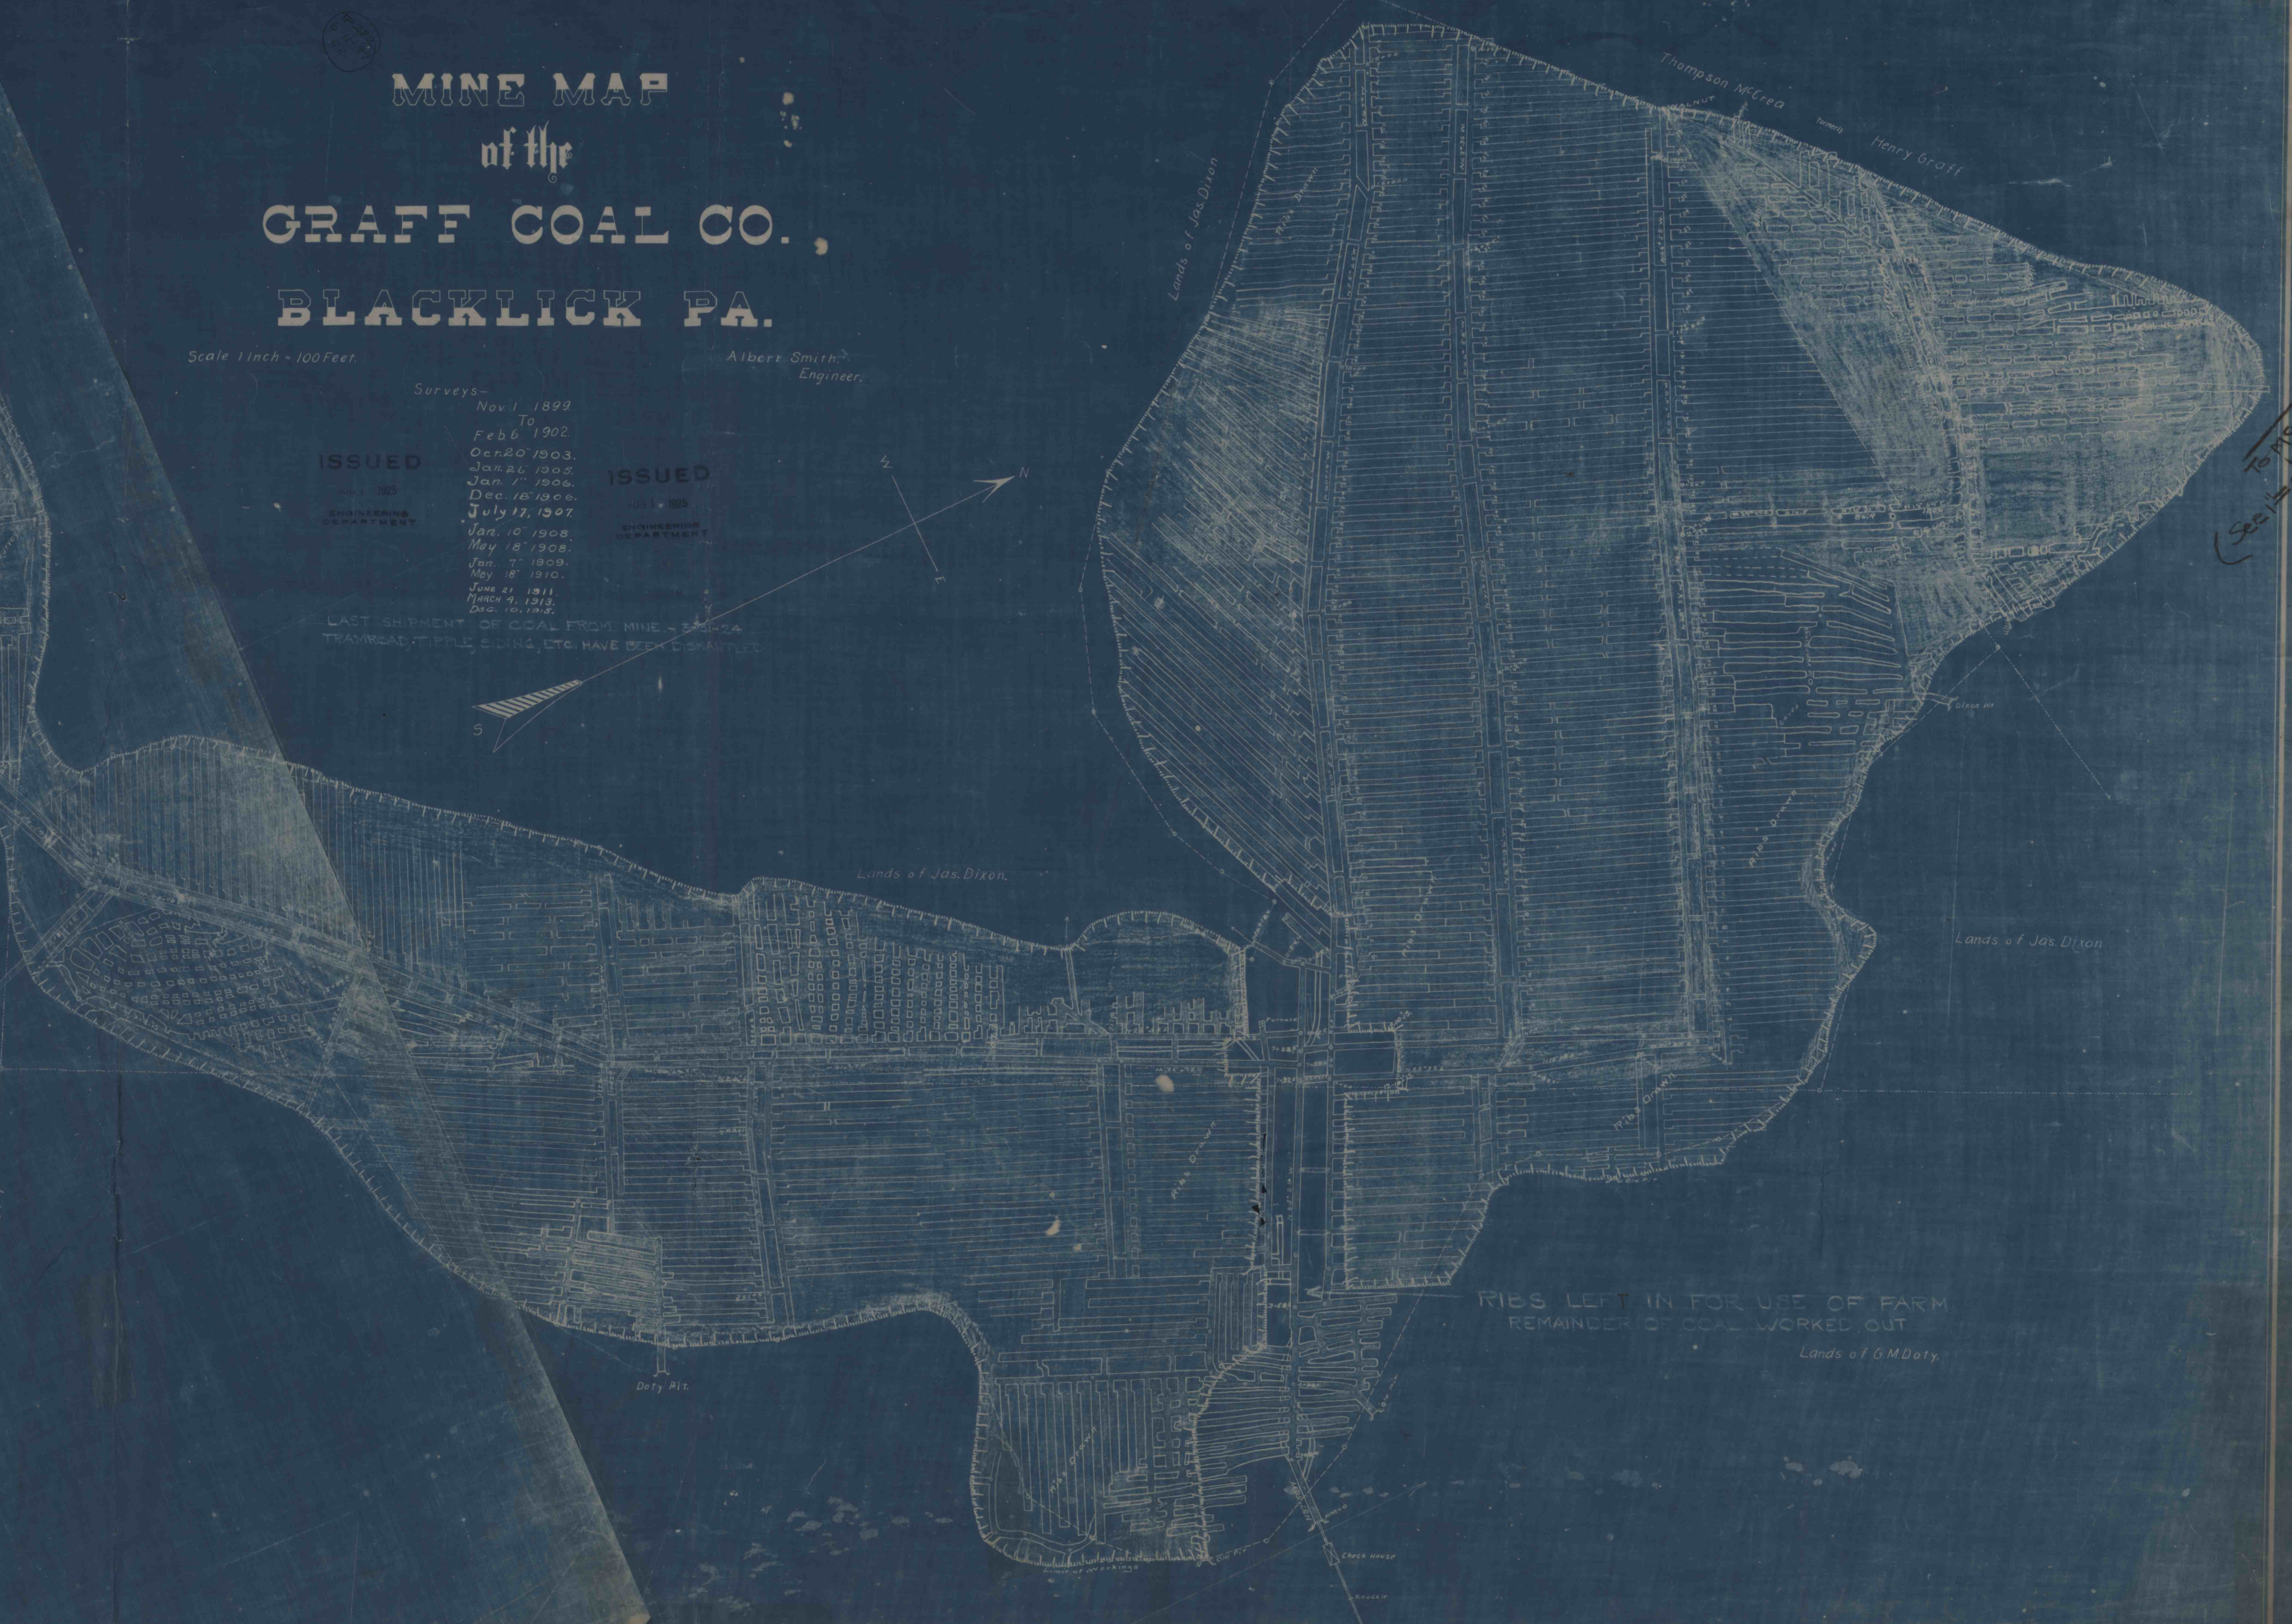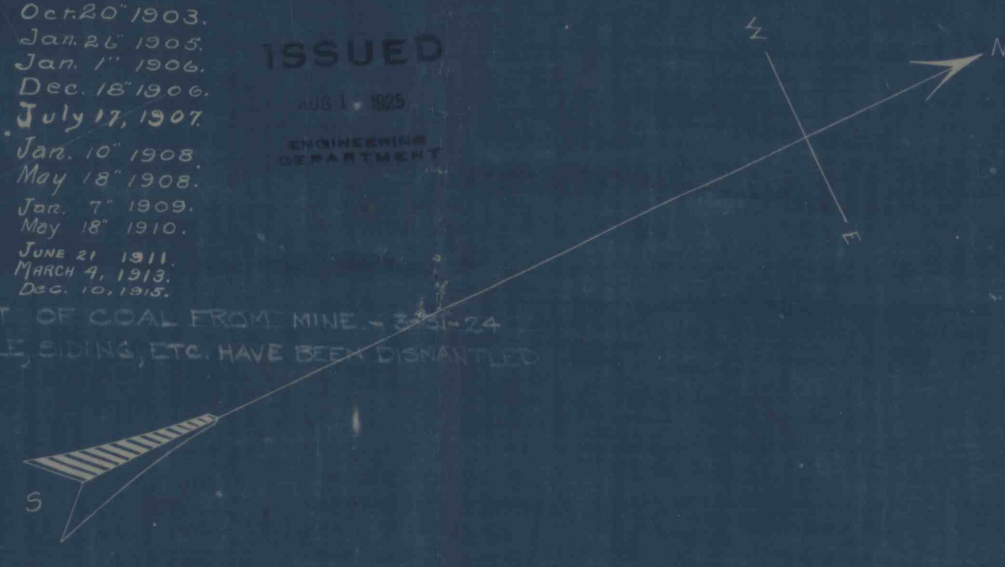

RIBS LEFT IN FOR USE OF FARM
REMAINDER OF COAL WORKED OUT
Lands of G.M. Doty

Scale 1 inch = 100 Feet