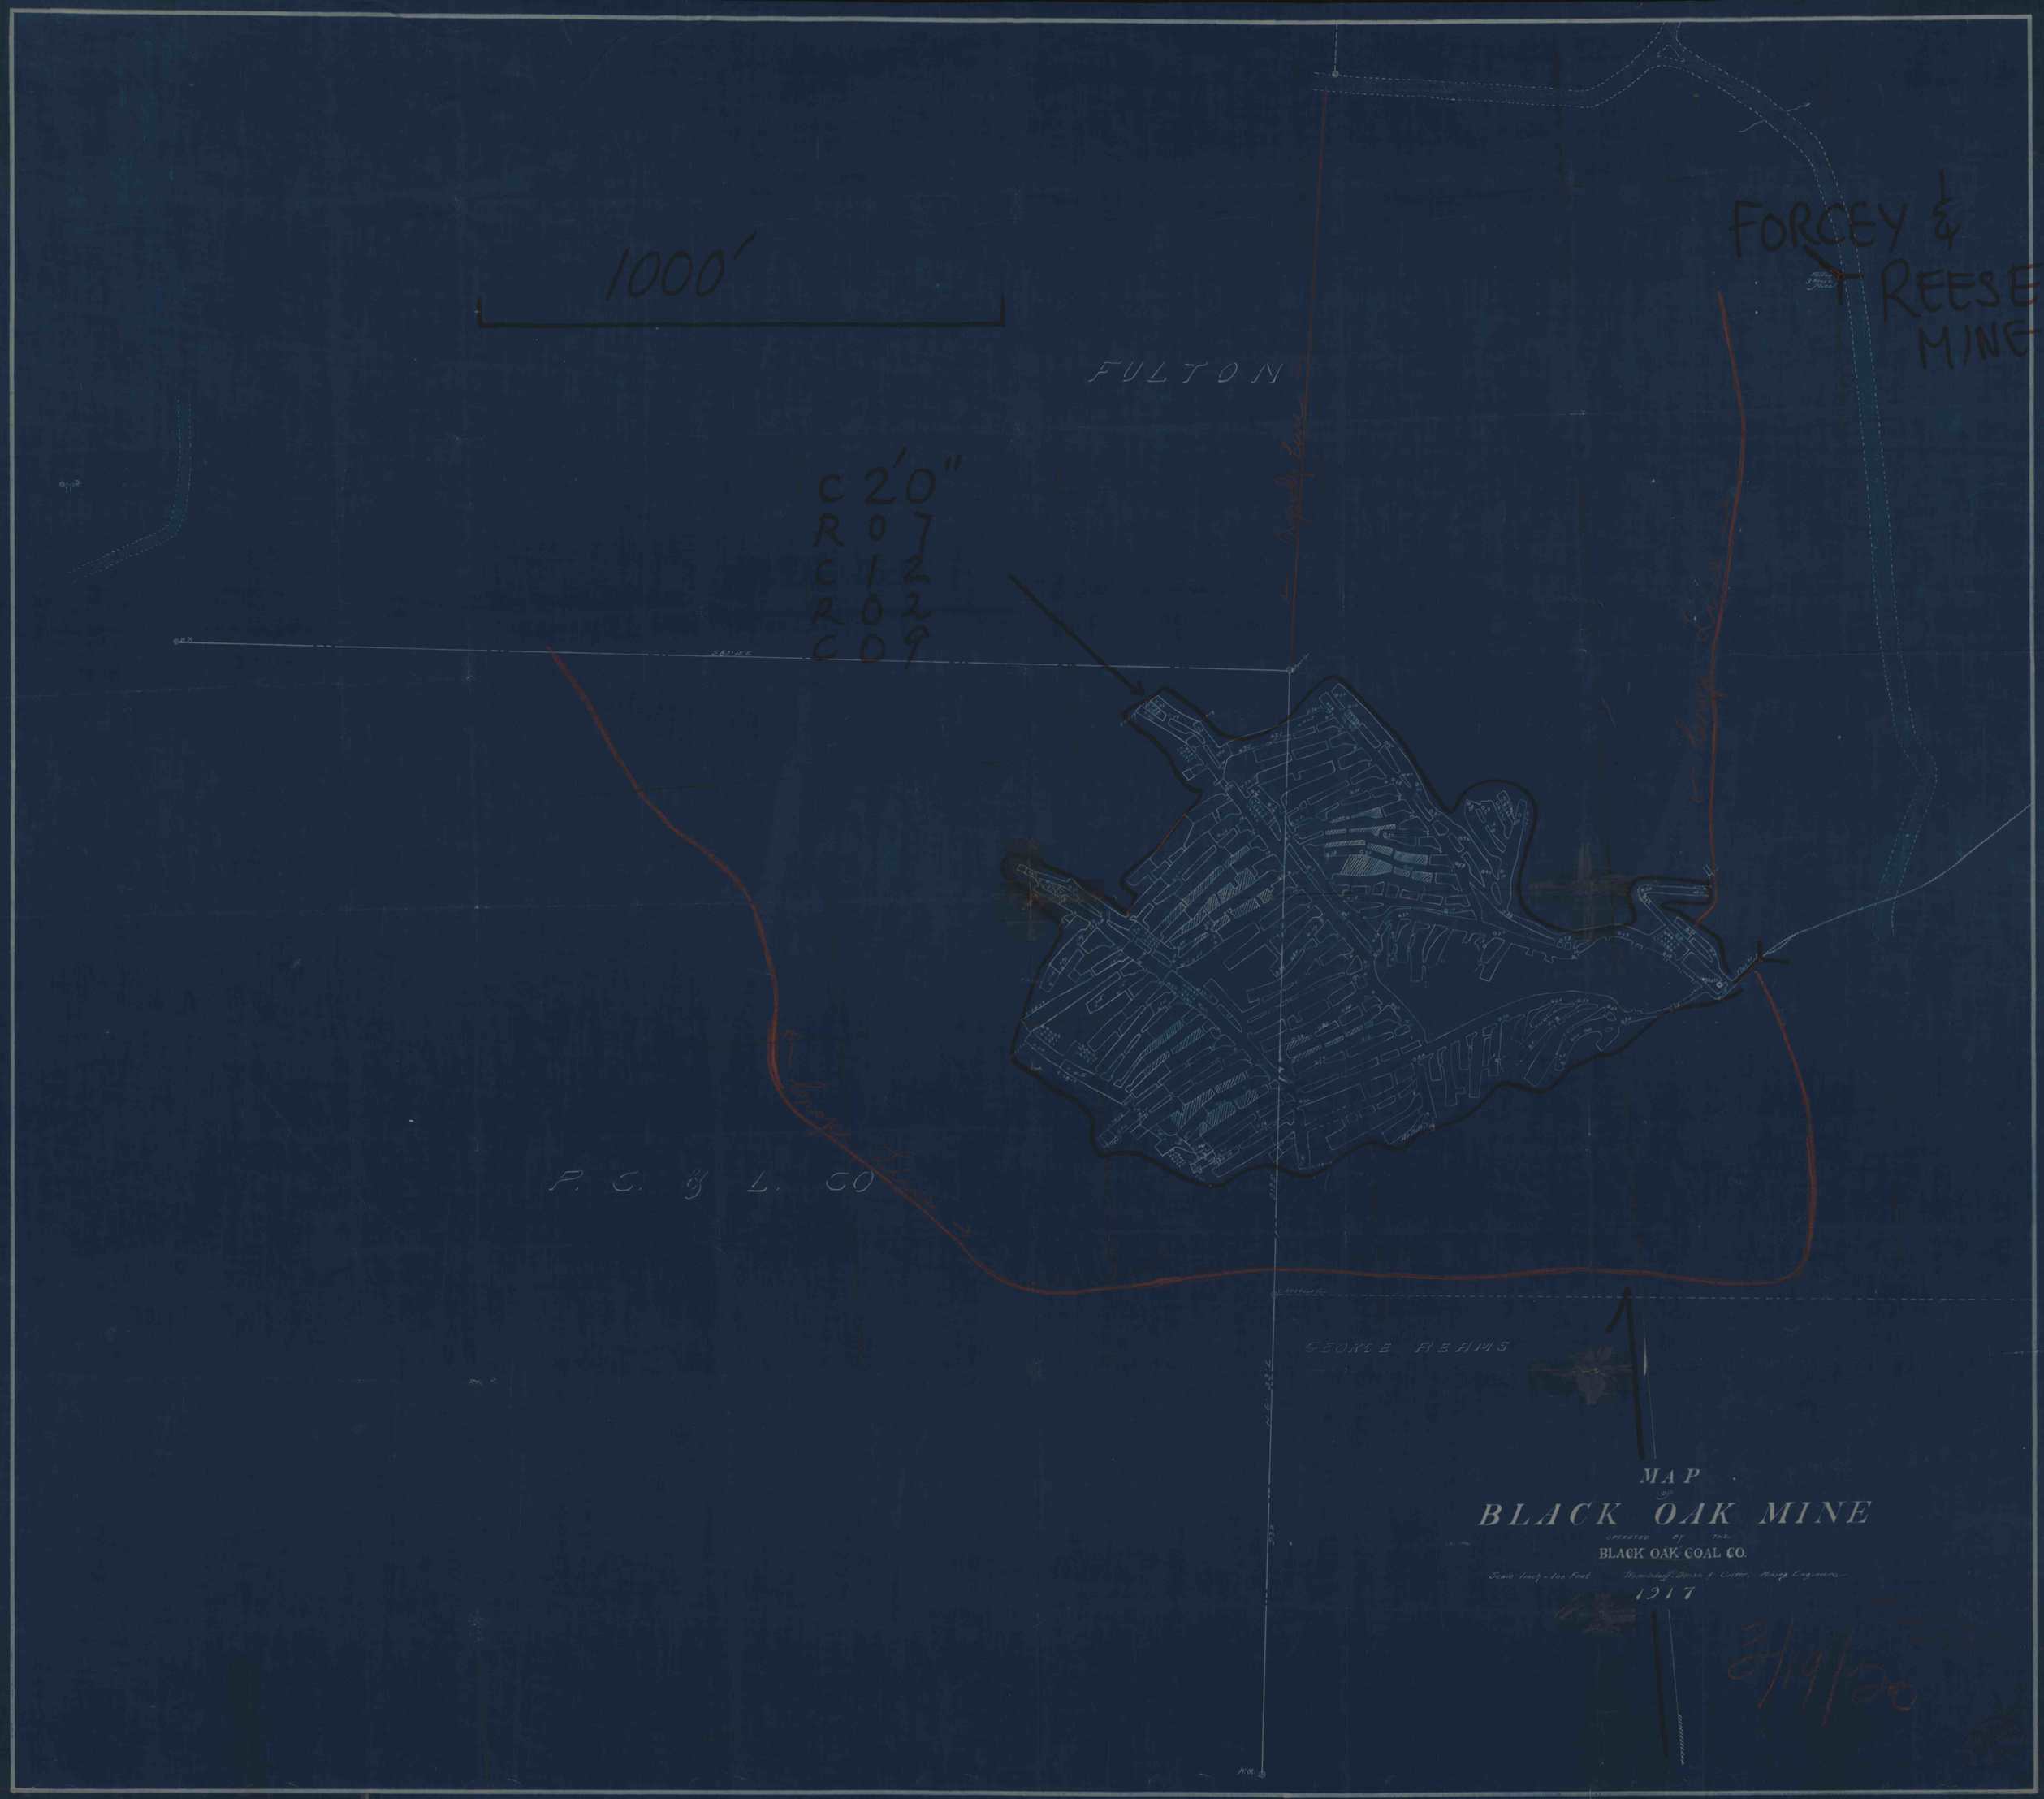
1000'
FULTON
FORCEY & REESE MINE
C 2'0"
R 0 7
C 1 2
R 0 2
C 0 9
P. C. & L. CO
GEORGE REAMS
MAP
BLACK OAK MINE
OPERATED BY THE
BLACK OAK COAL CO.
Scale 1 inch = 100 Feet
Womeldorff, Dunkle & Custer, Mining Engineers
1917
3/14/20