


BLAINE MINE
FORWARD DIVISION - ALLEGHENY CO. - PA.
DIAMOND COAL & COKE COMPANY

SCALE 1"=100'
GEO. S. BARNES & COMPANY
CIVIL AND MINING ENGINEERS
PITTSBURGH, PA.

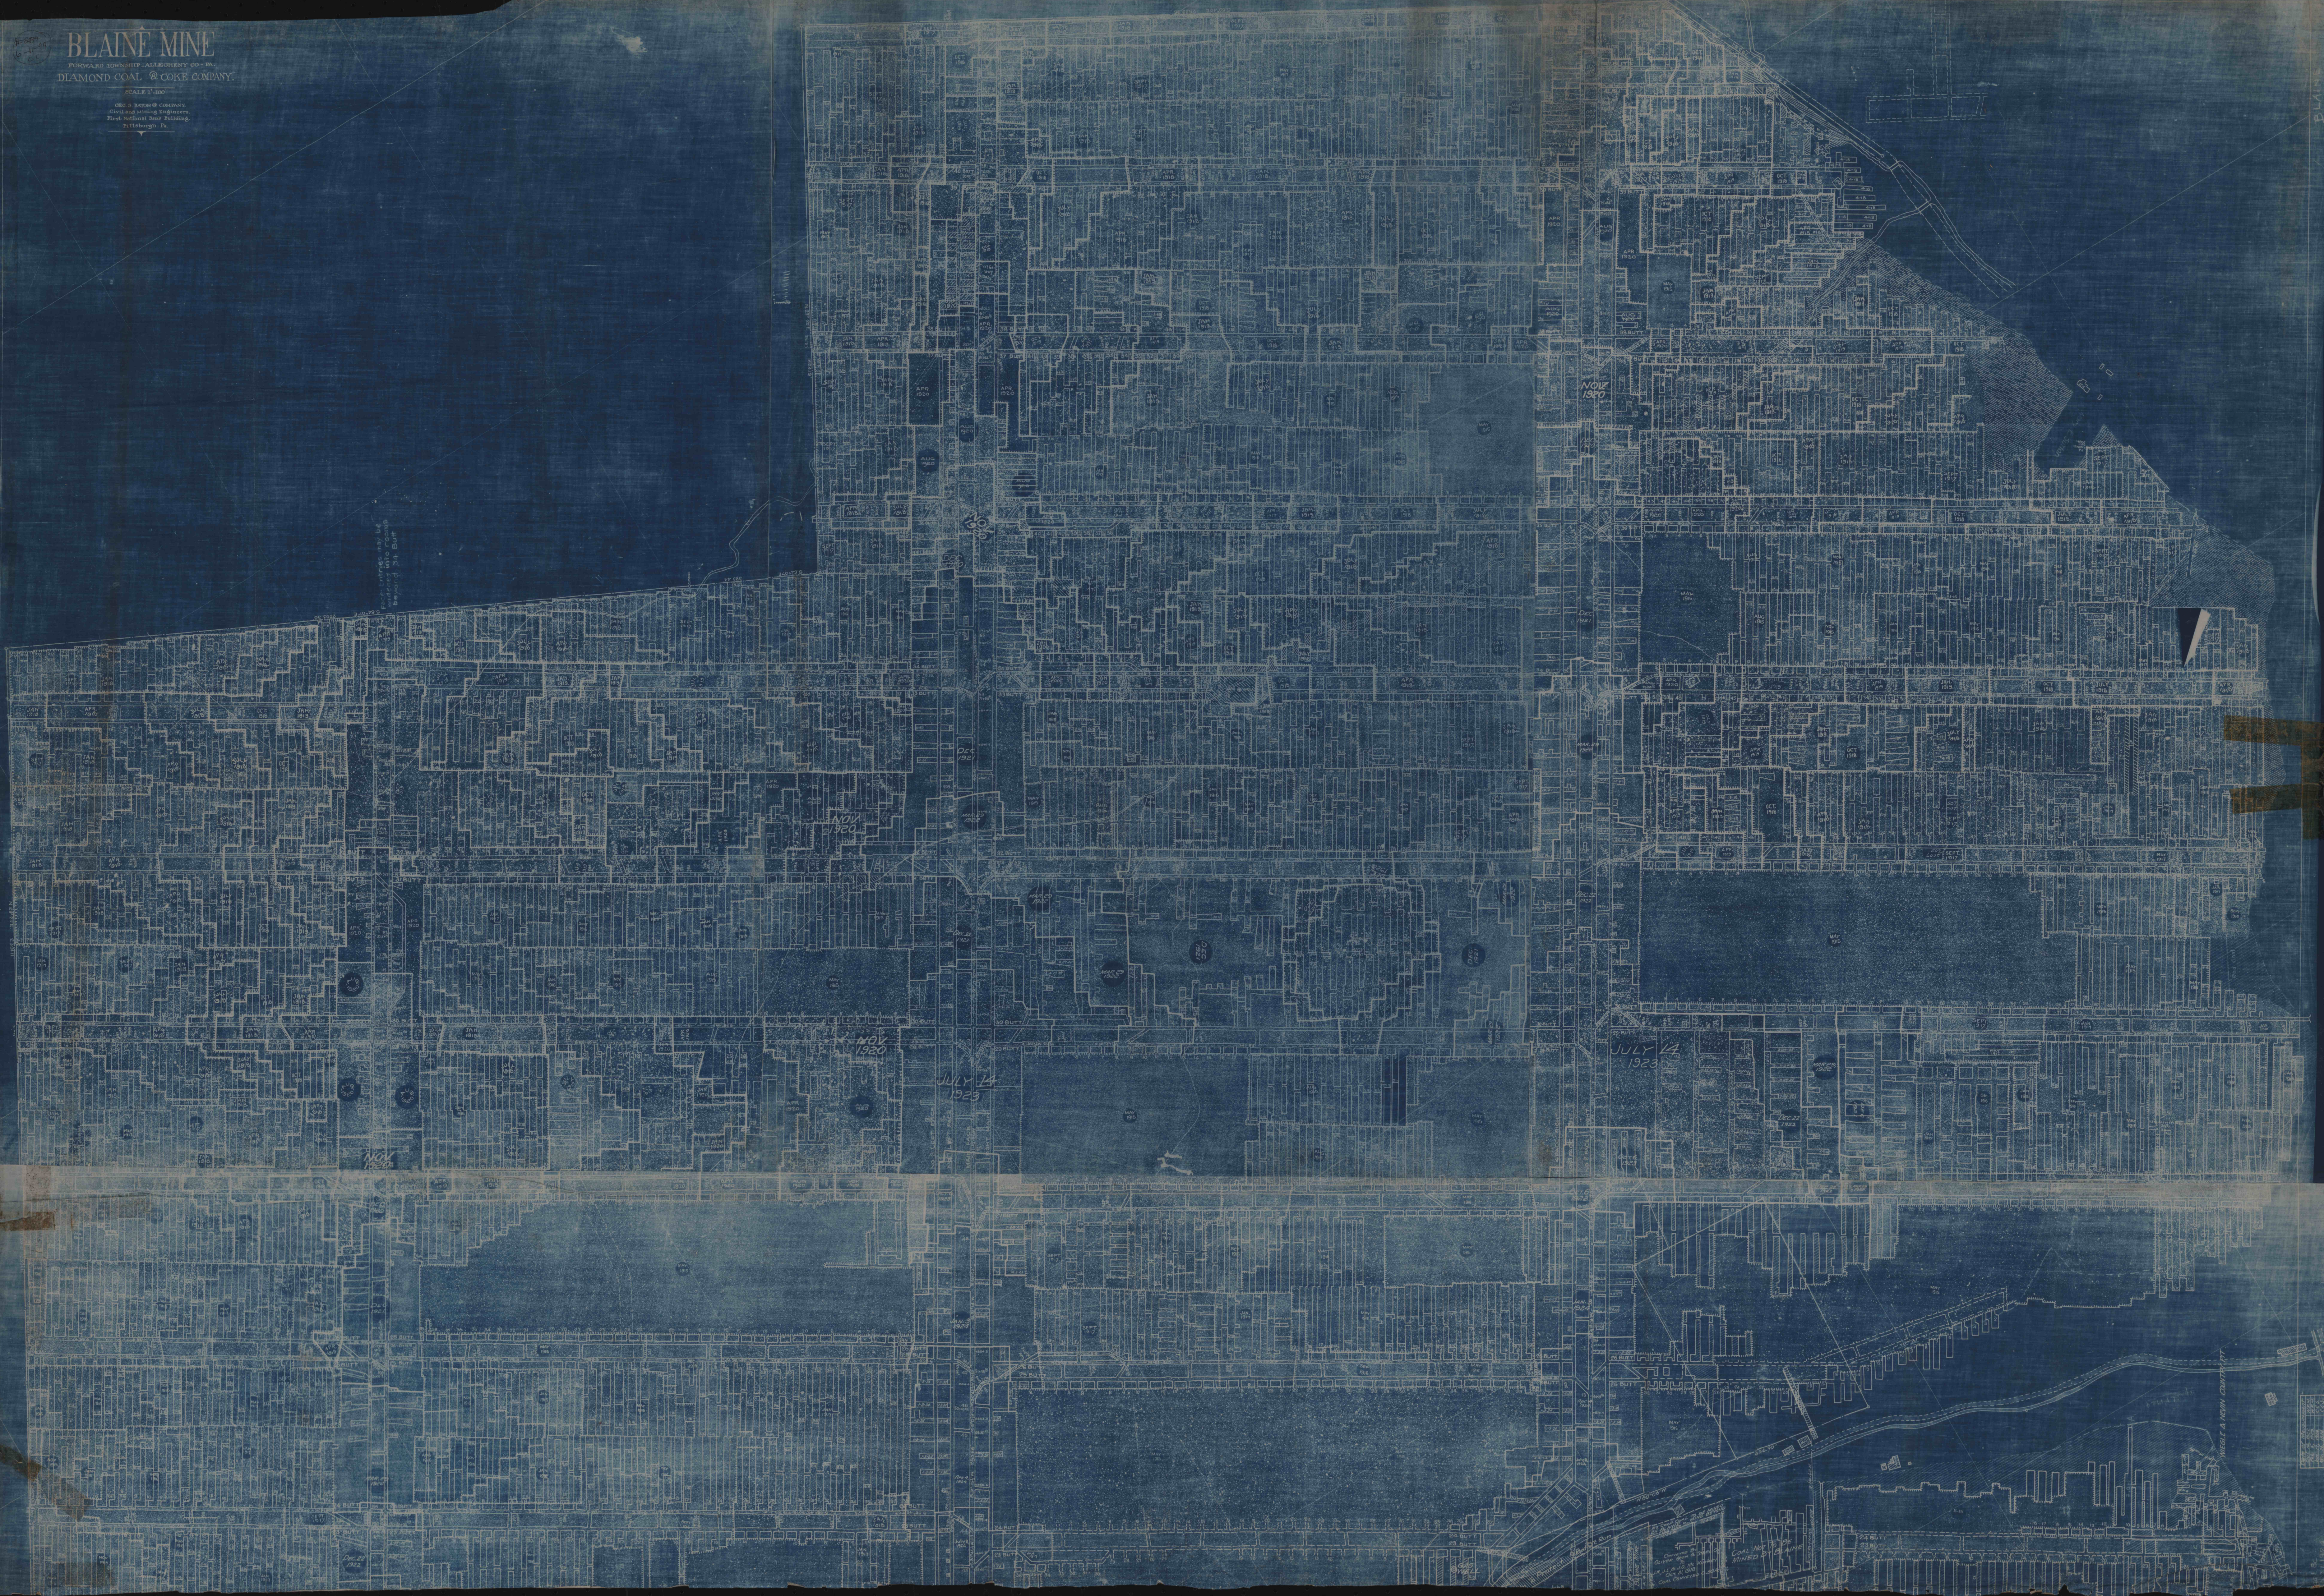

See outside map for
bearing of this mine

NOV
1920

JULY 14
1923

JULY 14
1923

WHEEL & WAGON CONVEYOR

BLAINE