


#216
L-11-47
20

MAP OF BLOOMINGTON NO 12

OPERATED BY
J. Edward Horn and Company.

Scale: 1 inch = 100 feet. *P.E. Wamelsdorf, Min. Engineer*
REVISED TO

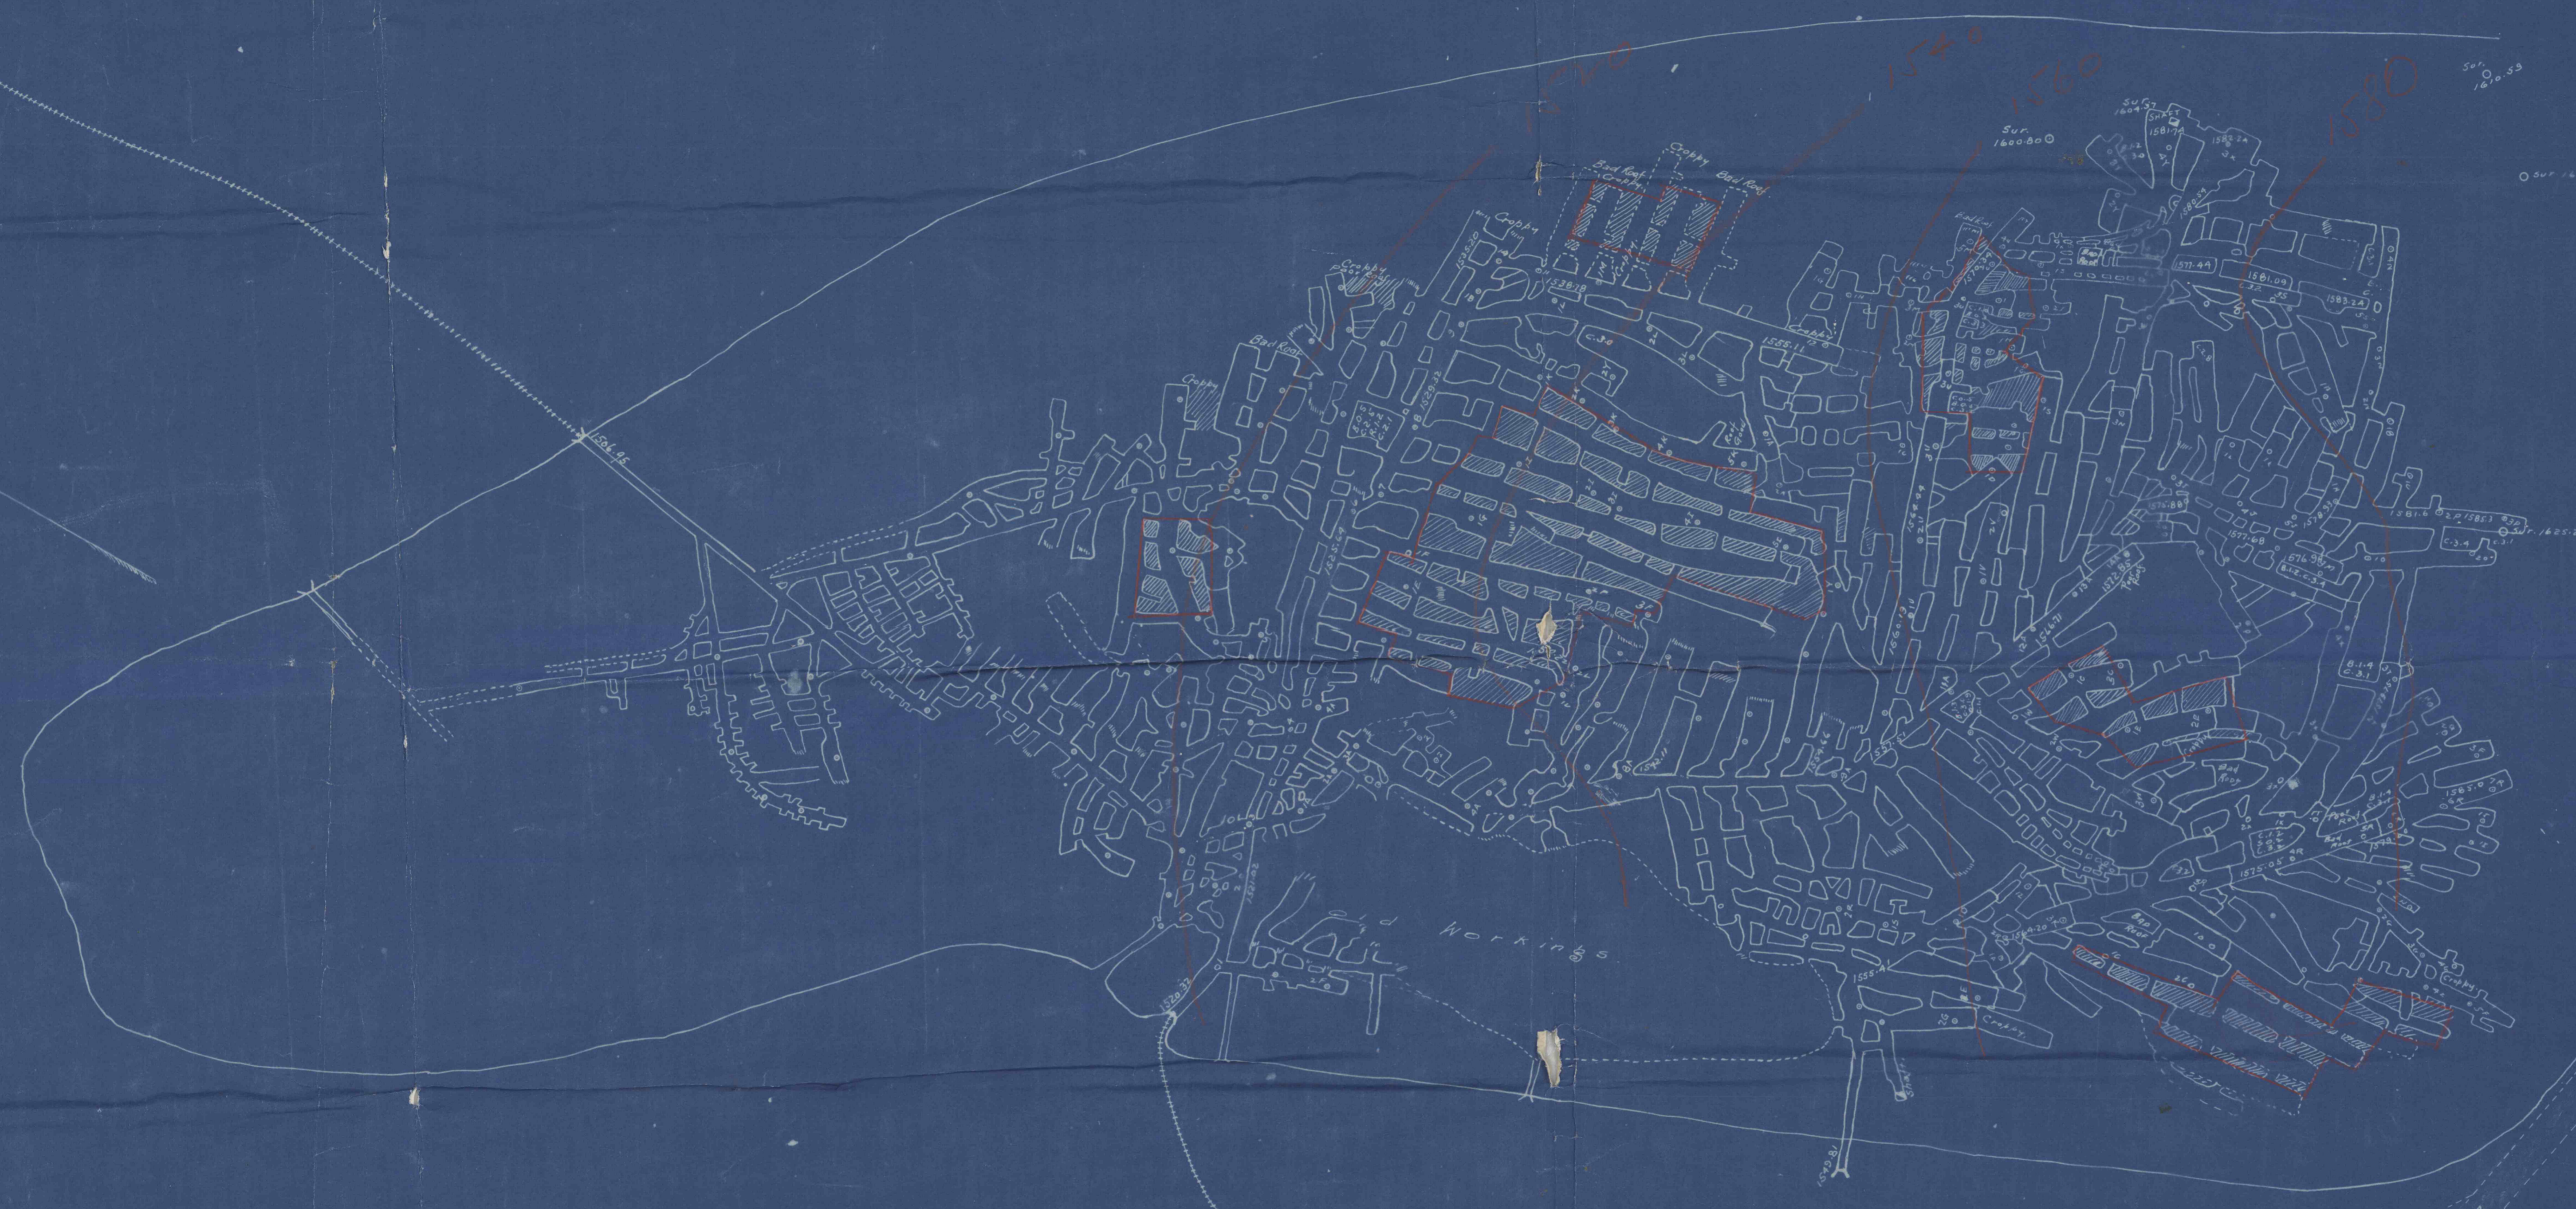

Notes: 125, 183, 220, 263.
Scale: 1 in. = 100 ft.
