


Survey Notes

December 3rd 1905
October 25th 1906
May 7th 1907
April 8th 1908
Jan 14th 1908
Jan 7th 1910
Dec 26th 1910
April 20th 1911
Jan 21st 1912
Dec 12th 1912
Feb 12th 1913

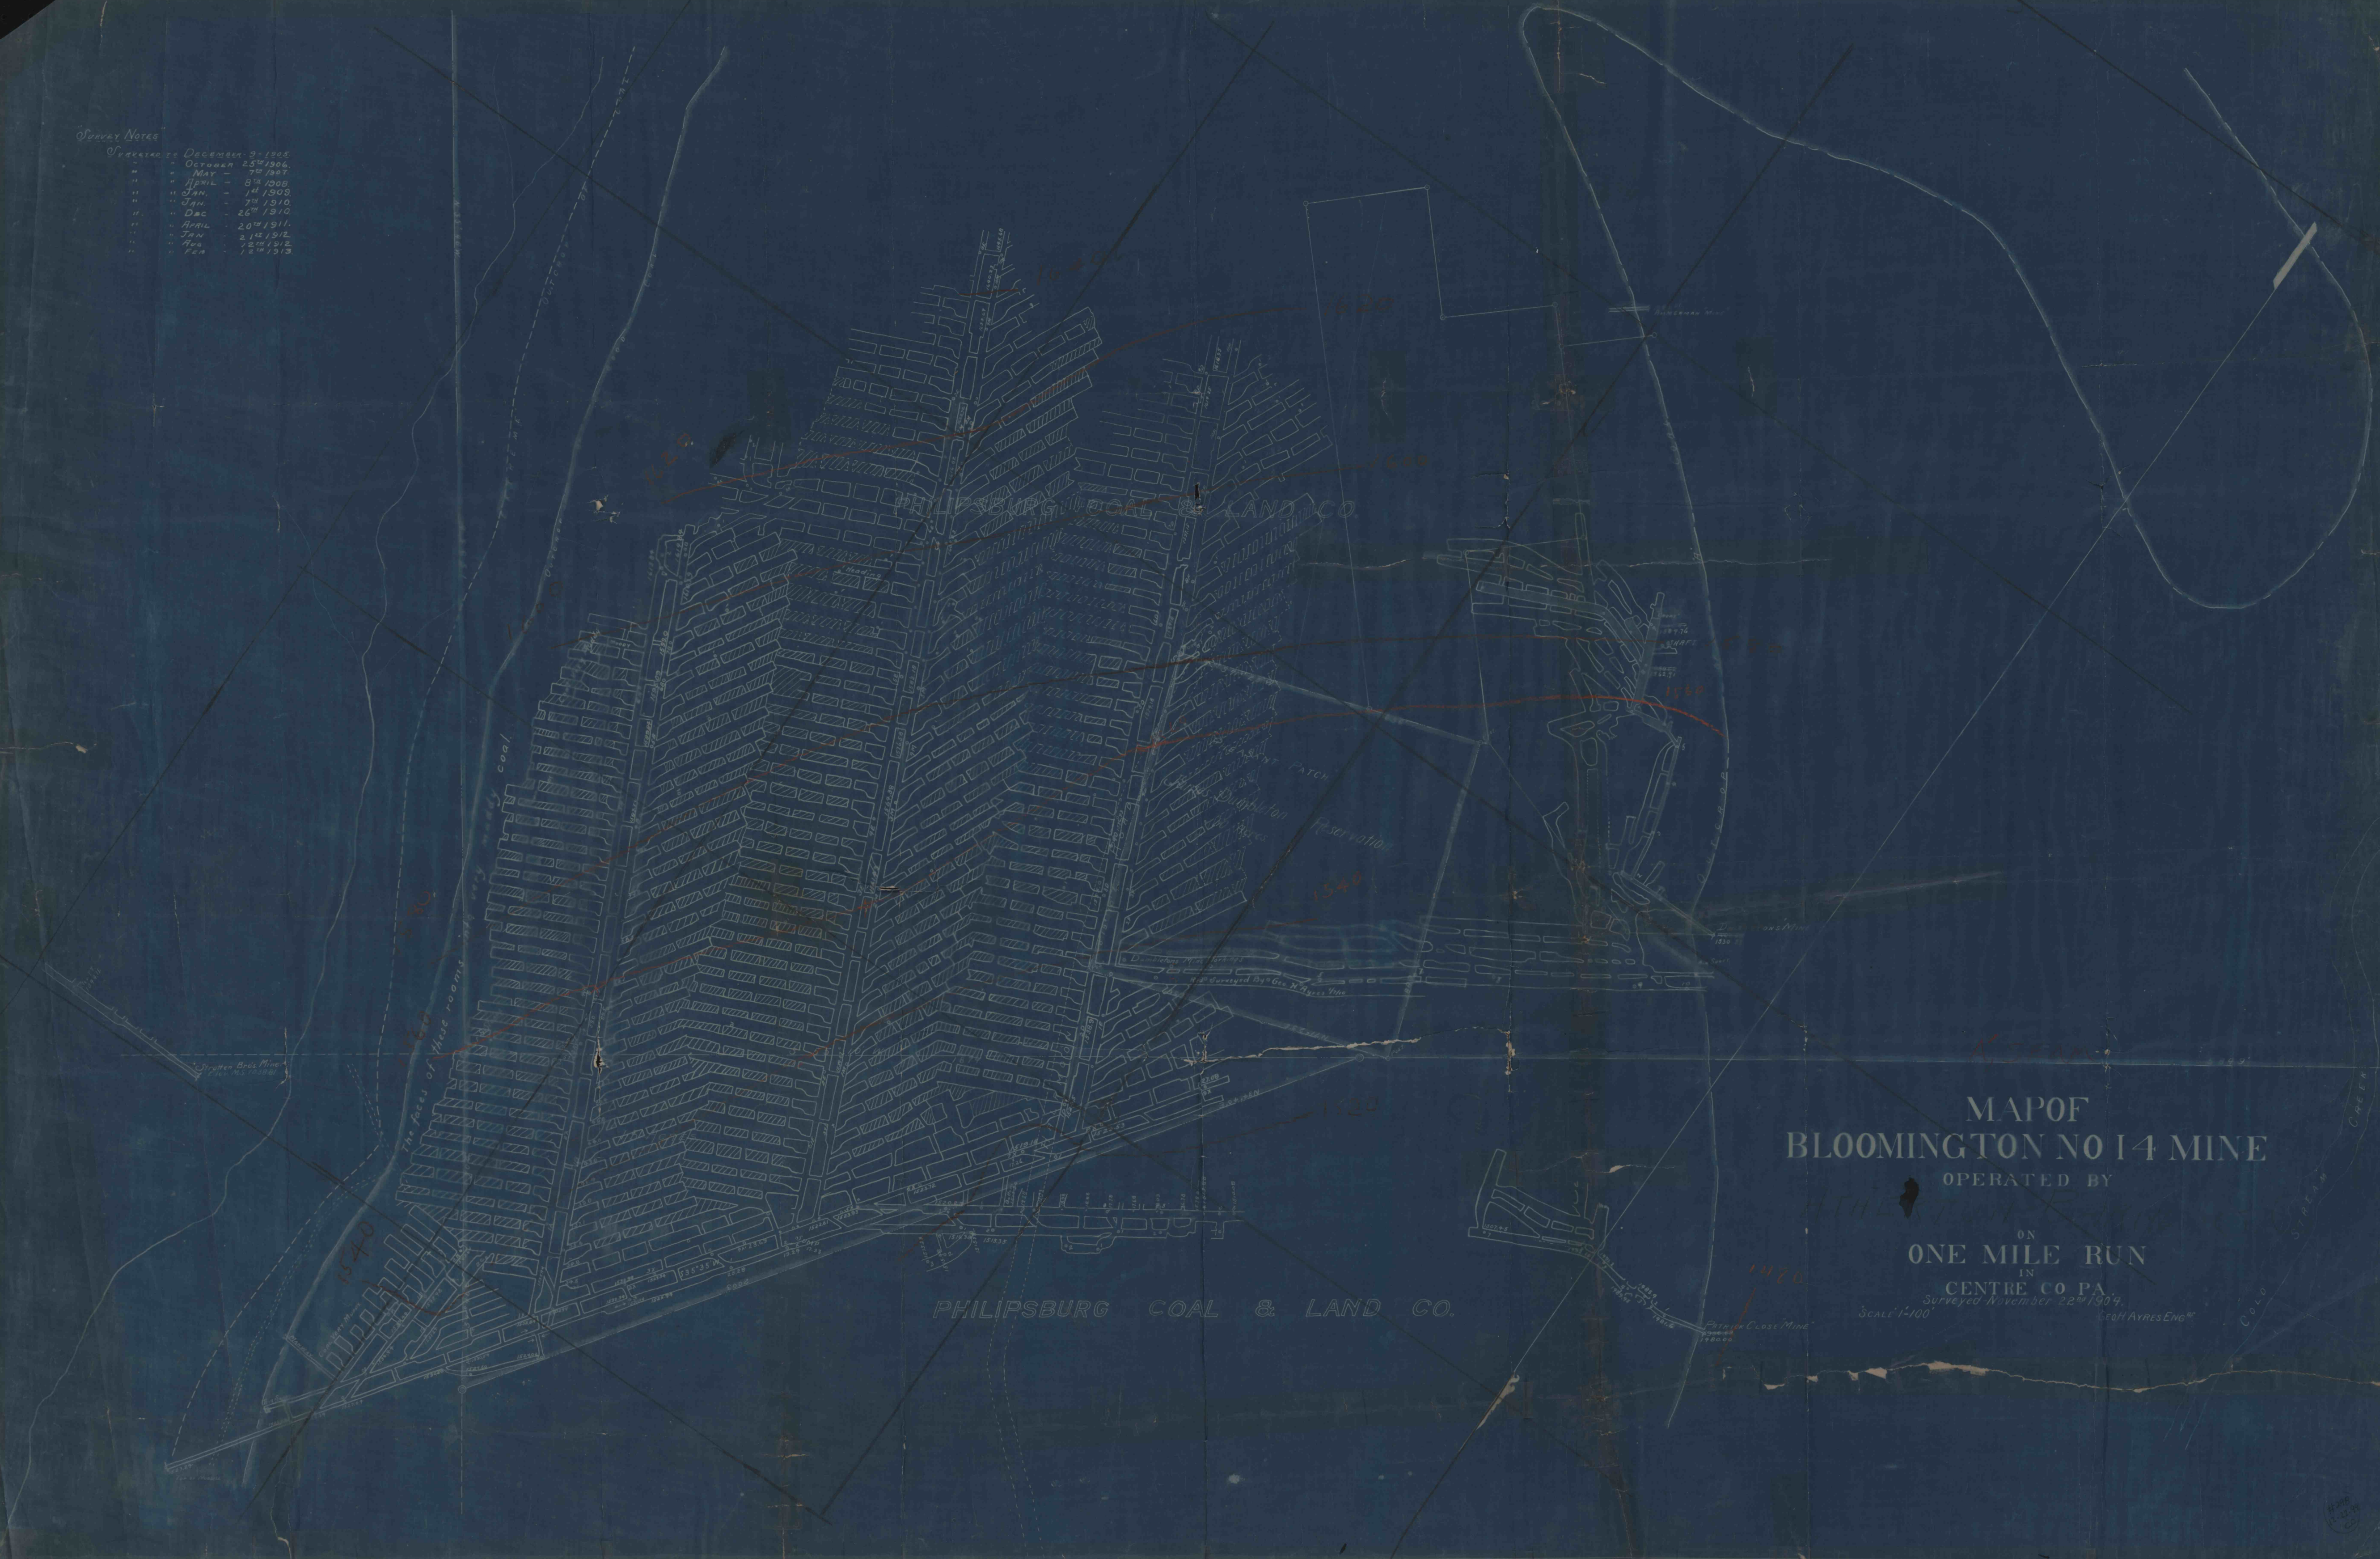

MAP OF
BLOOMINGTON NO 14 MINE
OPERATED BY
PHILIPSBURG COAL & LAND CO.
ON
ONE MILE RUN
IN
CENTRE CO PA.
Surveyed November 22nd 1904.
Scale 1"=100'
Geo. W. Ayres Eng^g

PHILIPSBURG COAL & LAND CO.