


A. M I N I C H.

R E I D
A N D
H O W
L E Y.

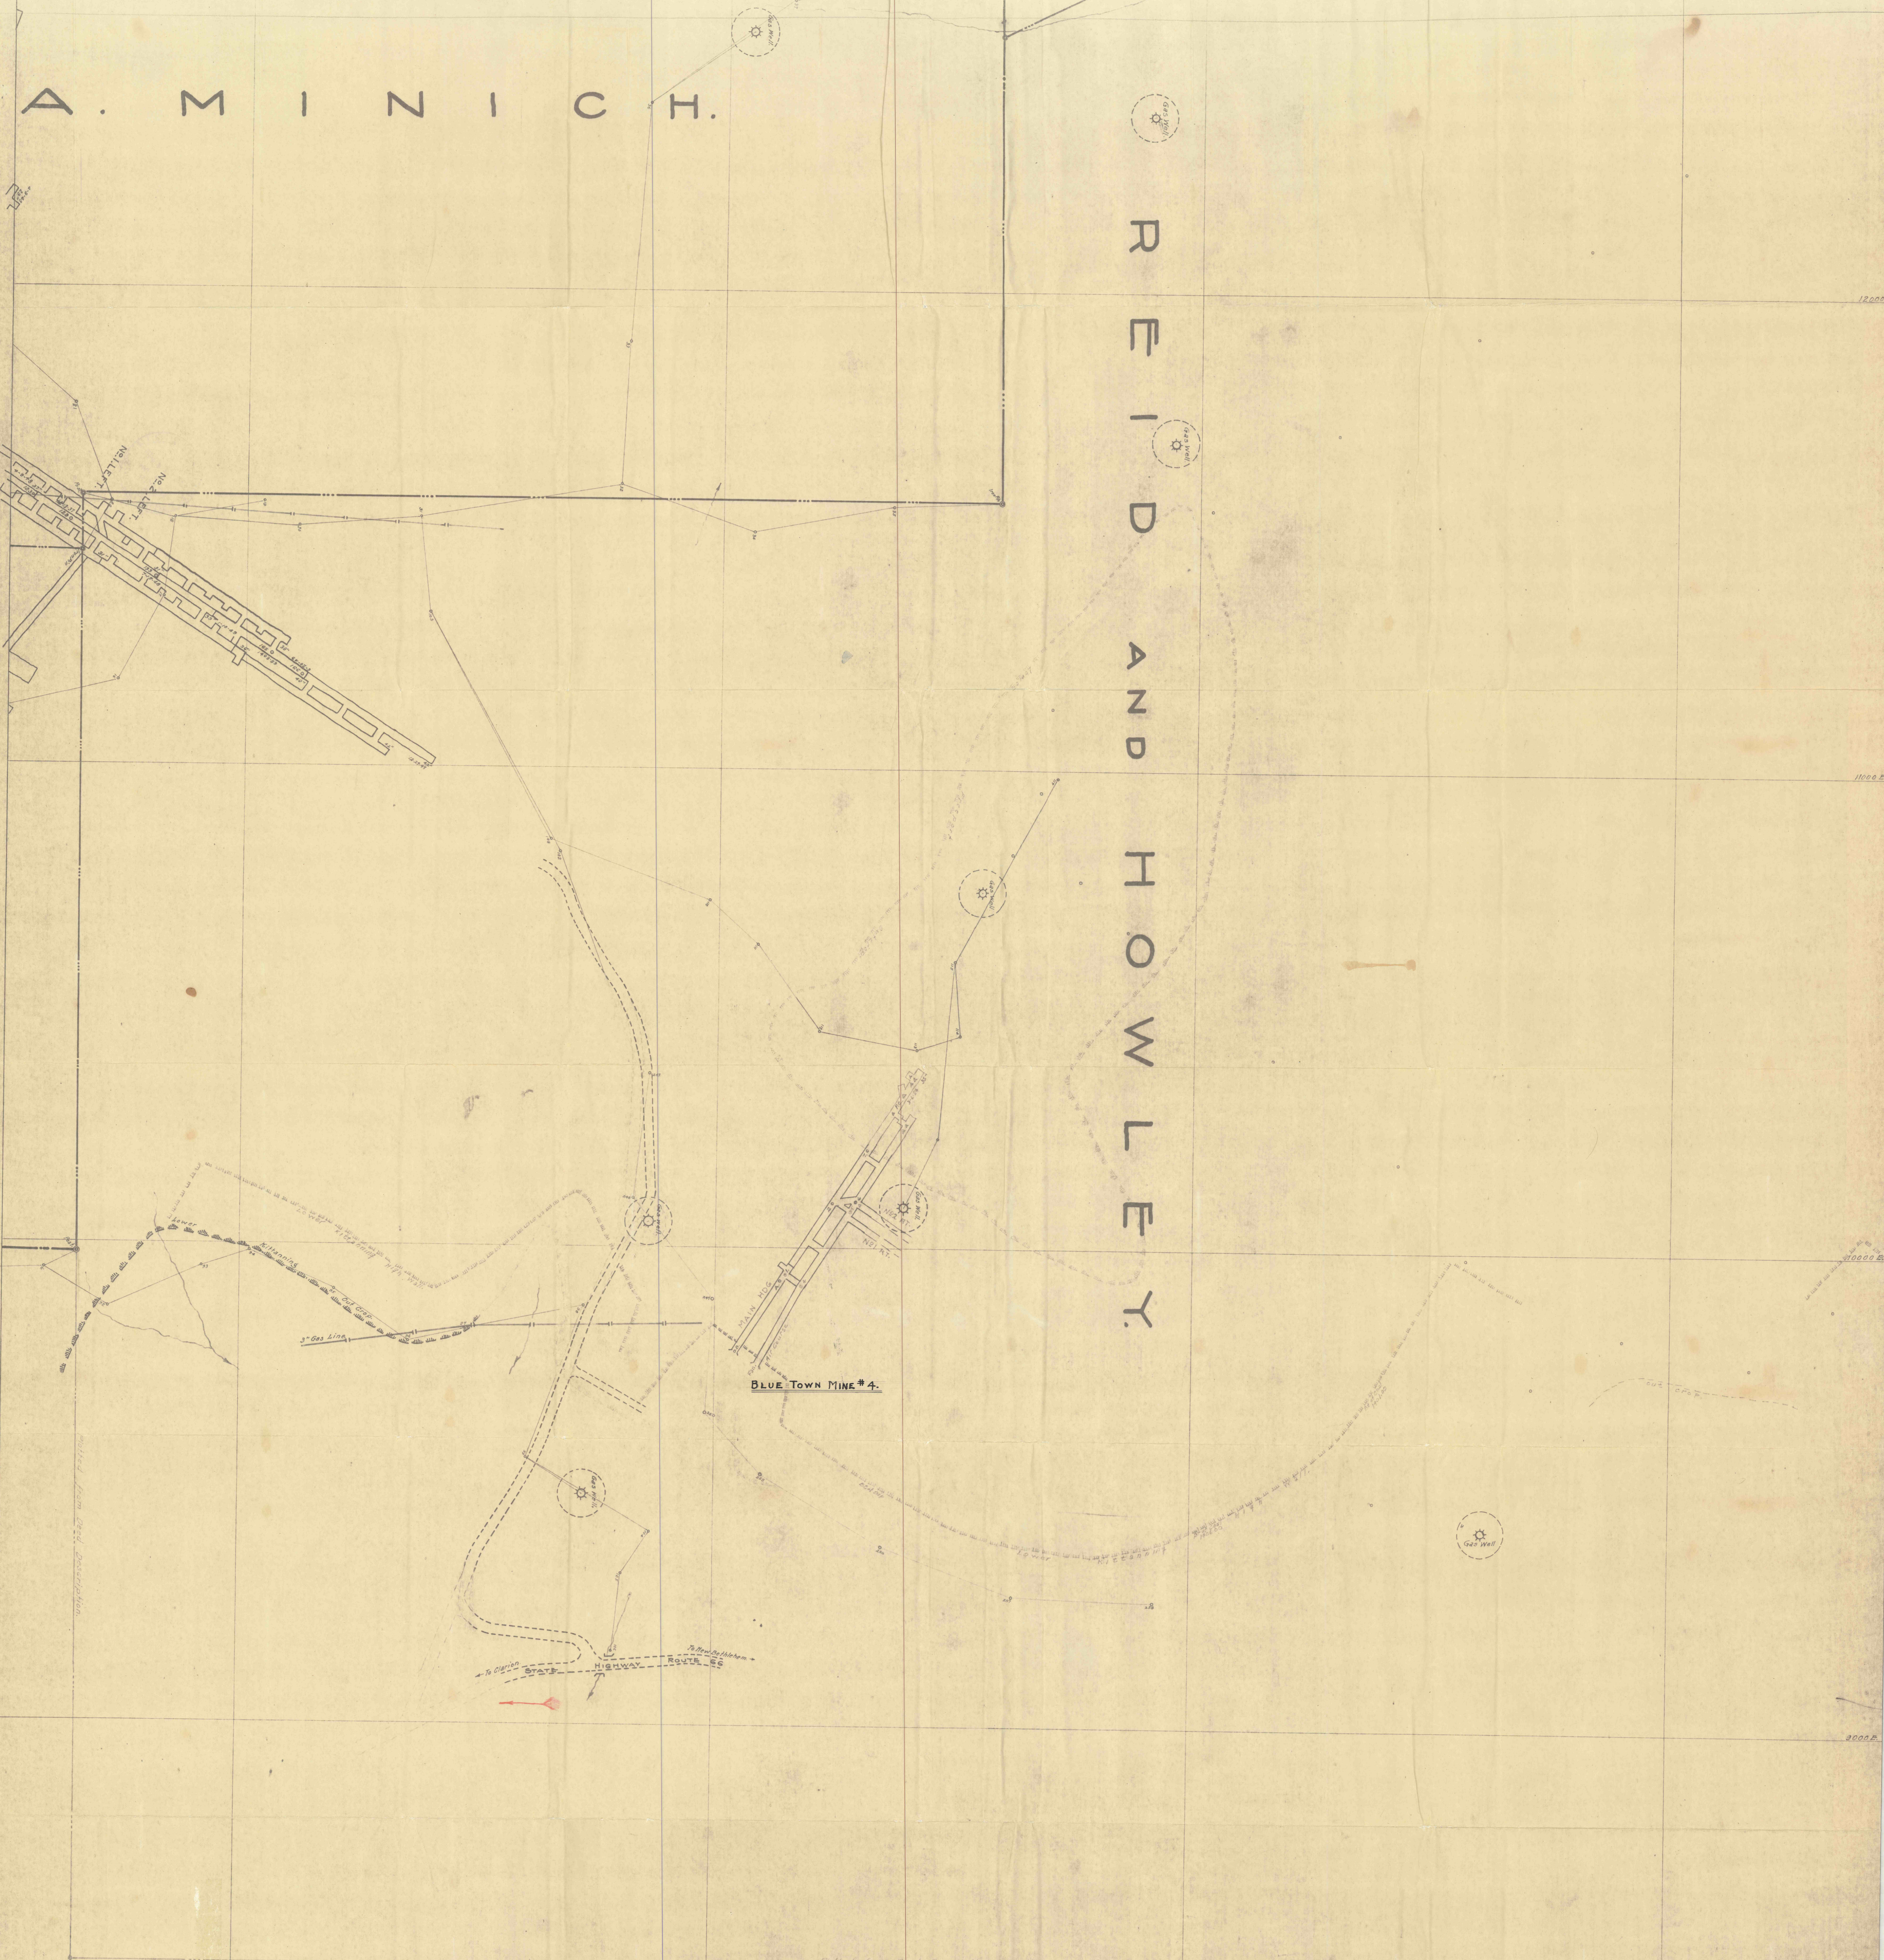

BLUE TOWN MINE # 4.

MAYS COAL Co. (Leasure Run Mine)
BLUE TOWN MINE # 4.

REDBANK TWP. CLARION CO.
Date - 3-6-54 (Last workings) Scale 1" = 100'

EVANS TRUCKING Co.-OPERATOR.
SR. New Bethlehem, Pa. R.I. Fixit Box Eng. #9785 East Brady, Pa.

#312
L-H
C.C.