


← TO PITTSBURG PENNSYLVANIA R.R.

AREA - B" COAL (LOWER KITTANNING)	- 21.67 AC.
" C " (MIDDLE ")	15.00 "
" C " (UPPER ")	18.00 "
" D-E " (FREEPORTS)	10.50 "
MINED OUT	5.10 "
" REMAINING	5.40 "

AVERAGE THICKNESS OF COAL	
B - 3'-10"	
C - 2'-0"	TOO THIN FOR COMMERCIAL COAL
C' - 1'-6"	" " " "
D-E 4'-6"	" " " "

COAL AND SURFACE OWNED IN FEE

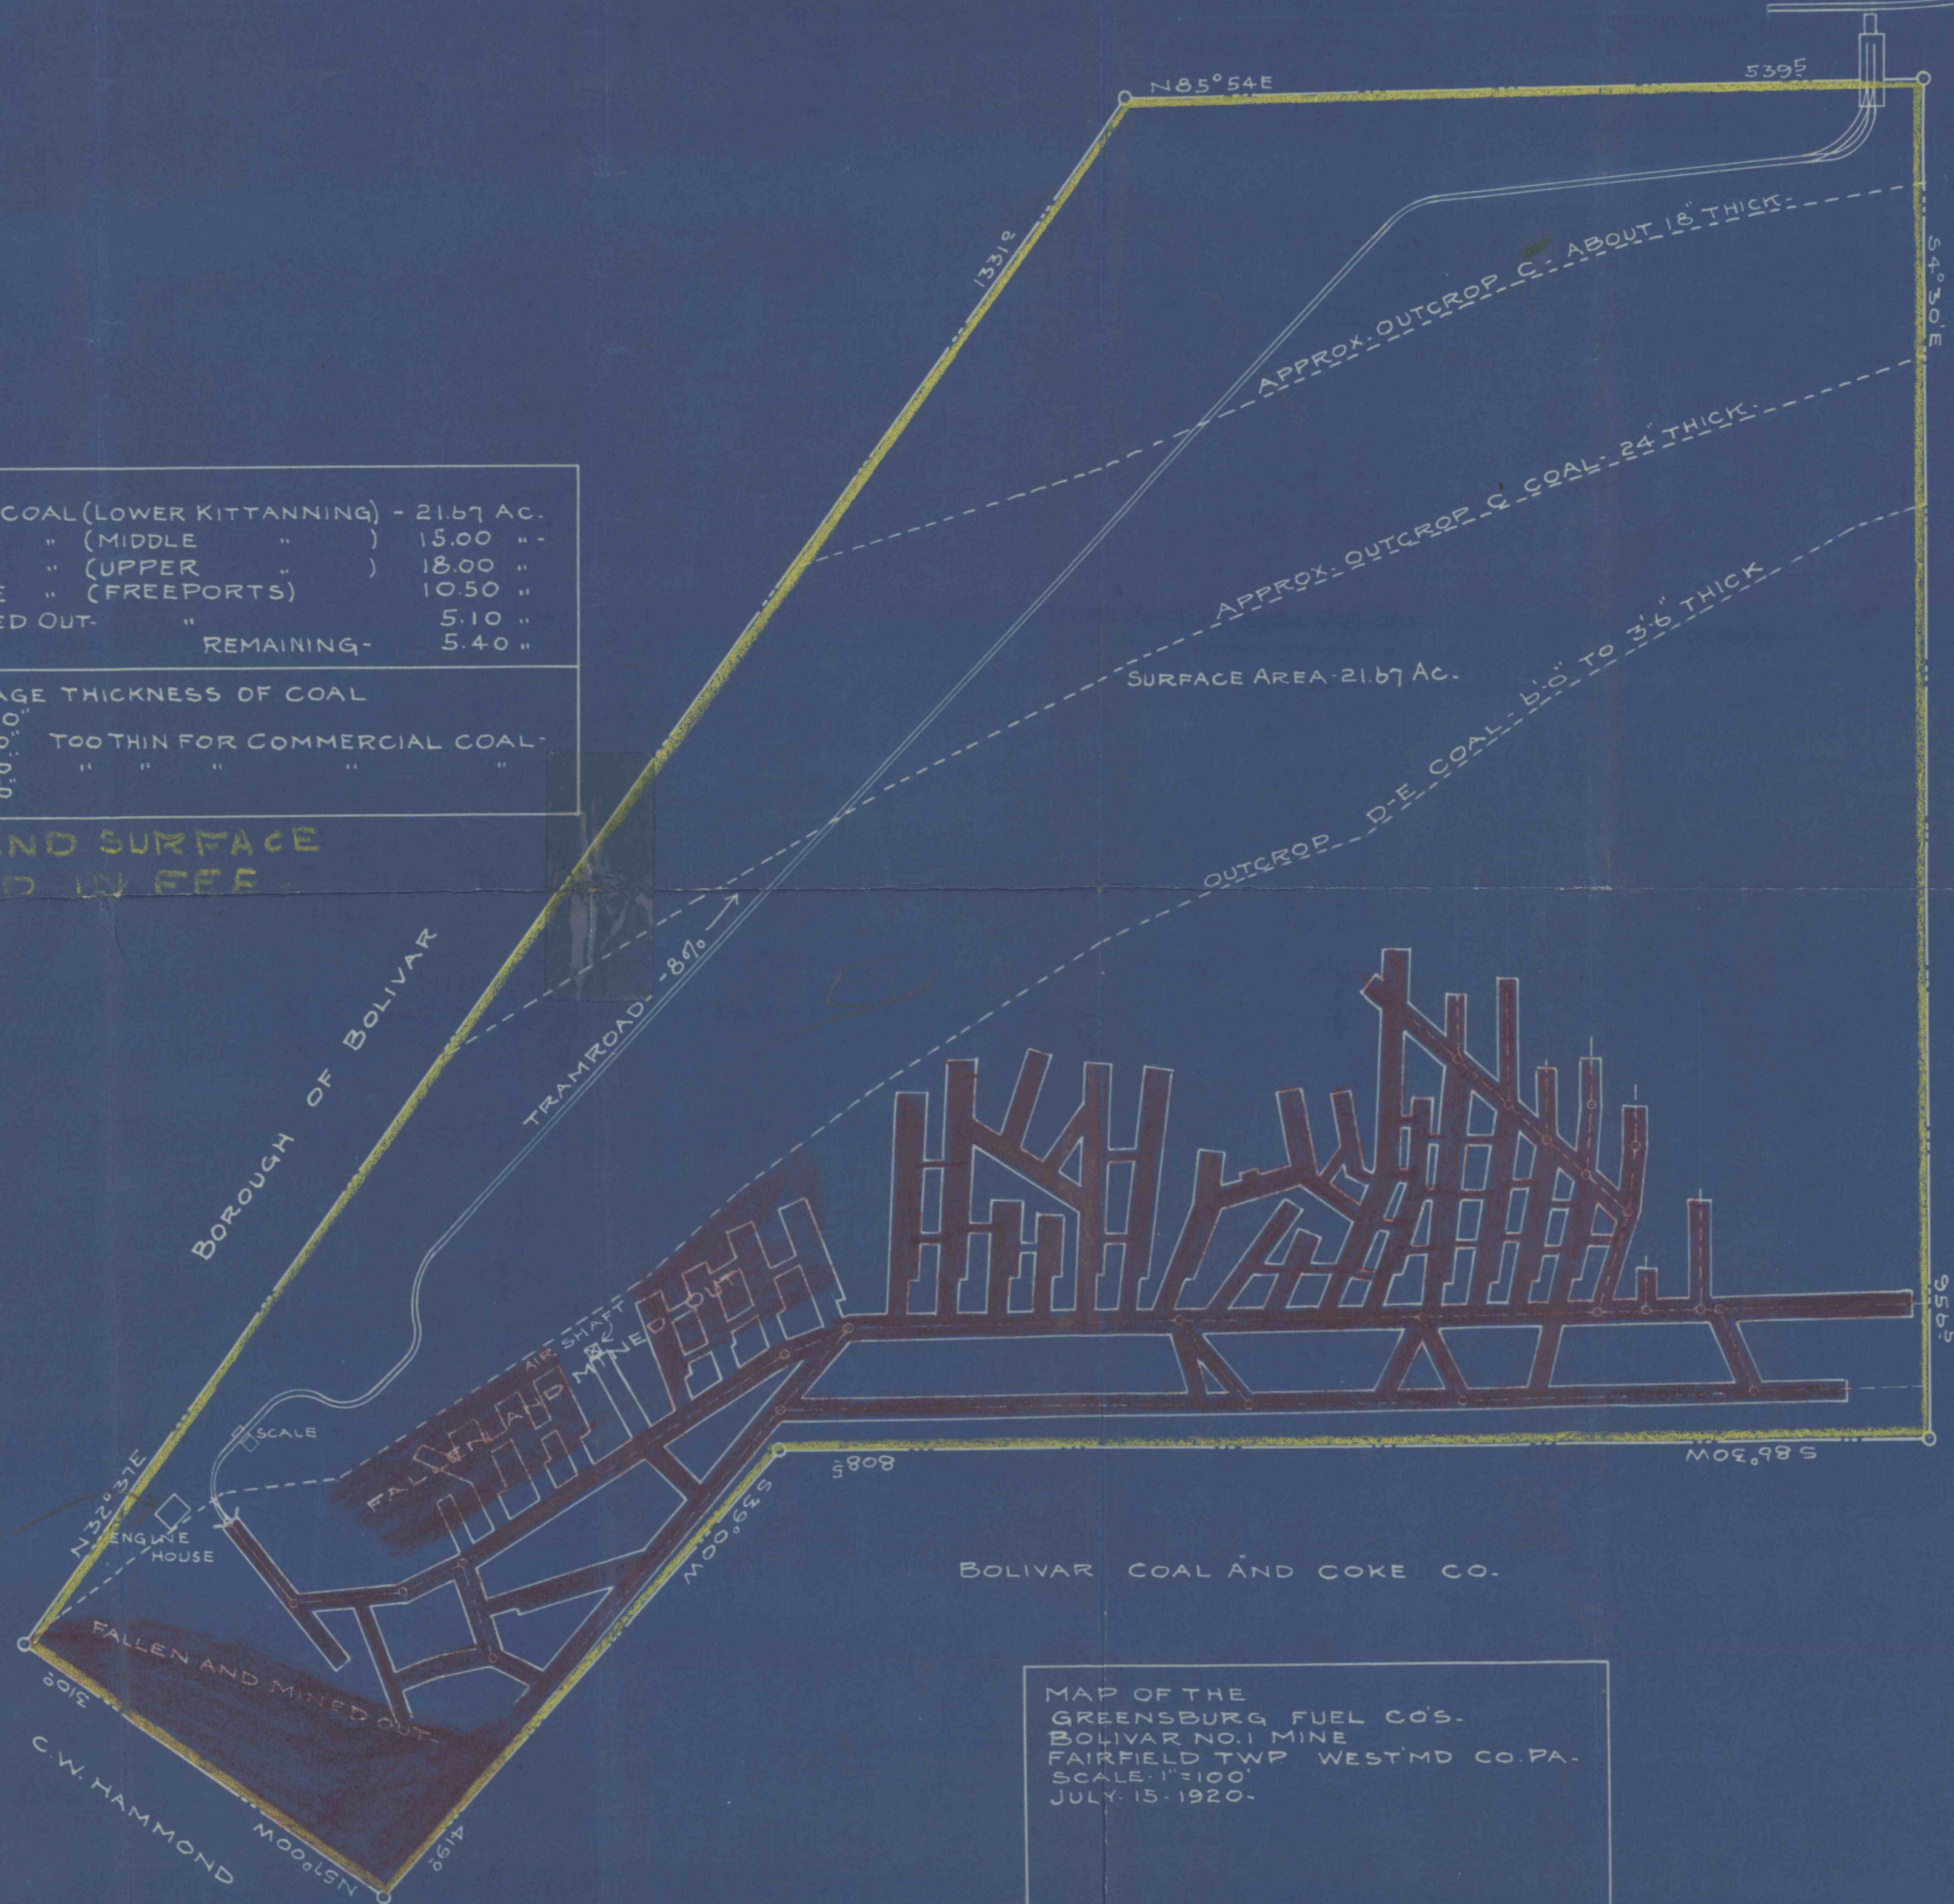

BOLIVAR COAL AND COKE CO.

MSFEELEY BRICK CO.

MAP OF THE
 GREENSBURG FUEL CO'S.
 BOLIVAR NO. 1 MINE
 FAIRFIELD TWP WEST MD CO. PA.
 SCALE 1"=100'
 JULY 15 1920

#325
 6-14-99
 C.C.