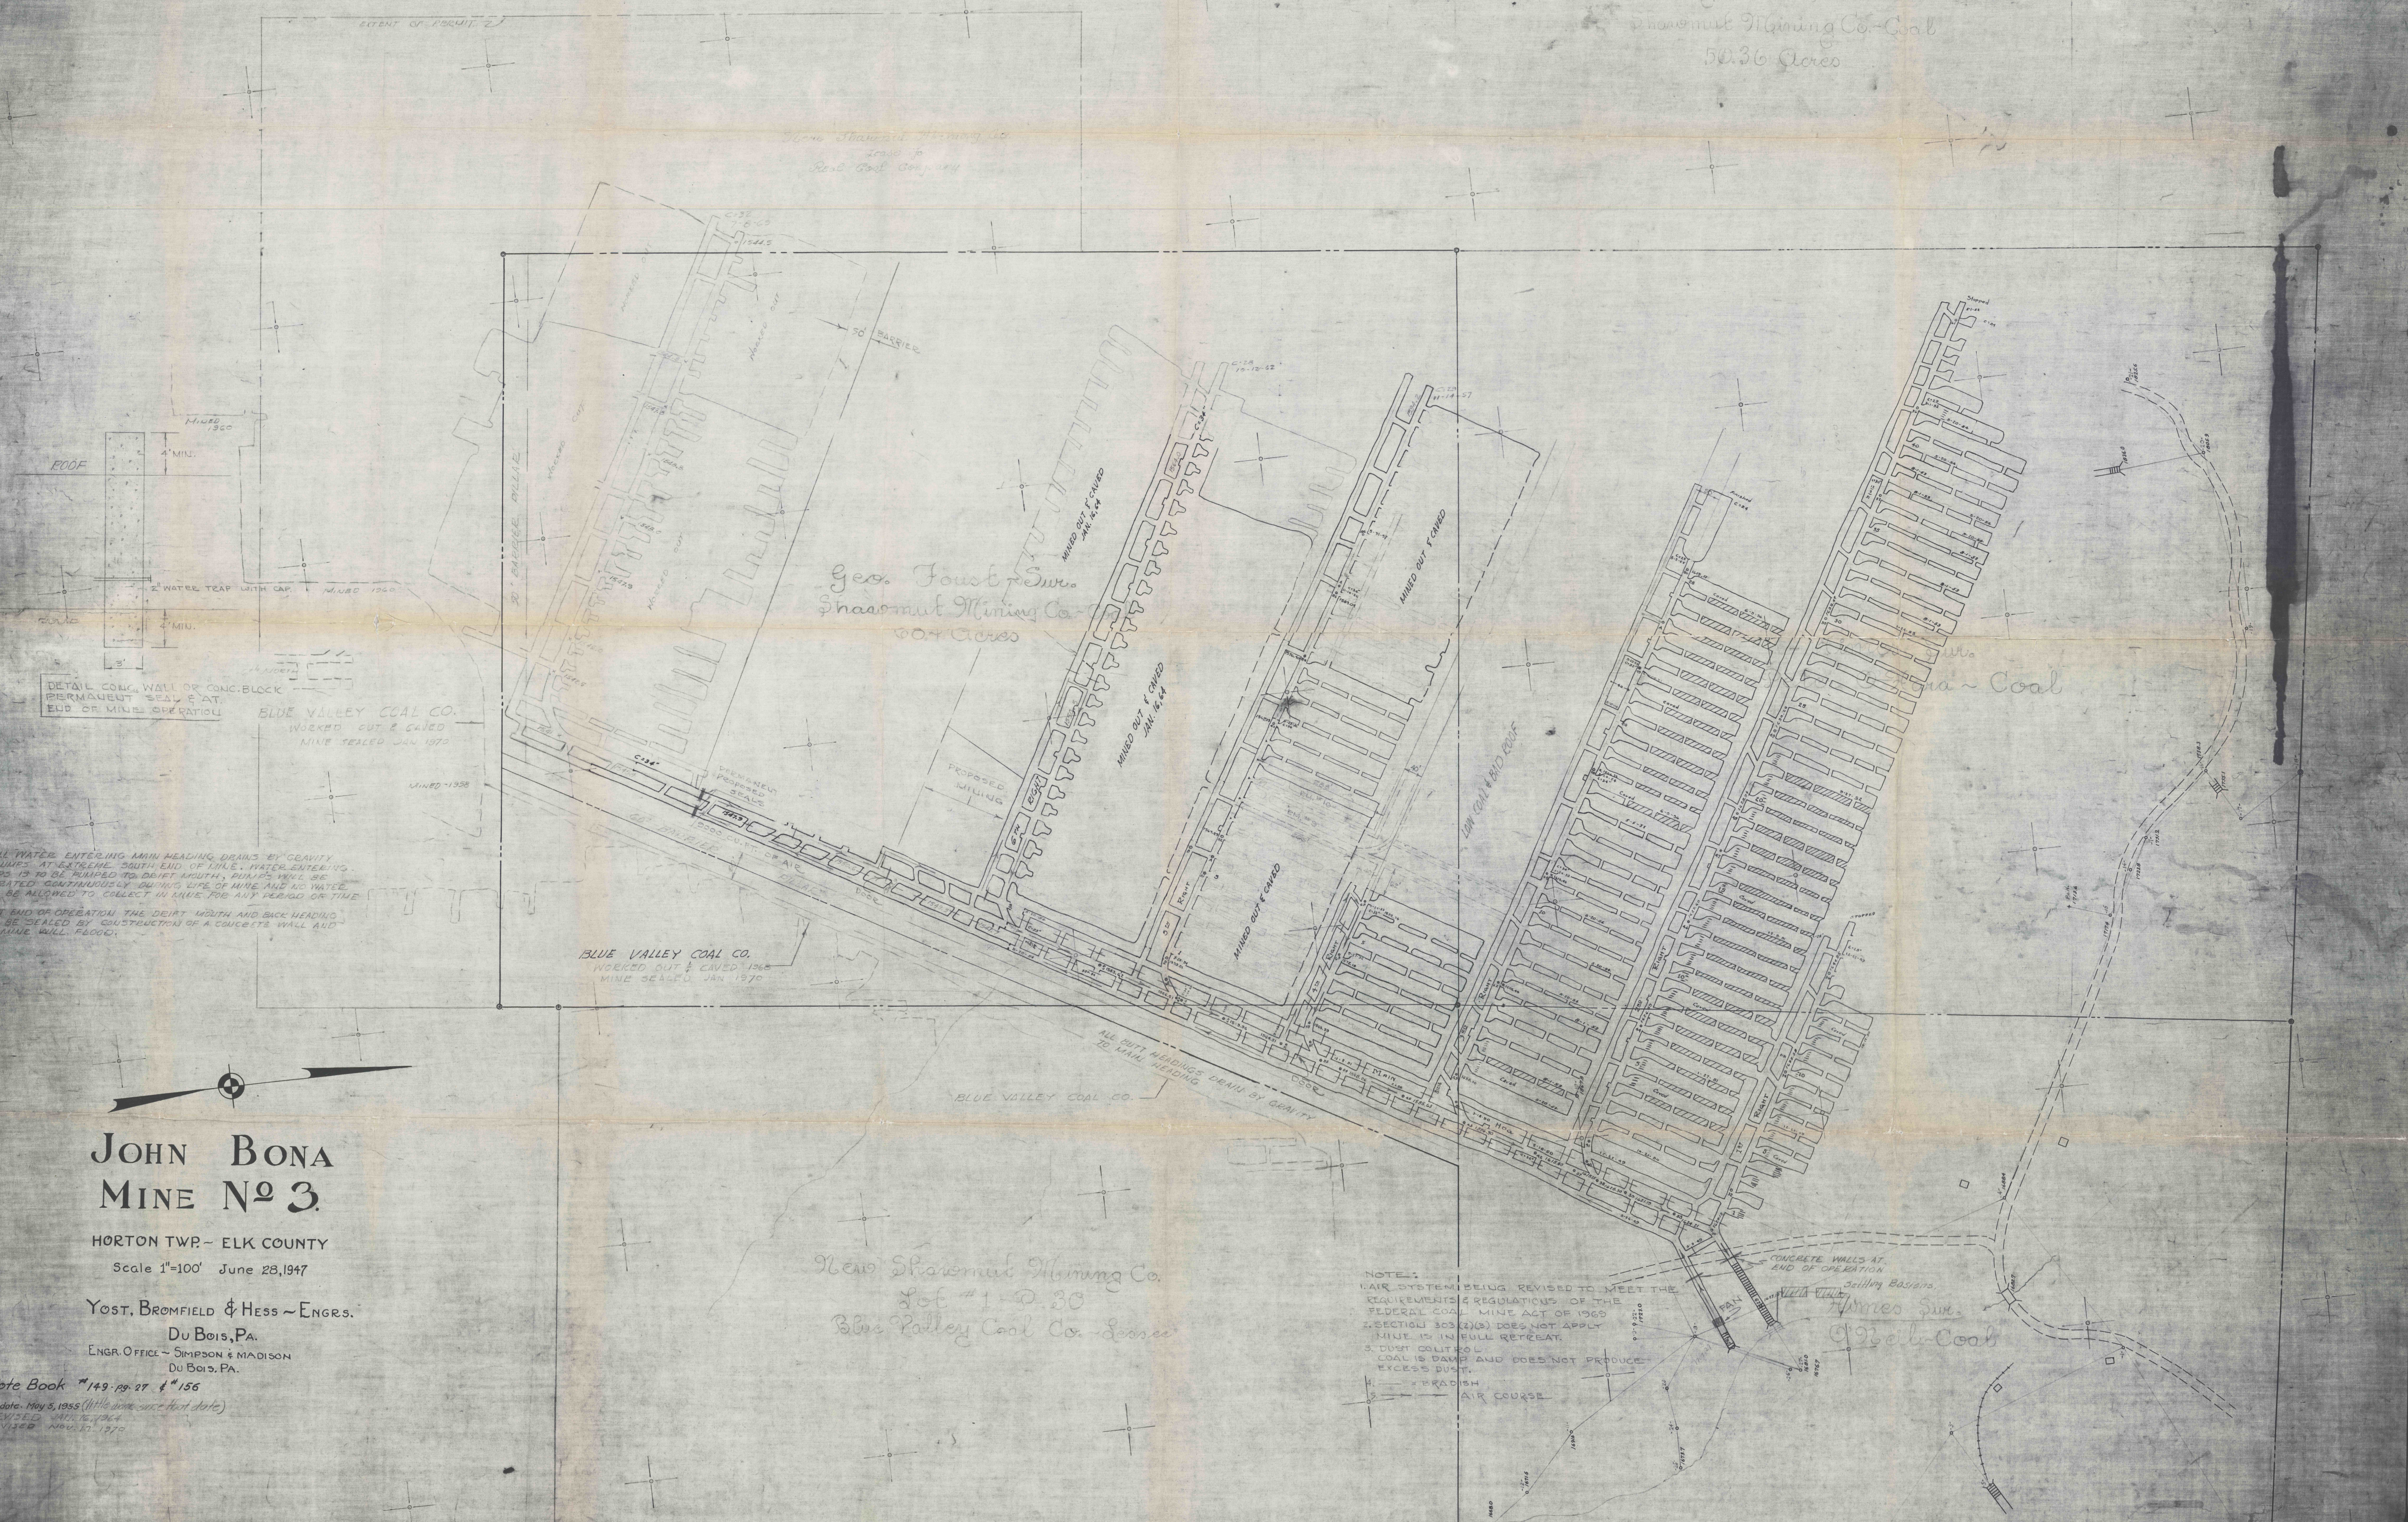

DETAIL CONC. WALL OR CONC. BLOCK
PERMANENT SEAL & AT
END OF MINE OPERATION

NOTE,

ALL WATER ENTERING MAIN HEADING DRAINS BY GRAVITY TO SUMPS AT EXTREME SOUTH END OF MINE. WATER ENTERING SUMPS IS TO BE PUMPED TO DRIFT MOUTH, PUMPS WILL BE OPERATED CONTINUOUSLY DURING LIFE OF MINE AND NO WATER WILL BE ALLOWED TO COLLECT IN MINE FOR ANY PERIOD OF TIME

AT END OF OPERATION THE DRIFT MOUTH AND BACK HEADING WILL BE SEALED BY CONSTRUCTION OF A CONCRETE WALL AND THE MINE WILL FLOOD.

NOTE:
1. AIR SYSTEM BEING REVISED TO MEET THE REQUIREMENTS & REGULATIONS OF THE FEDERAL COAL MINE ACT OF 1969
2. SECTION 303 (Z)(3) DOES NOT APPLY MINE IS IN FULL RETREAT.
3. DUST CONTROL
COAL IS DAMP AND DOES NOT PRODUCE EXCESS DUST.
4. —— = BRADISH
5. ——→ ——→ AIR COURSE

JOHN BONA
MINE Nº 3.

HORTON TWP. ~ ELK COUNTY
Scale 1"=100' June 28, 1947

YOST, BROMFIELD & HESS ~ ENGRS.
DU BOIS, PA.
ENGR. OFFICE ~ SIMPSON & MADISON
DU BOIS, PA.

Note Book #149 - pg. 27 & #156
To date. May 5, 1955 (little work since that date)
REVISED JAN. 16, 1964
REVISED NOV. 17, 1970

#328
6-14-99
C.C.

File No. 1830