

DUFFY

M. WADE


JESSE JONES



Crop line
 Average height coal at crop = 3' 1/2"
 Average height coal at face of workings at July 1st 1920 = 2' 8"

To Lake Trade coal mine.

To Millers Crossing on B. & E. RR.

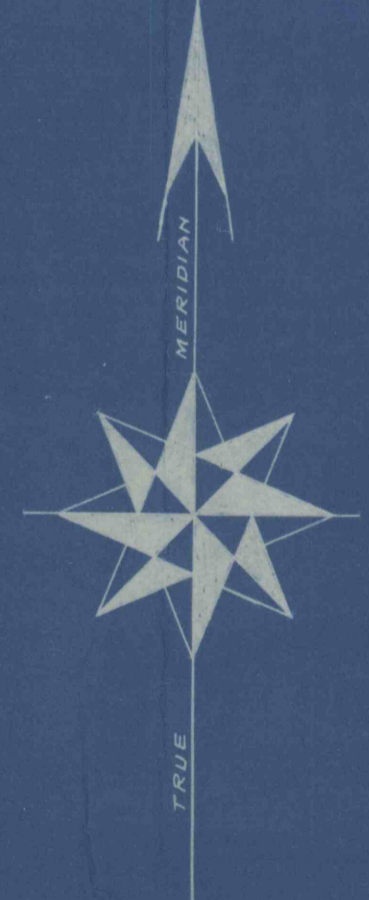

LEGEND		
Symbol	Date of Survey	Made by
A	Dec 1917	F.P.G.
B	June 14 1916	W.P.V.

BOSTON MINING CO
MAP OF MINE
 SITUATE IN
VENANGO TWP BUTLER CO PENNA

SCALE 1 INCH = 100 FT.

Surveyed Nov. 1917 Frank P. Graham Engr.
 Grove City, Pa.

#331
 6-15-17
 C.C.