

THE BOWERS COAL CO.



SPRINGHILL TWP FAYETTE COUNTY PA.

SCALE 1"=100'

H. B. GANS ENGR.

SURVEY A JAN 31 1919

" B Feb 3 1920

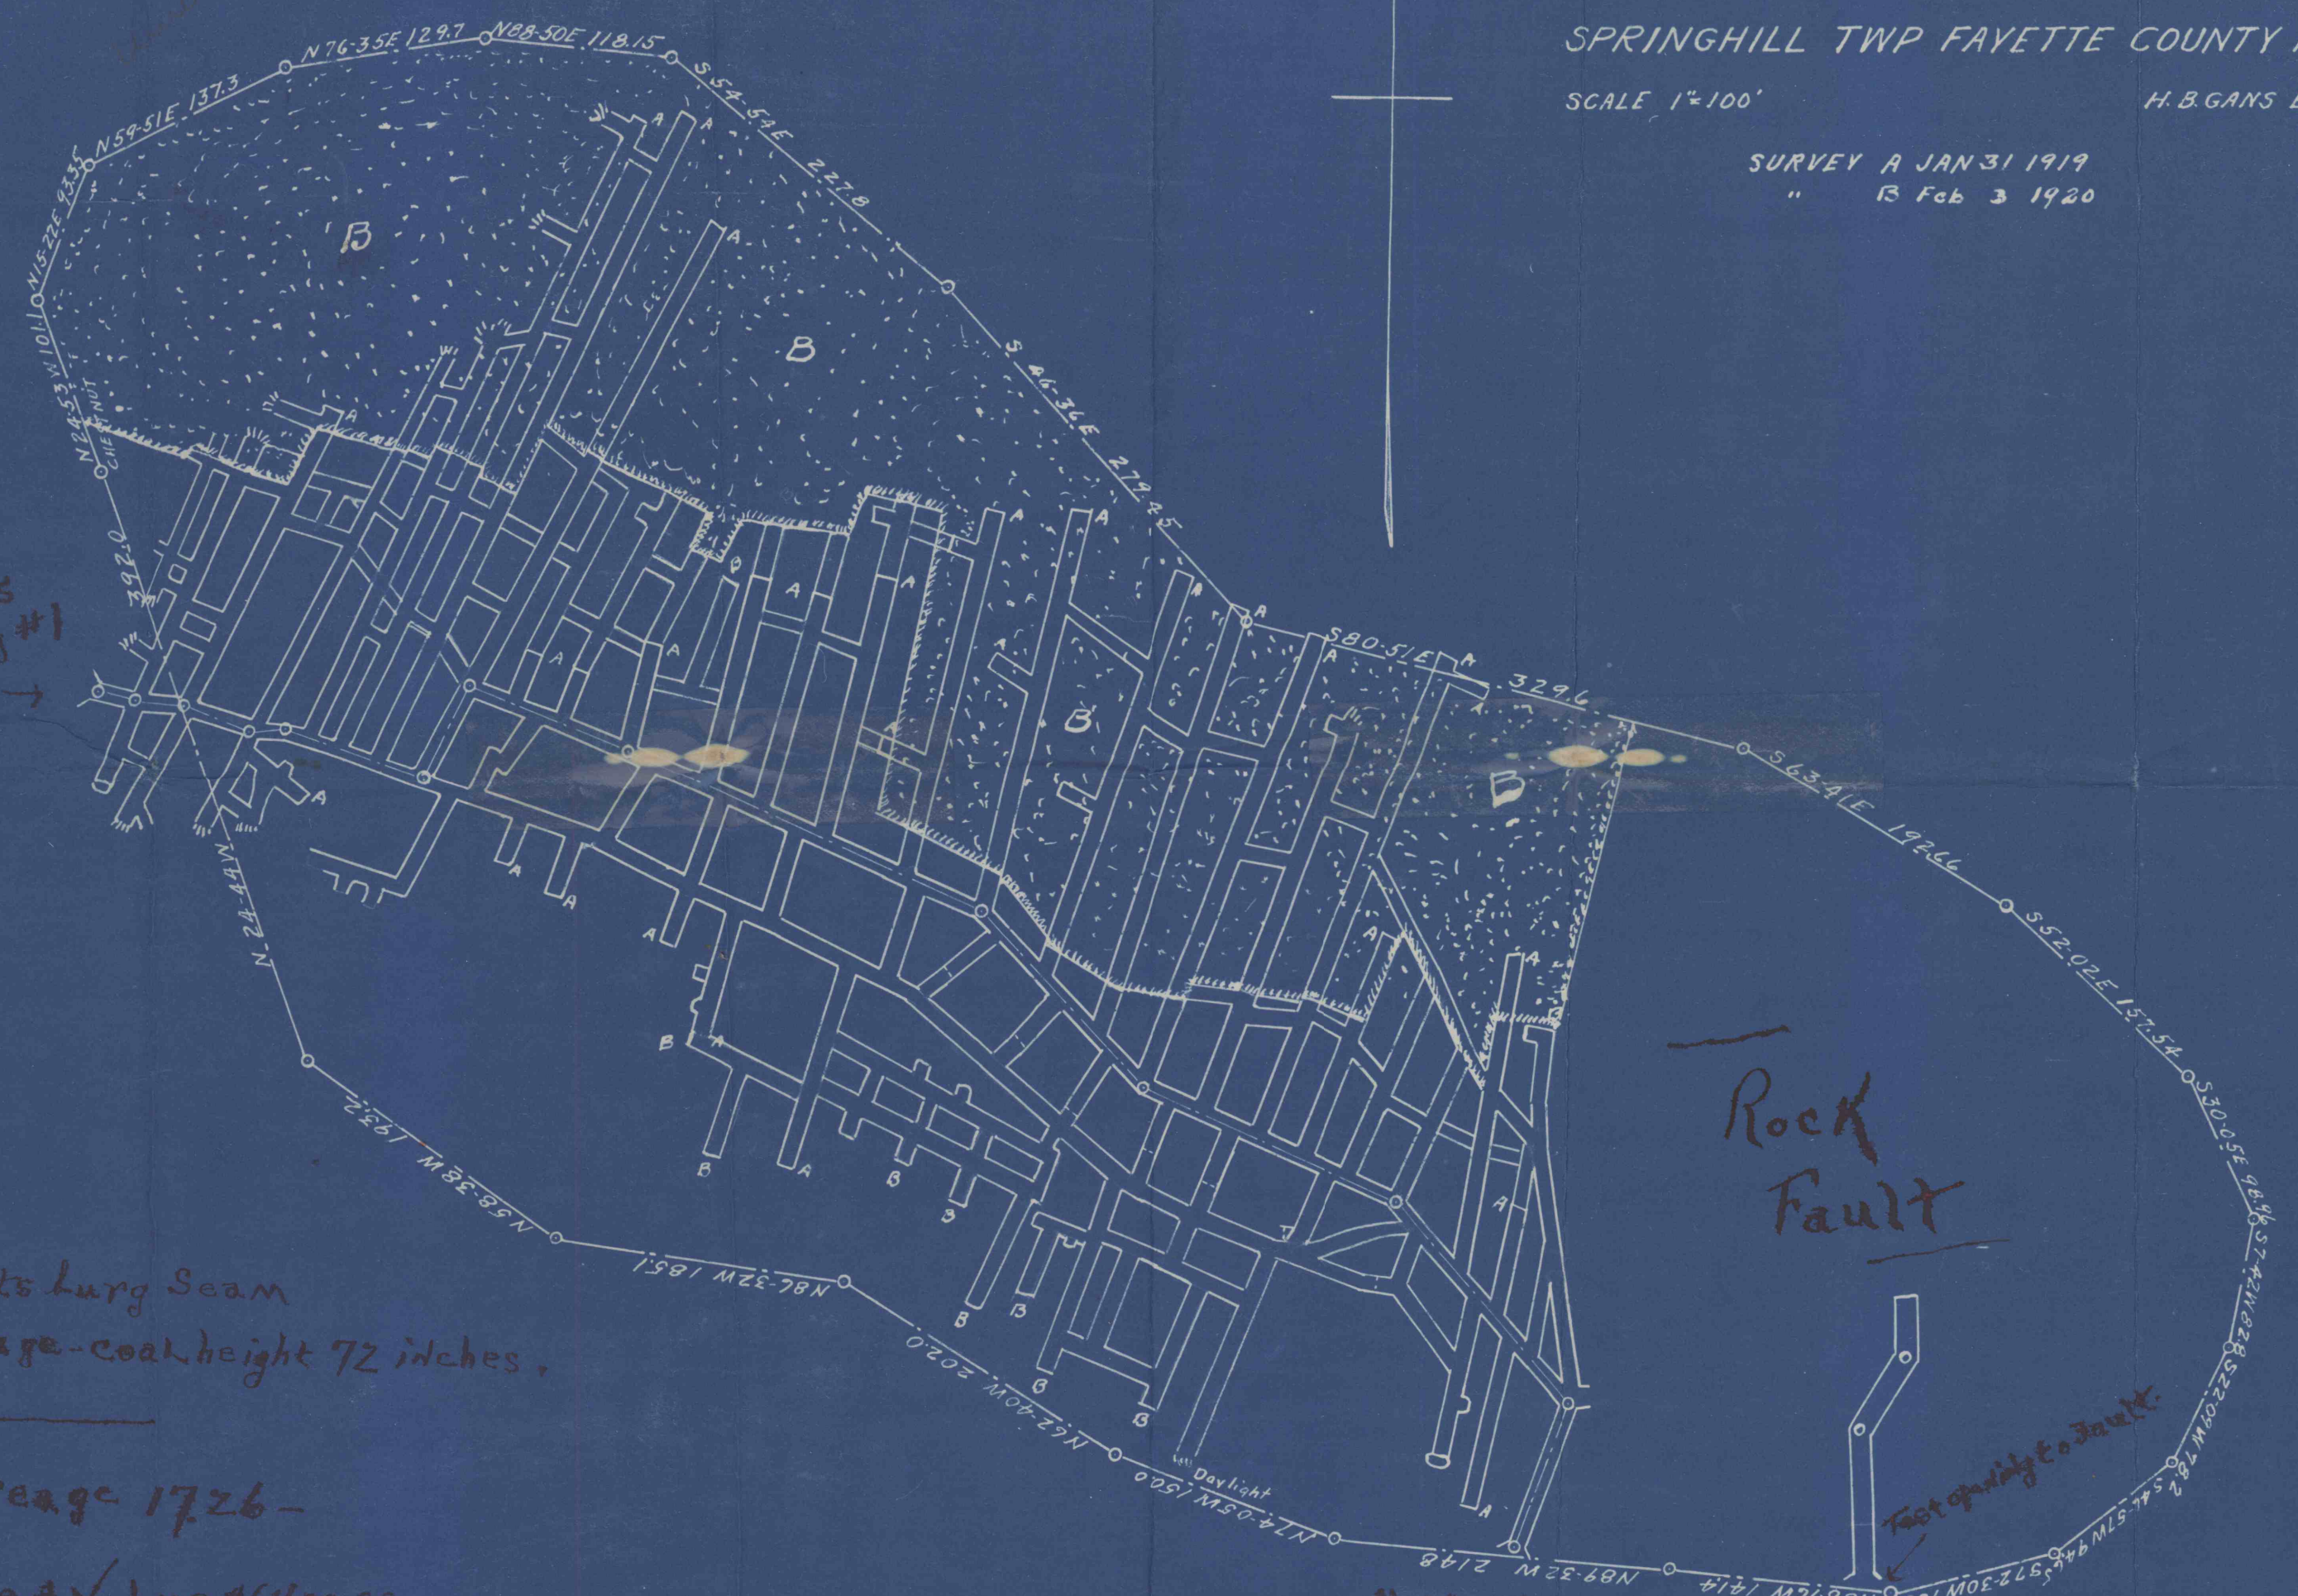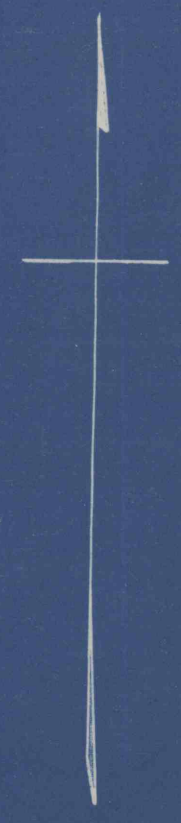

Bowers Opening #1

Rock Fault

Foot opening to fault

Bowers Opening #2

All Pits Lurg Seam  
Average coal height 72 inches.

Acreage 1726-

Assessed Value \$6400.00

#334  
6-15-97  
C.C.