


318291

July 17, 1943

I hereby certify that this tracing is a true and correct copy of the original map of the Bowers and Neal Mine, situate in Banks Township, Indiana County, Pa.

Walter J. Zimmerman

W. J. Zimmerman
Reg. Surveyor No. 4940

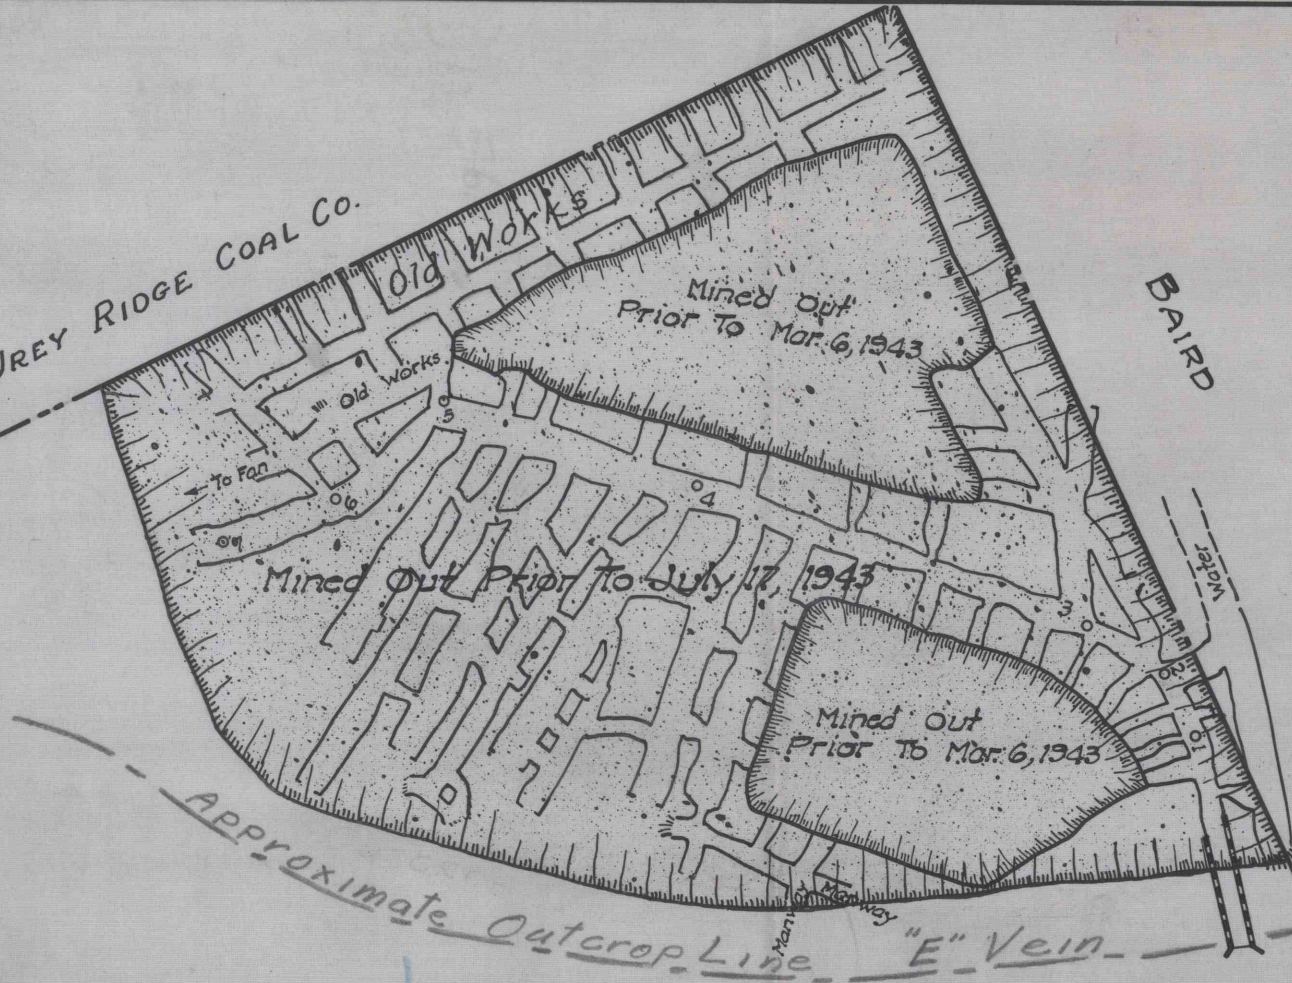

*Compl. file
Revised file
RM*

MAP OF BOWERS & NEAL MINE

BANKS TOWNSHIP INDIANA COUNTY PA.
SCALE 1"=100' MARCH 1943
WALTER J. ZIMMERMAN SURVEYOR
PUNKSUTAWNEY PENNA.

#336
6-15-99
C.C.