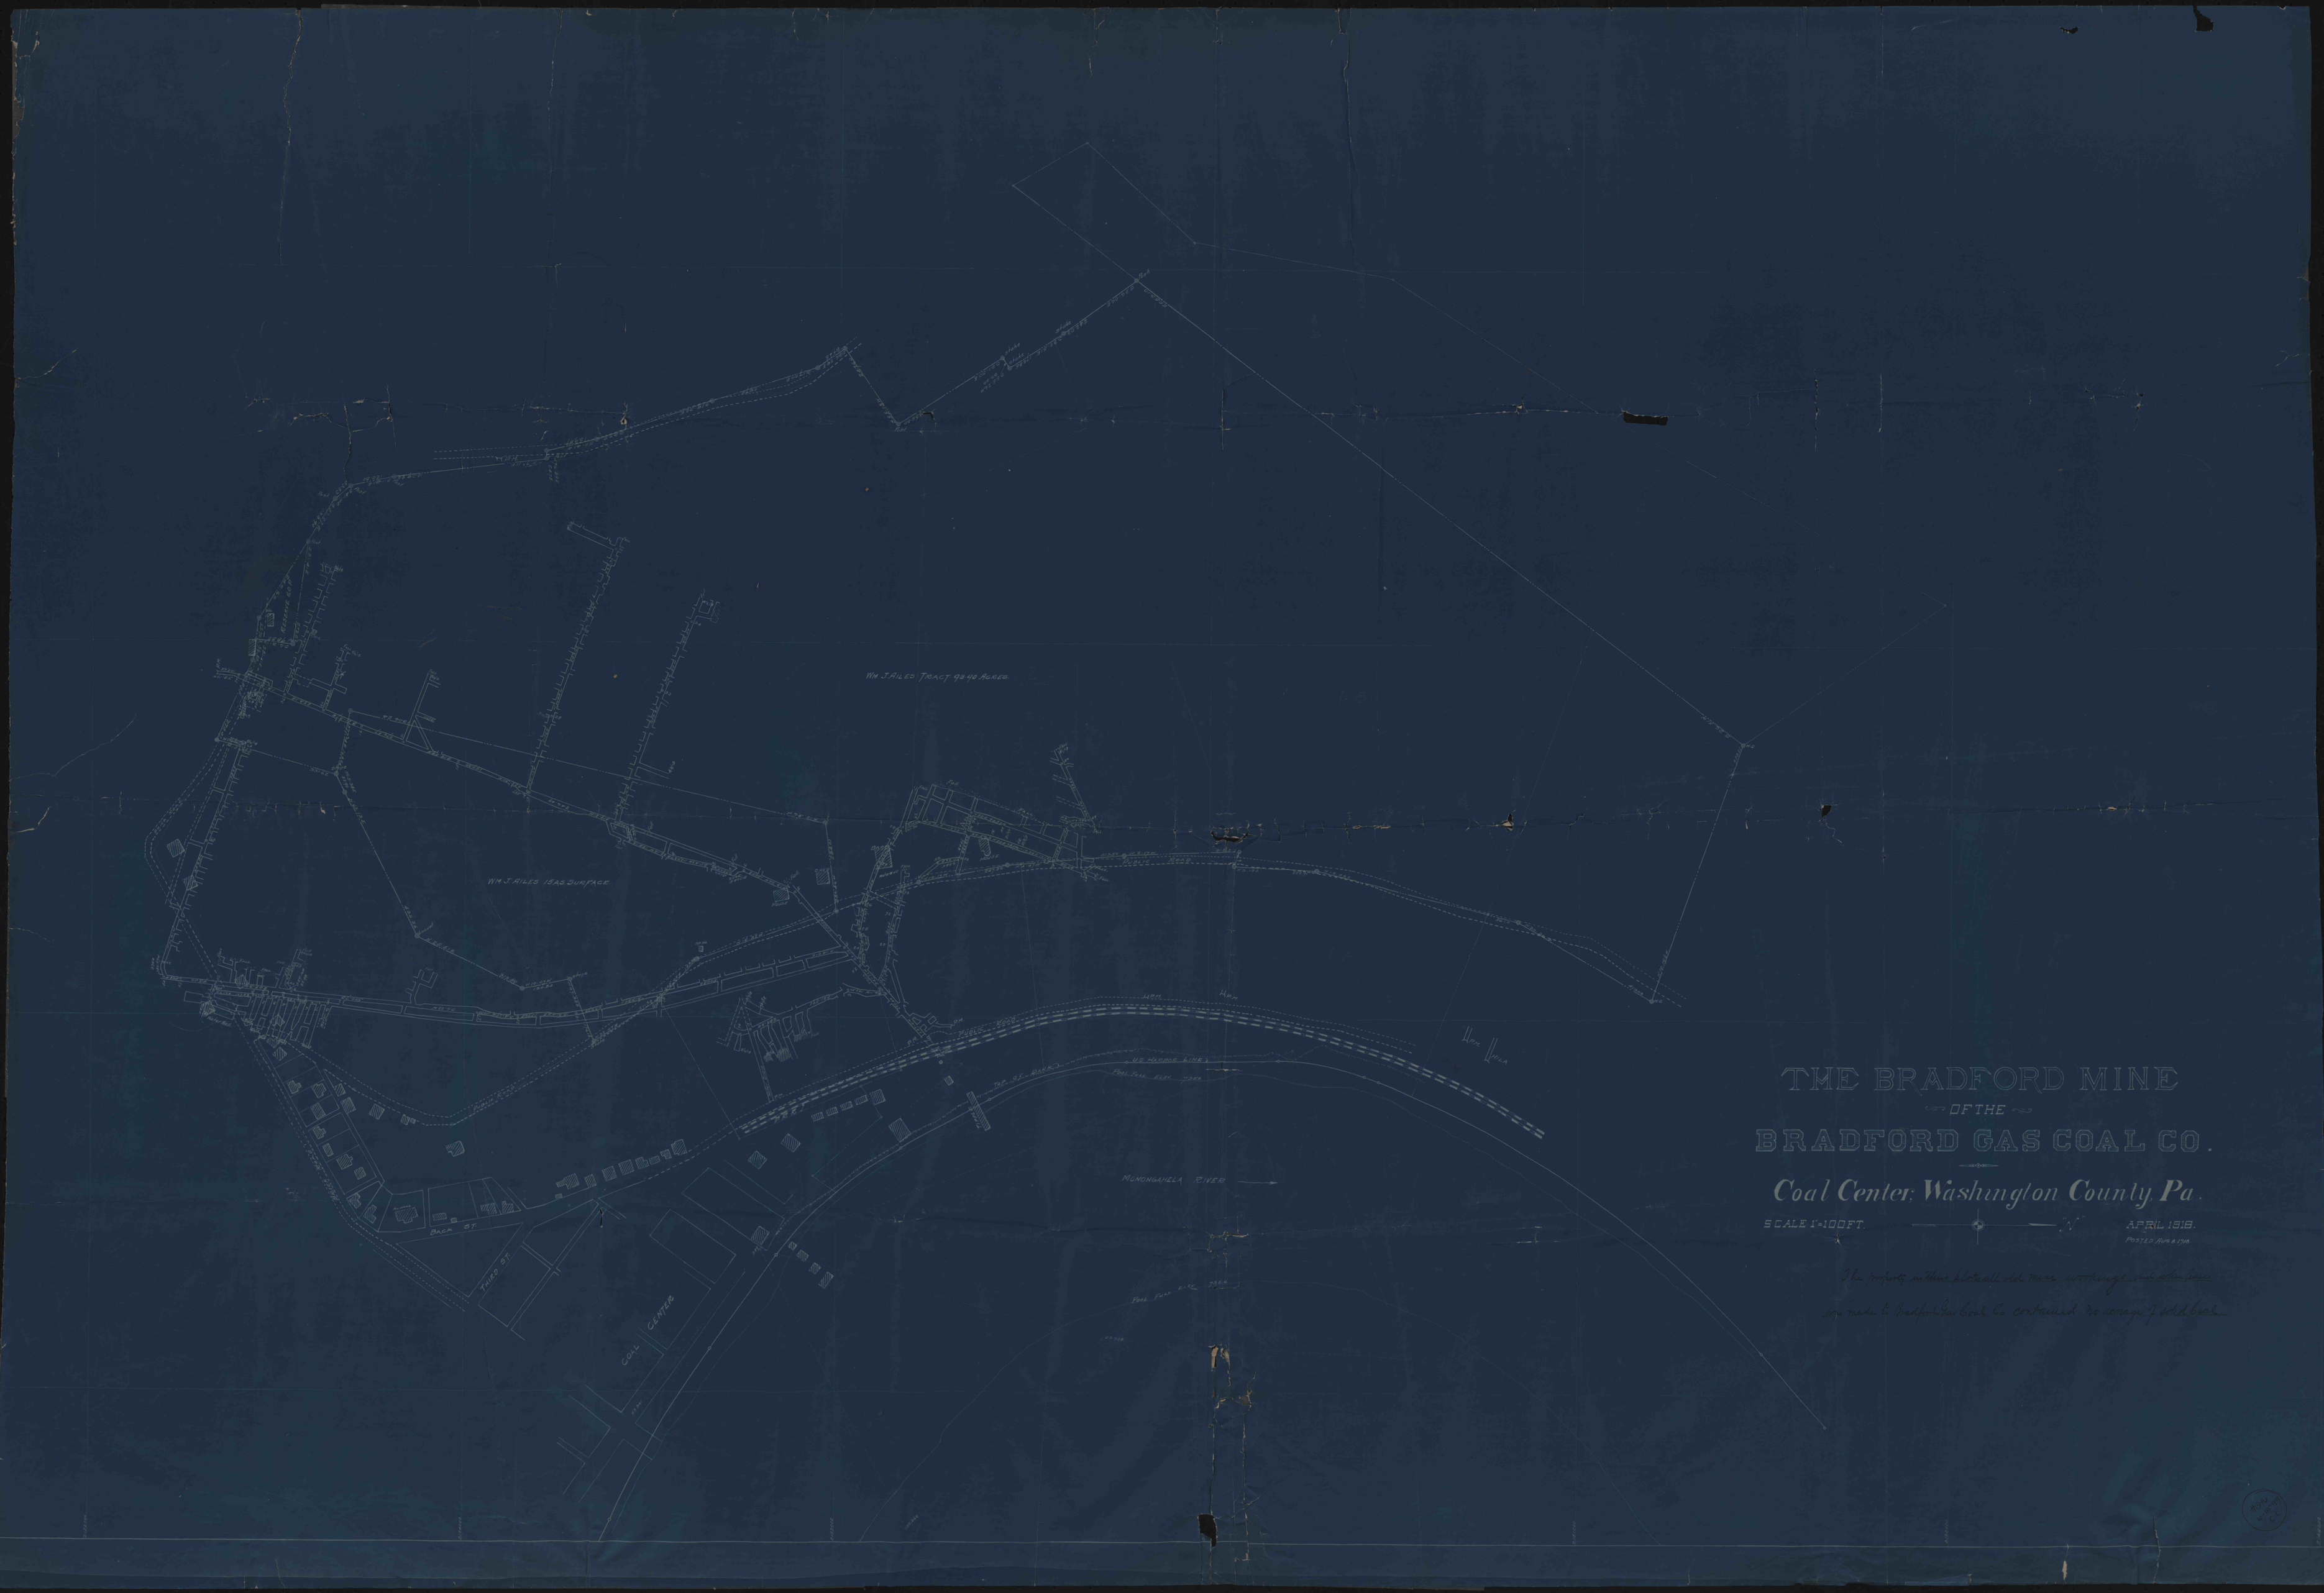
WM. J. AILES TRACT 93.42 ACRES
WM. J. AILES 15 AS SURFACE
MONONGAHELA RIVER
COAL CENTER
BACK ST.
THIRD ST.
THE BRADFORD MINE
OF THE
BRADFORD GAS COAL CO.
Coal Center, Washington County, Pa.
SCALE 1"=100 FT.
"N"
APRIL 1918.
POSTED AUG. 8 1918.
The property in these plates all old mine workings and when lease was made to Bradford Gas Coal Co. contained no acreage of solid coal.