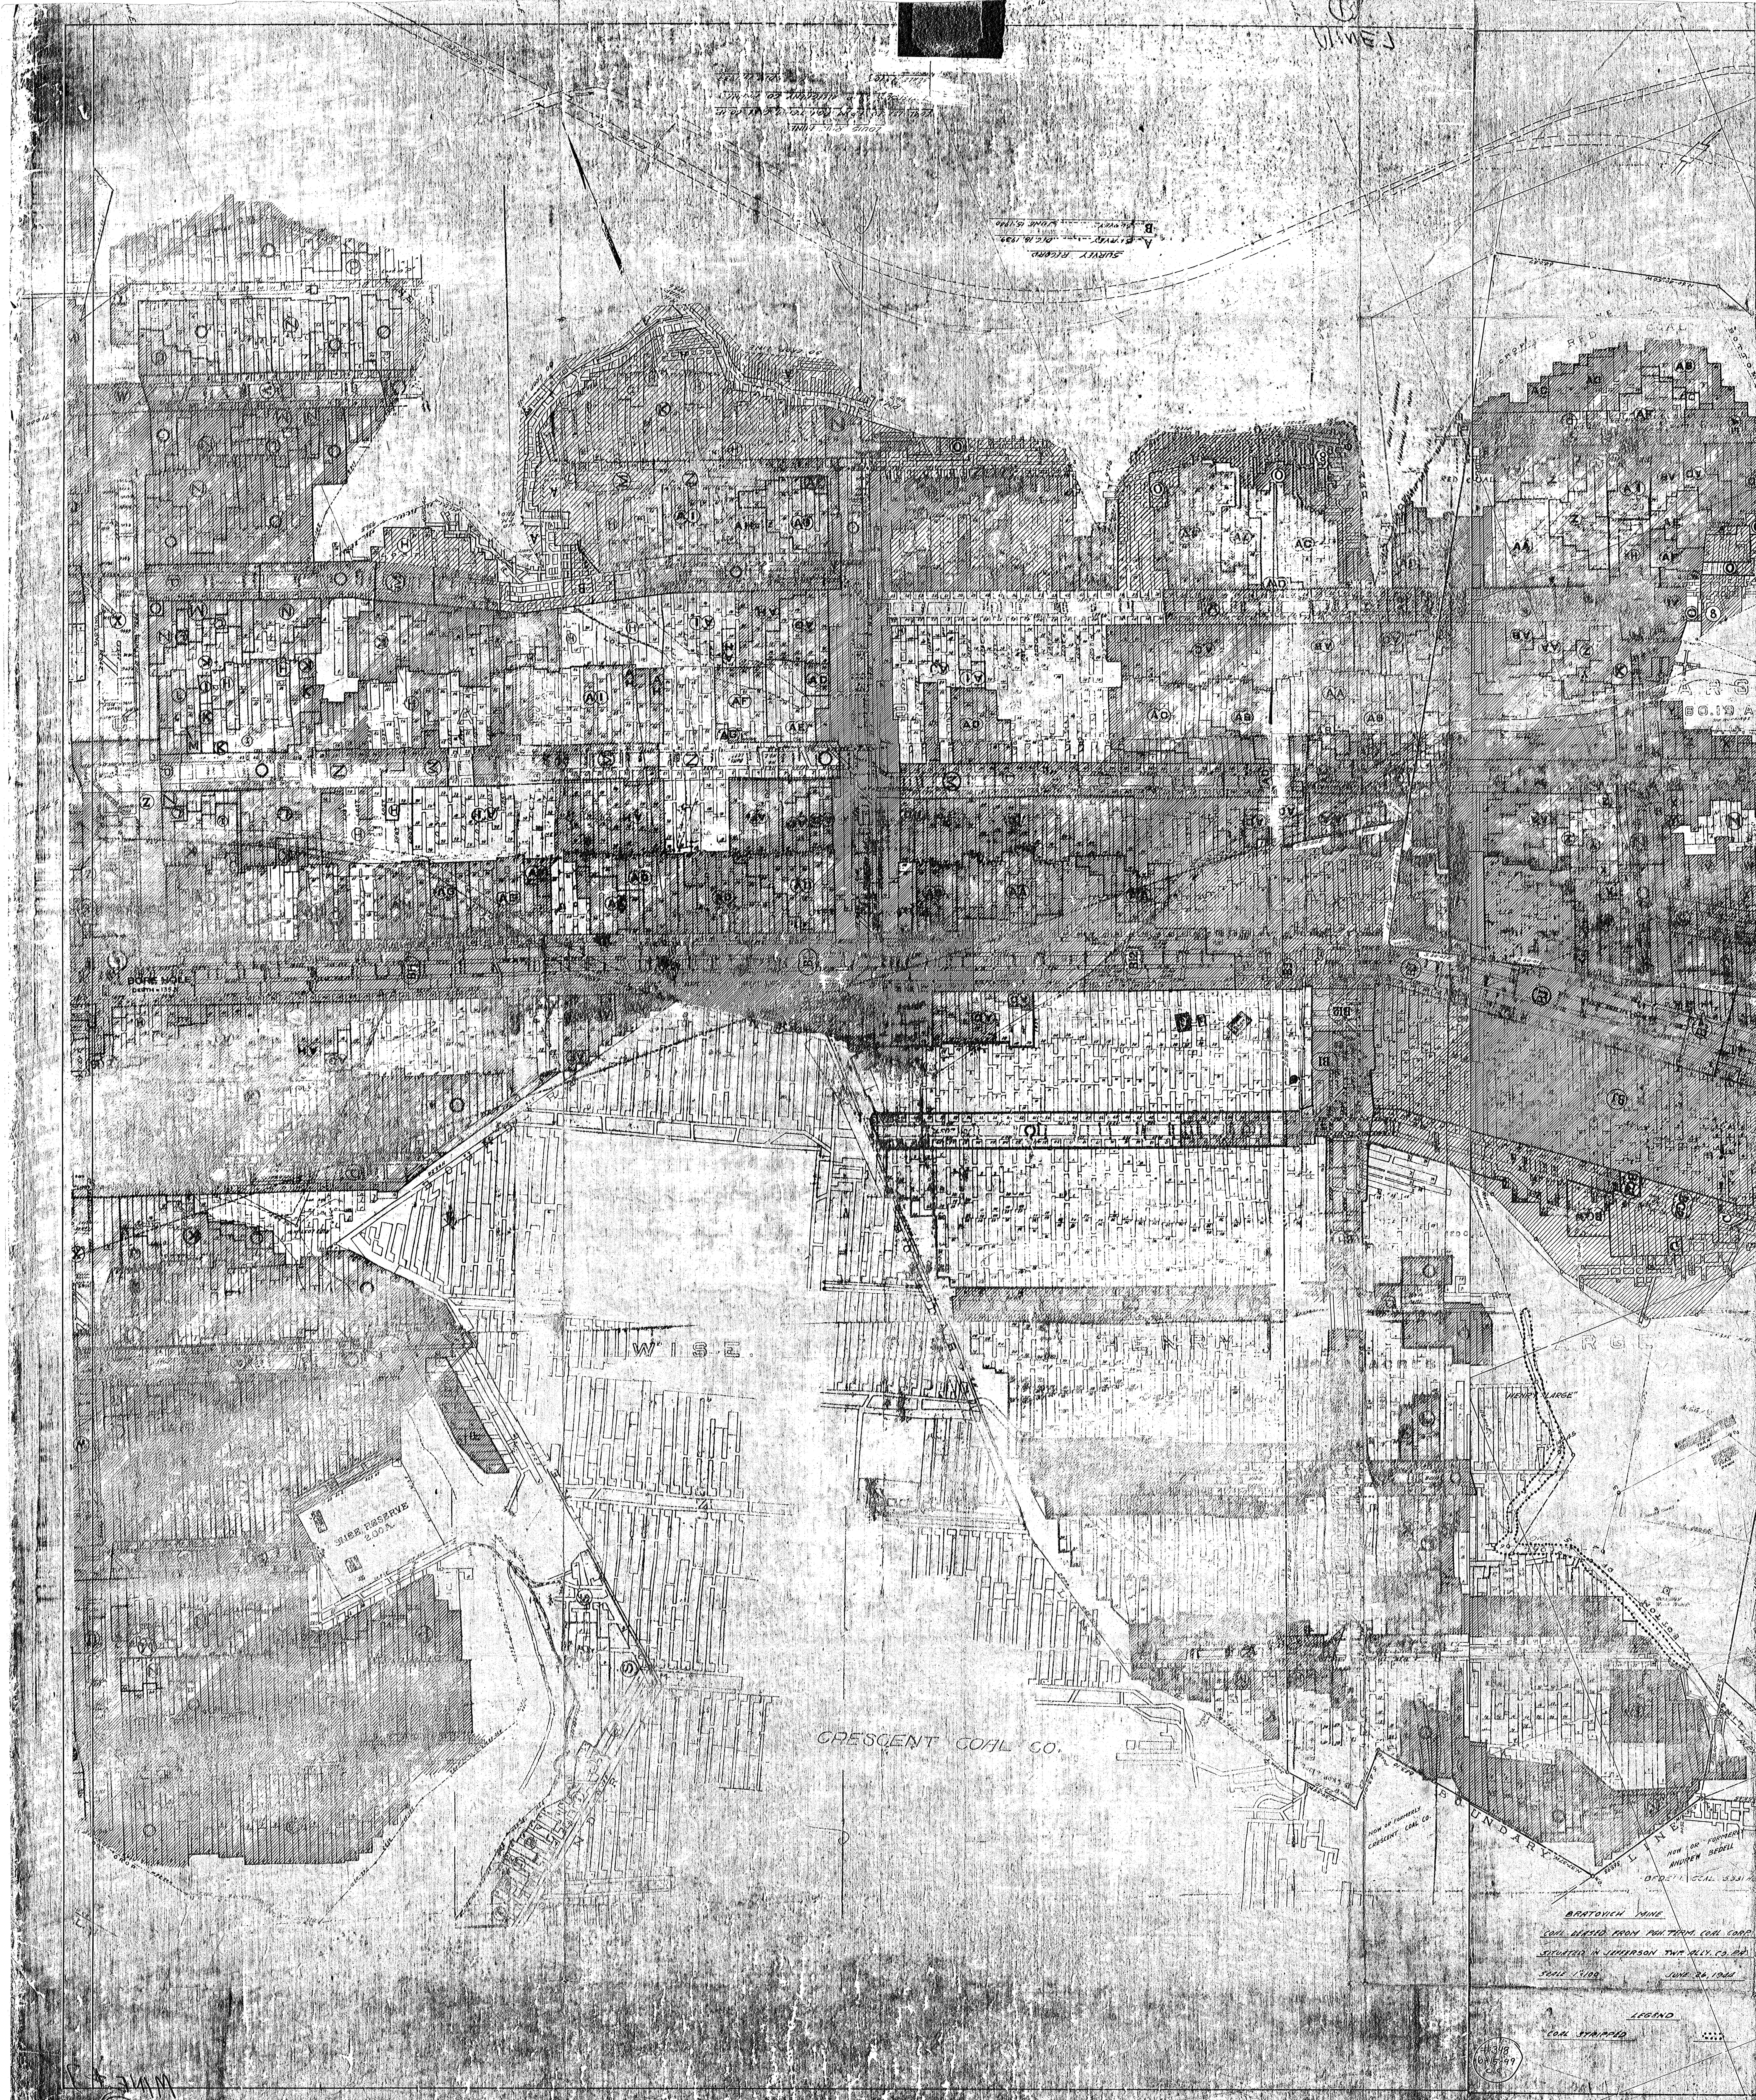
SURVEY RECORD
A. SURVEY DEC 18, 1939
B. SURVEY JUNE 15, 1940
CROP RED COAL
BOTTOM
RED COAL
60.19 A
BORE HOLE
DEPTH = 135.3
WISE
HENRY
ACRES
HENRY LARGE
LARGE
SHEE RESERVE 2.00 A.
CRESCENT COAL CO.
NOW OR FORMERLY CRESCENT COAL CO.
BOUNDARY LINE
NOW OR FORMERLY ANDREW BEDELL
BEDELL COAL 3.331 A
N.37-37W
369.93
TORN DOWN
TORN DOWN
LEWIS

BRATOVICH MINE

COAL LEASED FROM PGH. TERM. COAL CORP.
SITUATED IN JEFFERSON TWP. ALLY. CO. PA.
SCALE 1"=100'
JUNE 26, 1944

LEGEND

COAL STRIPPED ⁘

#348
6-15-99
C.C.

MINE 47