

N 39,000

SURFACE: SEWICKLEY COAL: GEORGE EBERHART

SURFACE: SEWICKLEY COAL: ERNEST EVERY

DUNKARD CREEK

PAVED L.P. 30020

SEWICKLEY COAL - OUTCROP

FLOW

SEWICKLEY SEAM ABSENT

ORIGINAL SEWICKLEY SEAM OUTCROP

ABANDONED DEAN MINE (NO WORKINGS ON THIS SHEET)

SURFACE: HERSCHEL MATHEWS
SEWICKLEY COAL: TARGET INDUSTRIES INC

AREA STRIP MINED BY GENOVESE COAL COMPANY

N 38,000

OVER 200 FEET WEST TO CLOSEST OLD MINE ENTRY OF THE ABANDONED DEAN MINE

SURFACE: ART BENNETT
SEWICKLEY COAL: ERNEST EVERY
17.258 AC

SURFACE: ART BENNETT
SEWICKLEY COAL: ERNEST EVERY

SURFACE: SHANNON MINING CO
SEWICKLEY COAL: J & L STEEL CO

ORIGINAL SEWICKLEY SEAM OUTCROP

200' OUTCROP BARRIER

6" GAS LINE

100' COVER LINE

200' FOOT DRILL LINE

50' MINE PROPERTY BARRIER

13 ABAND HOUSE

SURFACE: ART BENNETT
SEW. COAL: J & L STEEL CO


1987 EMILIO MINE

UNPAVED L.P. 30020

FINAL MAP

SHEET NO. 2

Tri-Ent Inc.
Bren-Mar Mine
Dunkard Twp.; Greene Co.; PA
Scale 1"=100 Ft.

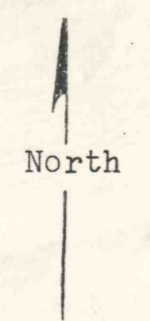

Robert Emery
April 13, 1991

#352
L-15-99
C.C.