


#2902  
6-15-99  
CC

FINAL MAP  
SHEET NO. 3

Tri-Ent Inc.  
Bren-Mar Mine  
Dunkard Twp.; Greene Co.; PA  
Scale 1"=100 Ft.

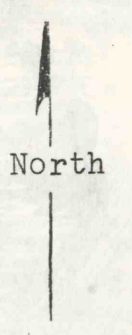

Revised  
April 13, 1999



SEWICKLEY COAL  
DUQUESNE LIGHT CO  
WARWICK MINE PORTAL NO. 3  
SURFACE:  
JAMES ABEL

100' ADJACENT MINE BARRELS  
200' DRILL LINE

SEWICKLEY COM.  
J&L STEEL CO

TITUS STREET  
HOUSES INDIVIDUALLY OWNED

LARIMER AVENUE

SEWICKLEY COAL: J&L STEEL CO

FRANKLIN AVENUE

STORE

BOBTOWN SCHOOL

WAS CHURCH  
HOW HEALTH CENTER

VILLAGE OF BOBTOWN PA

60% MINING  
SURFACE: SHANNON MINING  
SEW. COAL: J&L STEEL CO