

CHRIS O'DONNELL HRS.
 P. H. ZIMMEL COAL
 N O W
 NORTH OAKLAND SPEEDWAY INC.
 SURFACE
 P. H. ZIMMEL FEE

DENNIS O'DONNELL HRS.
 N O W
 J. J. O'DONNELL
 FEE 41.7-AC

NORMAN AND IRMA MACDONALD
 FEE 74.00-AC

LEO BRESNAHAN
 NOW
 C. G. MCCORMICK
 FEE 145 AC

HAROLD CUMBERLAND
 RESERVE 1/2-AC.
 GEO. FREDERICK HRS.


- LEGEND
- 10-2-68-4-2-69 [Red outline] CONTEMPLATED MINING AREA
 - [Orange outline] SUPPORT AREA
 - [Green outline] PROTECTED STRUCTURES
 - [Green outline] MINING COMPLETED AREA

SURVEYED

JUNE	18	1949
JAN.	14	1950
JULY	17	1950
JAN.	20	1951
JAN.	18	1954
AUG.	15	1955
AUG.	18	1955
OCT.	2	1962
JAN.	18	1965
SEP.	20	1966
MAR	9	1967
OCT	17	1967
MAR	14	1968
OCT.	2	1968

PROJECTION MAP
 FREDERICK & MCCORMICK COAL CO.
 BRESNAHAN MINE
 UPPER FREEPORT COAL
 DONEGAL TWP. BUTLER CO. PA.
 SCALE 1"=100'
 PERMIT 274-H

FIELD COPY
 JUNE 23 1949
 E. J. WEIBEL R.S. 6572

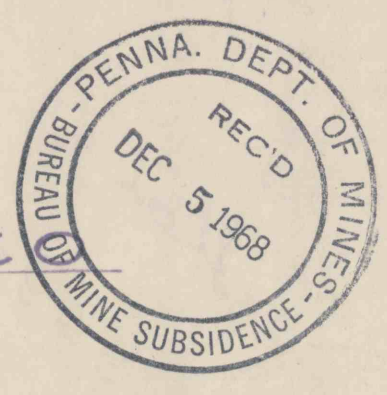

#353
 6-15-99
 C.C.