

P. J. O'DONNELL HRS.
BUTLER CONSOLIDATED

PATRICK NORRIS

COAL CO.

CHRIS. O'DONNELL HRS.
ZIMMELL

NORMAN AND IRMA MacDONALD
LEASE

DENNIS O'DONNELL HRS.

LEO BRESNAHAN

GEO. FREDERICK HRS.

HAROLD CUMBERLAND

RESERVE 1/2 AC.

- LEGEND
- BOUNDARY LINES
 - COMPLETED MINING
 - PROPOSED MINING 6 MOS. 24 AC
 - BUILDING SUPPORT

FEB - 4 - 1967

SUBSIDENCE MAP

FREDERICK & McCORMICK COAL CO.


UPPER FREEPORT VEIN
DONEGAL TWP. BUTLER CO. PA

Scale 1" = 100'

June 21 1949

BRESNAHAN MINE

Note -
Surveyed 9-20-66
Proposed Development

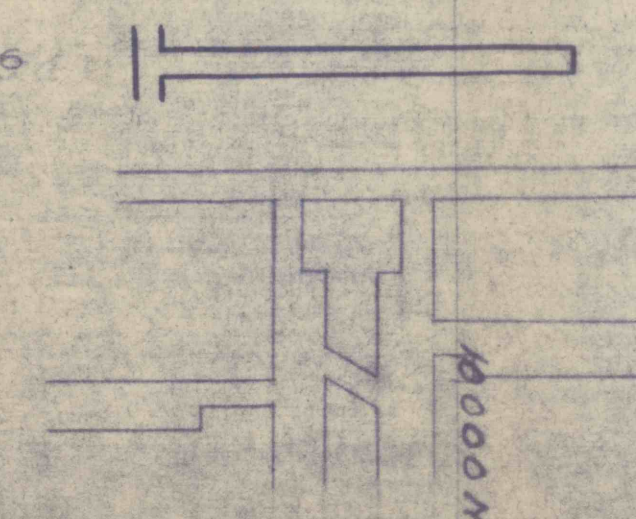

E. J. Weichel