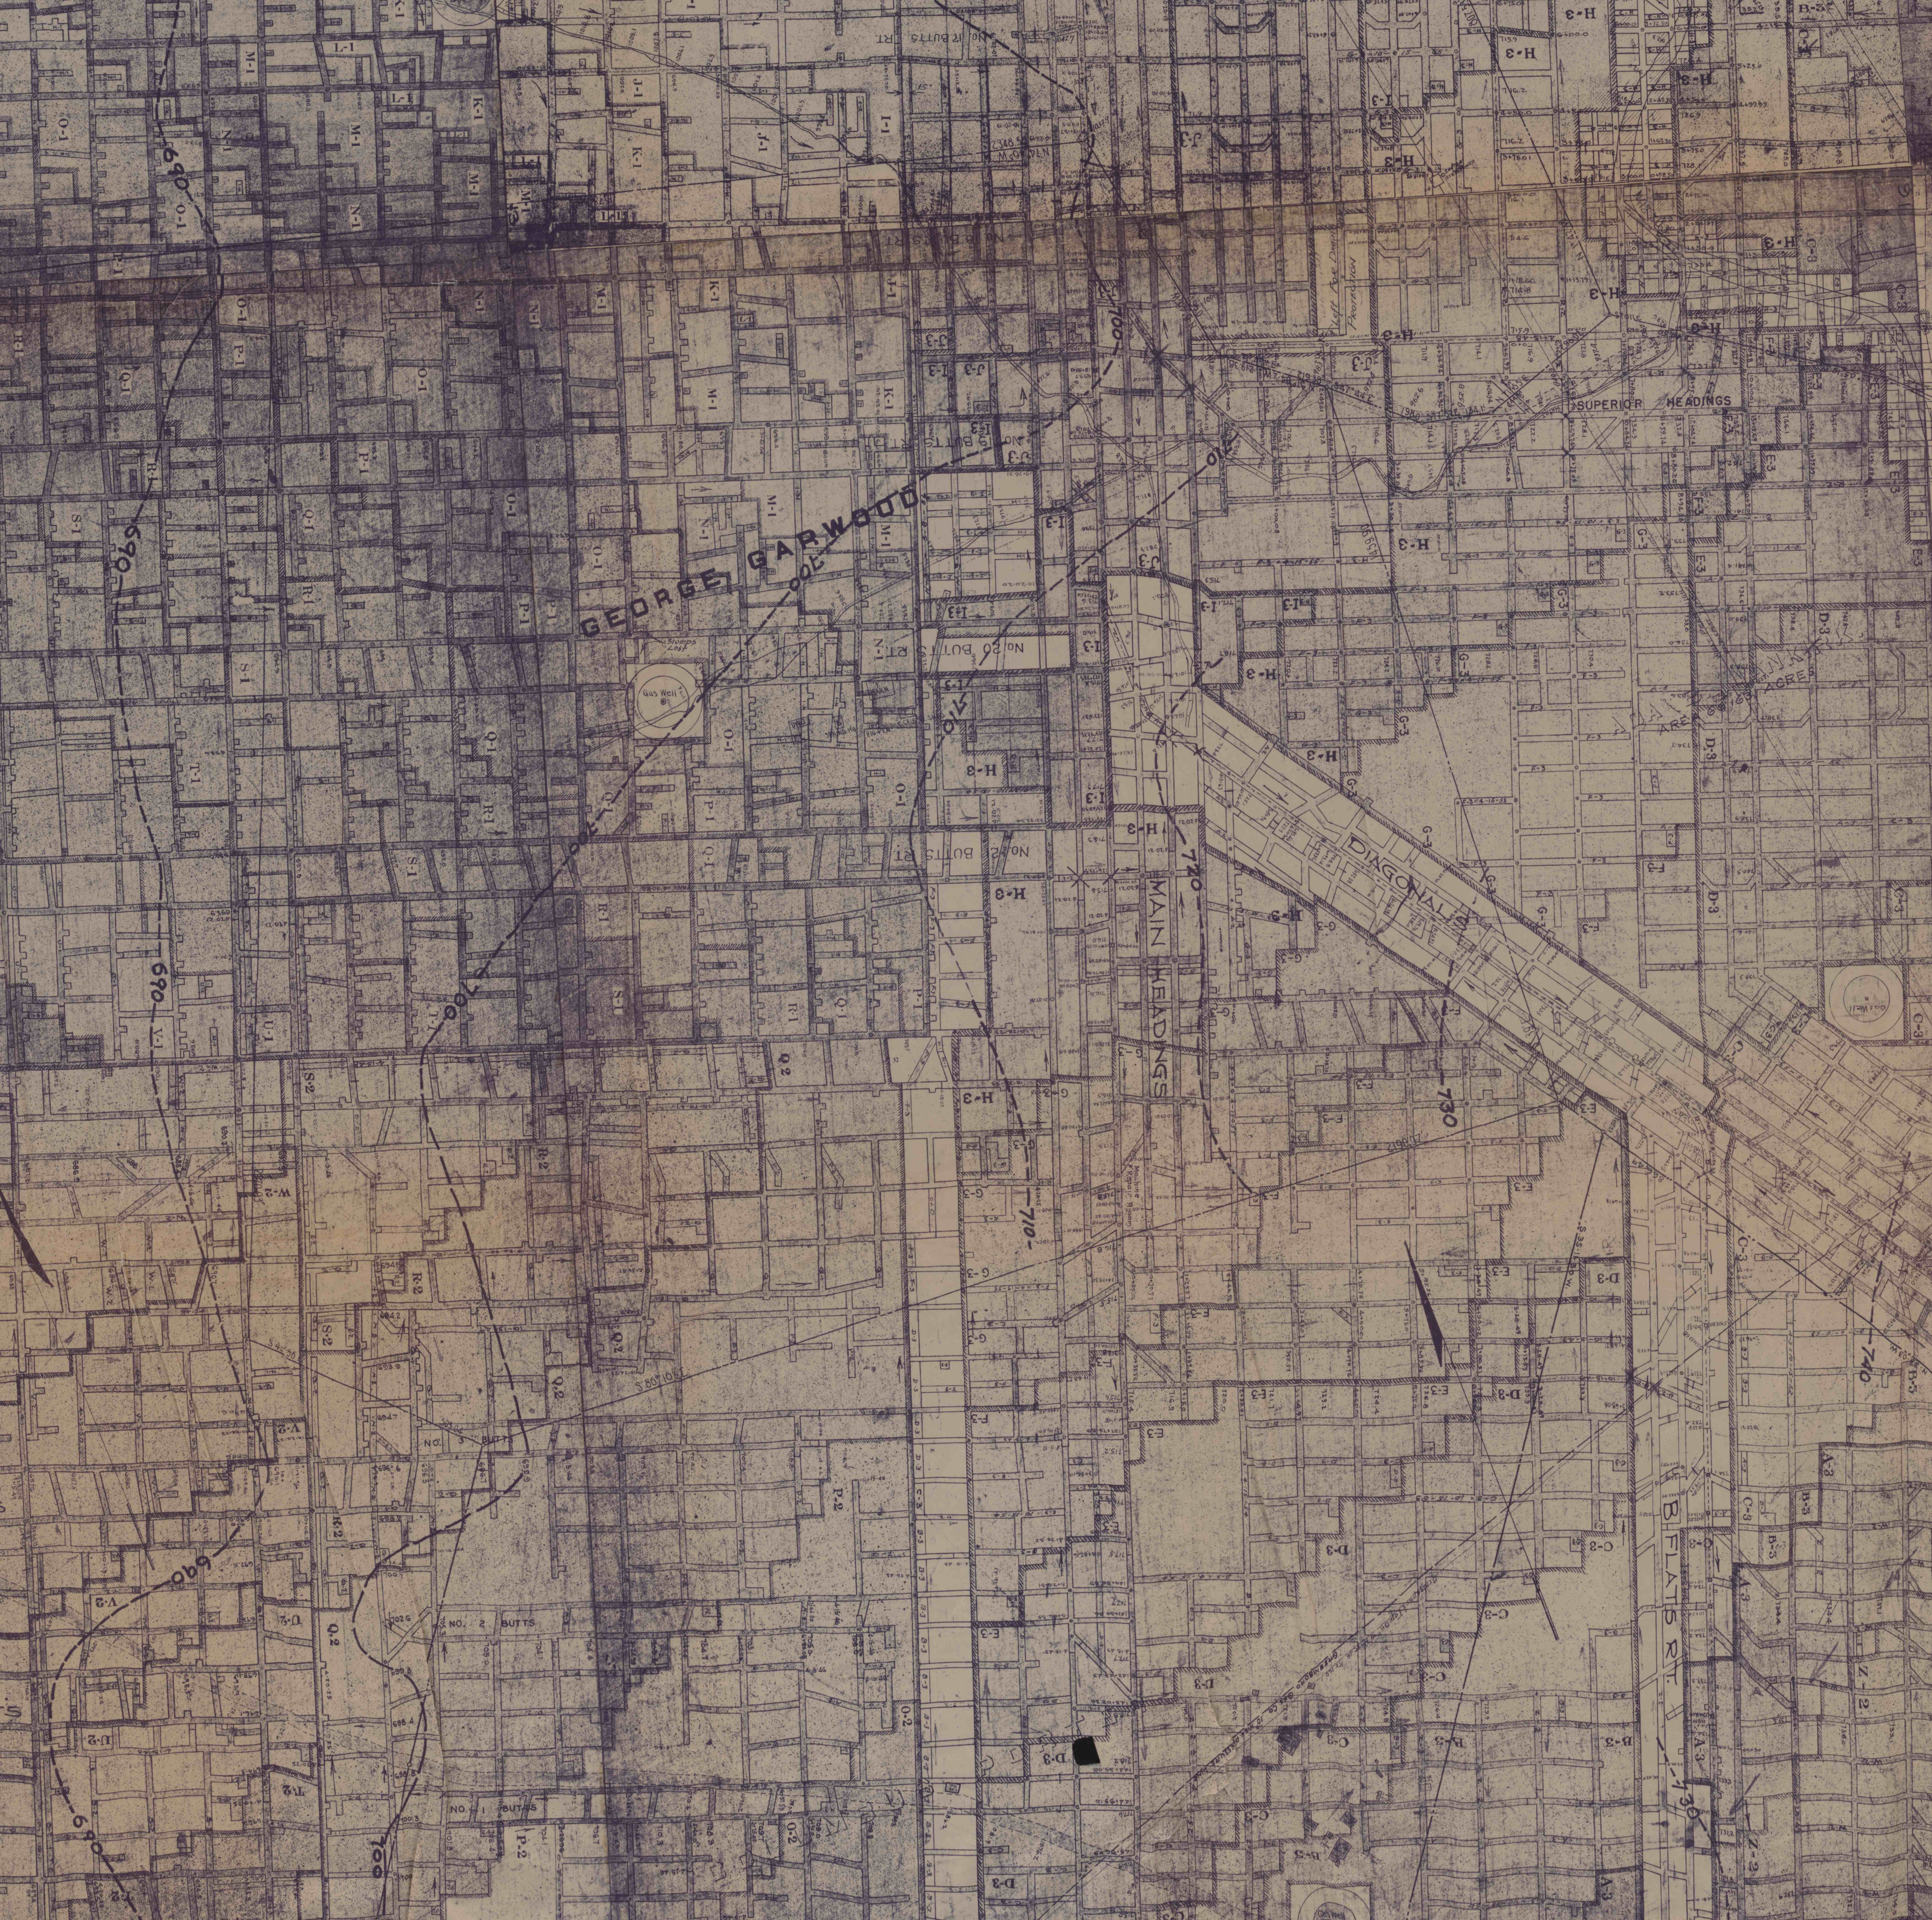
GEORGE GARWOOD
SUPERIOR HEADINGS
MAIN HEADINGS
DIAGONAL
B FLATS RT.
No 12 BUTTS RT
No 18 BUTTS RT
No 19 BUTTS RT
No 20 BUTTS RT
No 2 BUTTS RT
NO. 3 BUTTS
NO. 2 BUTTS
NO. 1 BUTTS
Gas Well
Stumps Lost
Left For Drain Protection
Machine & Repair Room
AREA 69.63 ACRES