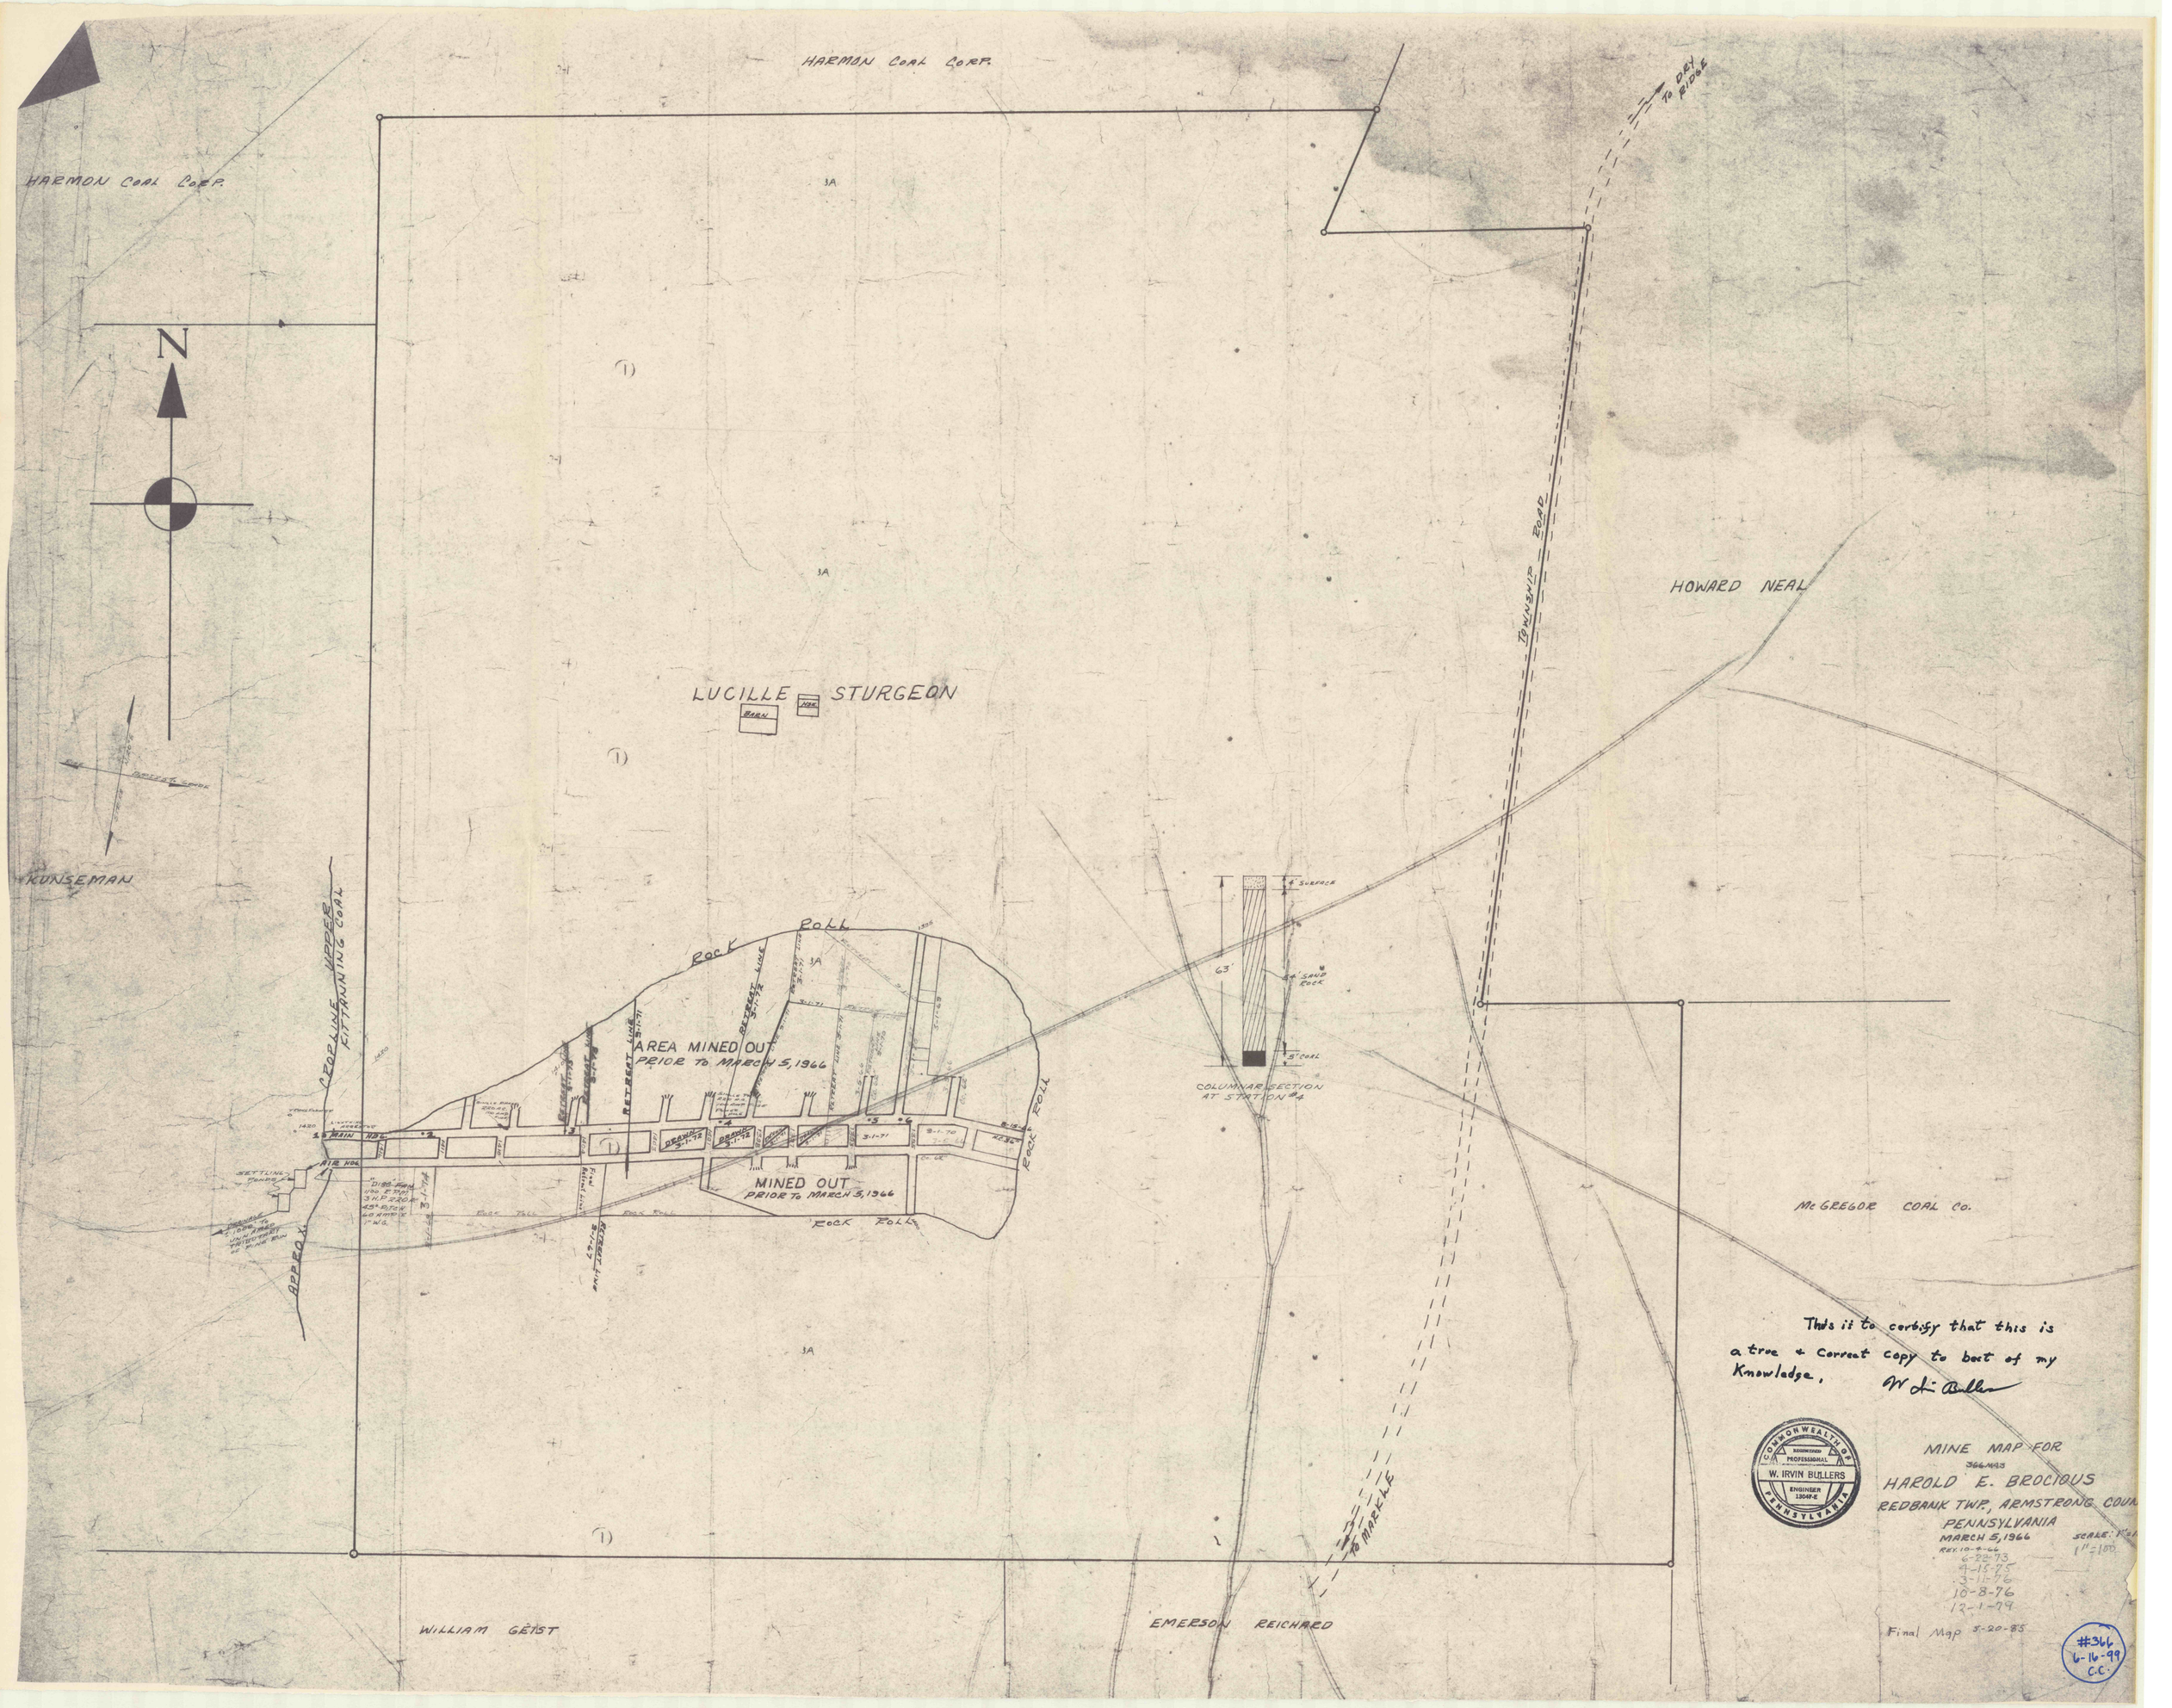
HARMON COAL CORP.
HARMON COAL CORP.
N
TO DRY RIDGE
TOWNSHIP ROAD
HOWARD NEAL
LUCILLE STURGEON
BARN
HSE
KUNSEMAN
CROPLINE UPPER FITTANNING COAL
ROCK ROLL
AREA MINED OUT PRIOR TO MARCH 5, 1966
MINED OUT PRIOR TO MARCH 5, 1966
RETREAT LINE
ROCK ROLL
APPROX.
COLUMNAR SECTION AT STATION #4
McGREGOR COAL CO.
TO MARKLE
WILLIAM GEIST
EMERSON REICHARD
This is to certify that this is a true & Correct copy to best of my Knowledge.
W. Irvin Bullers
COMMONWEALTH OF PENNSYLVANIA
REGISTERED PROFESSIONAL
W. IRVIN BULLERS
ENGINEER
13047-E
MINE MAP FOR
366MA3
HAROLD E. BROCIOUS
REDBANK TWP., ARMSTRONG COUN
PENNSYLVANIA
MARCH 5, 1966
REV. 10-4-66
6-22-73
4-15-75
3-11-76
10-8-76
12-1-79
SCALE: 1"=1
1"=100
Final Map 5-20-85
#366
6-16-99
C.C.