



Map

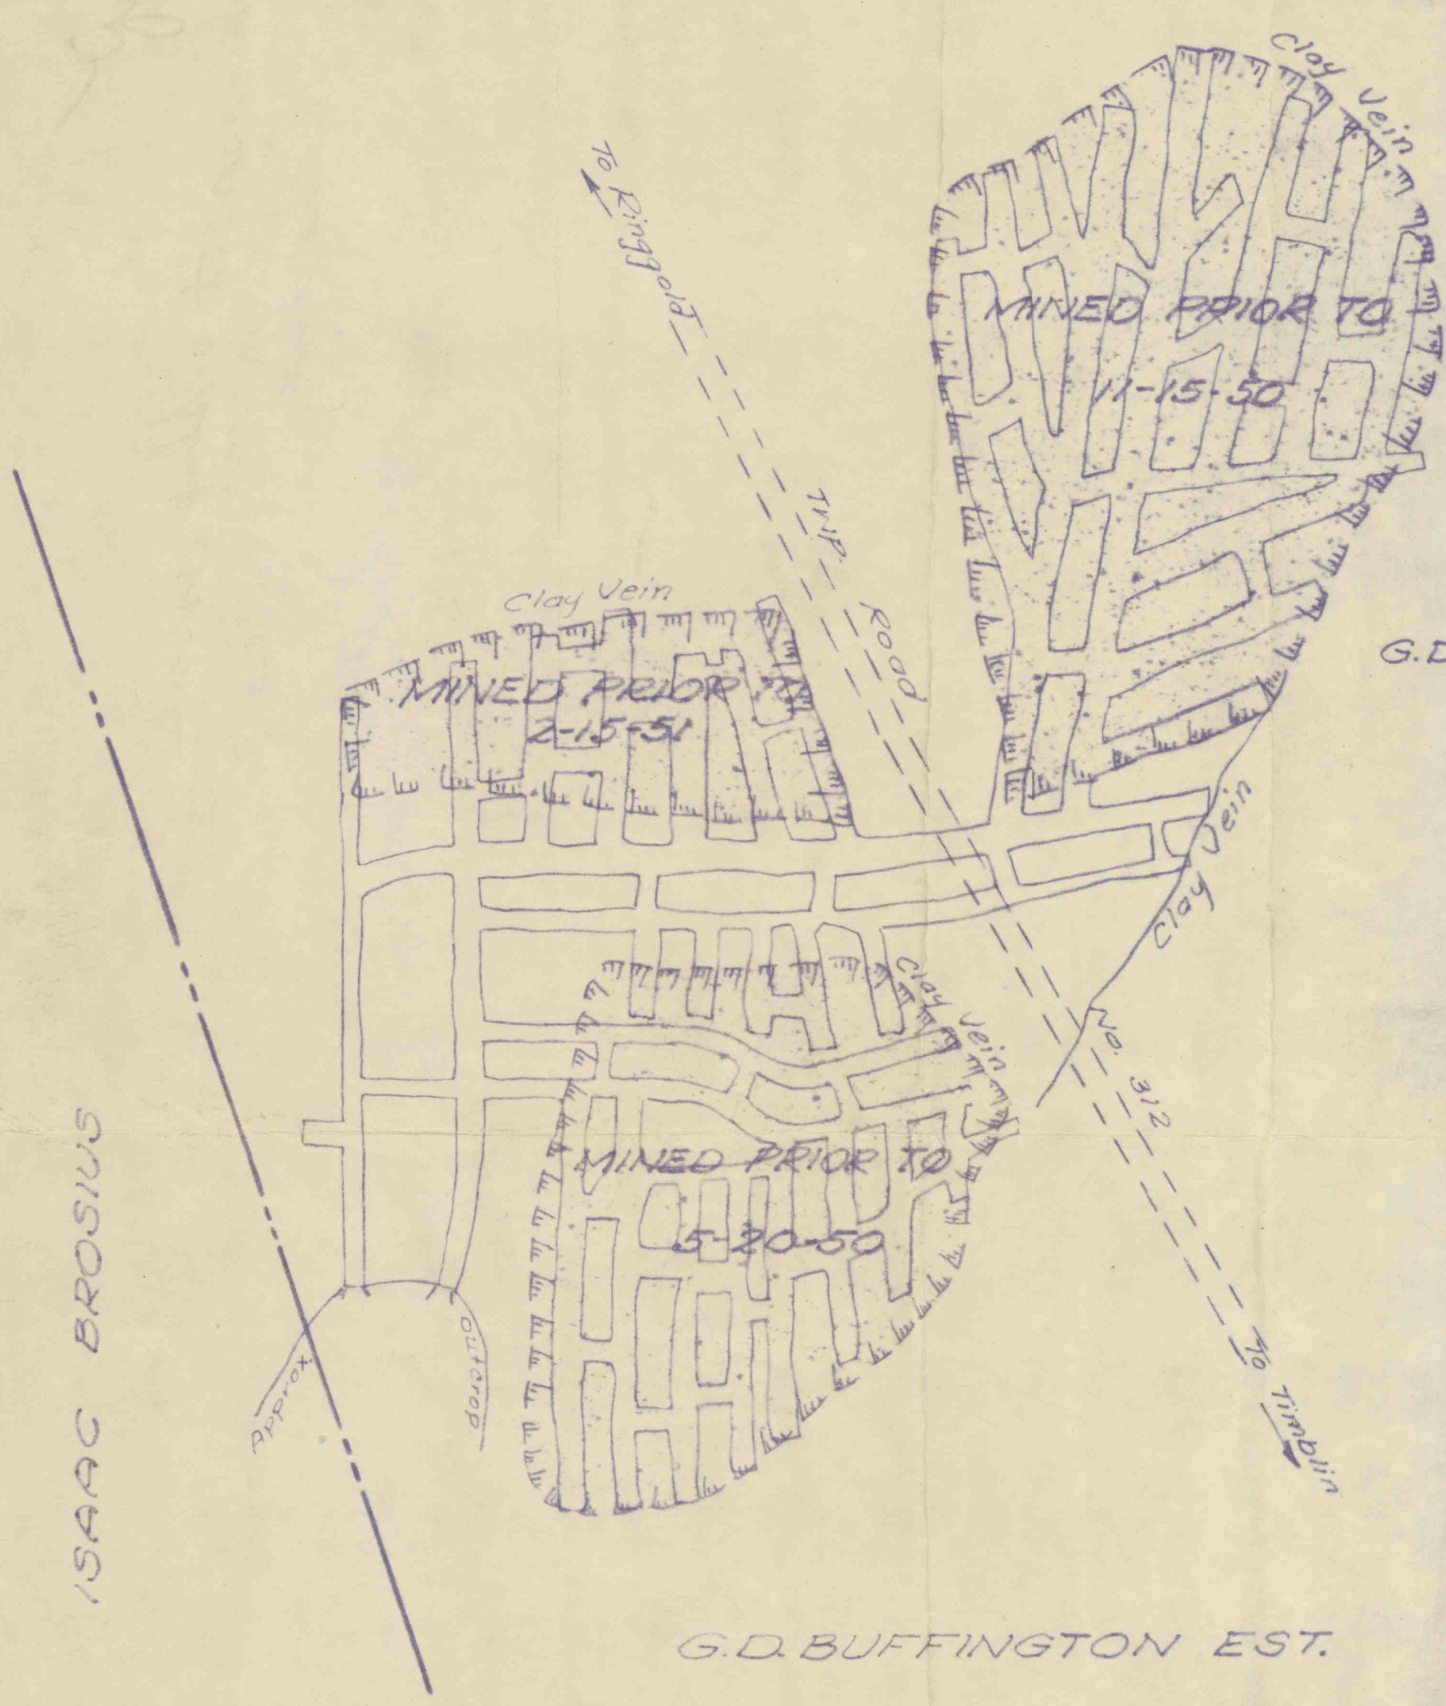

G.D. BUFFINTON EST.

G.D. BUFFINTON EST.

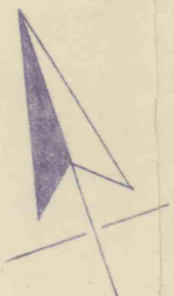

MINE MAP  
 HAROLD E. BROCIOSUS  
 RINGGOLD TWP. JEFFERSON CO., PA.  
 SCALE 1"=100' MAY 1952  
 Walter J. Zimmerman-Surveyor-Engineer-Funkstown, Pa.

I hereby certify that this is a true and correct copy of the original map of the Harold E. Brocius mine, and that the original map is a true and complete map of the excavations made in said mine.

Walter J. Zimmerman  
 Reg. Engineer-Surveyor No 4340

County of Jefferson, Commonwealth of Pennsylvania, S.S.  
 Before me, a Notary Public in and for the said county, personally appeared Walter J. Zimmerman, who, being duly affirmed says that the above statements are true and correct to the best of his knowledge and belief.

E. Leonard Gray Snyder  
 Notary Public  
 My Com. expires Jan 7, 1953

12th Bit, Lish  
 G. J. Kaim, Inspt

#367  
 6-16-99  
 C.C.