


FIT TO 1

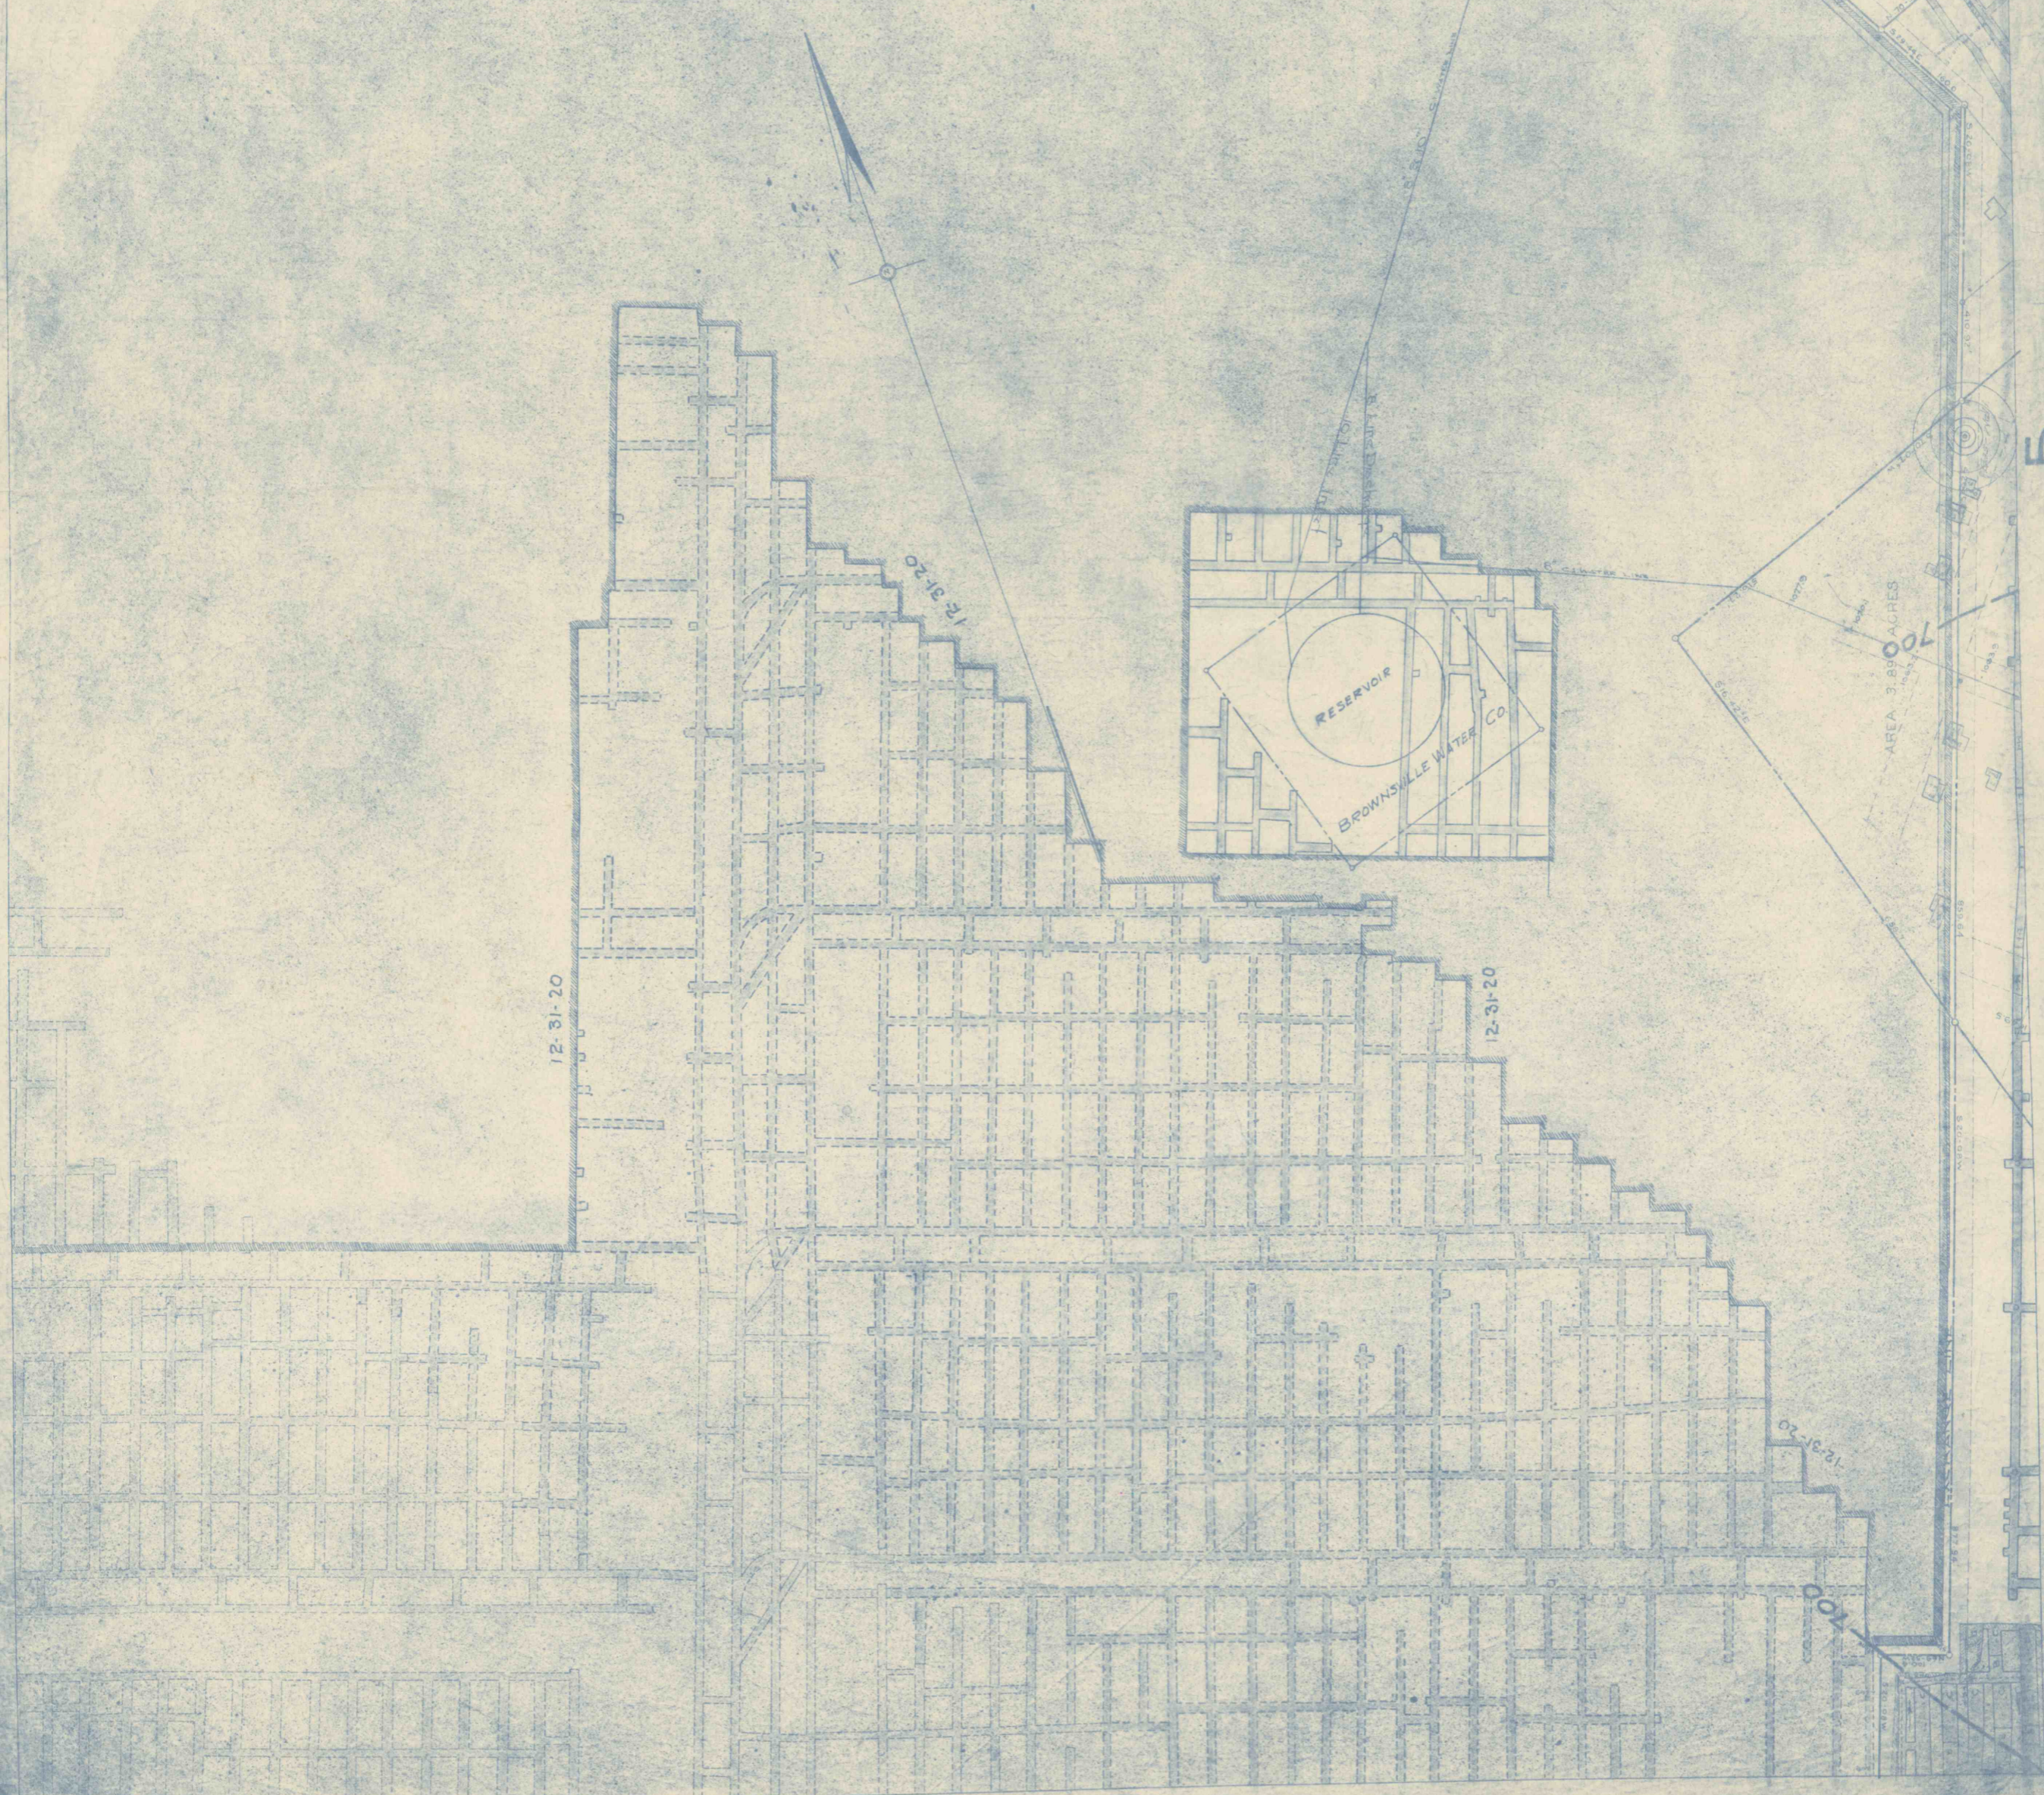

BRIDGEPORT 4



FIT TO 5

BRIDGEPORT 4

FIT TO 8