
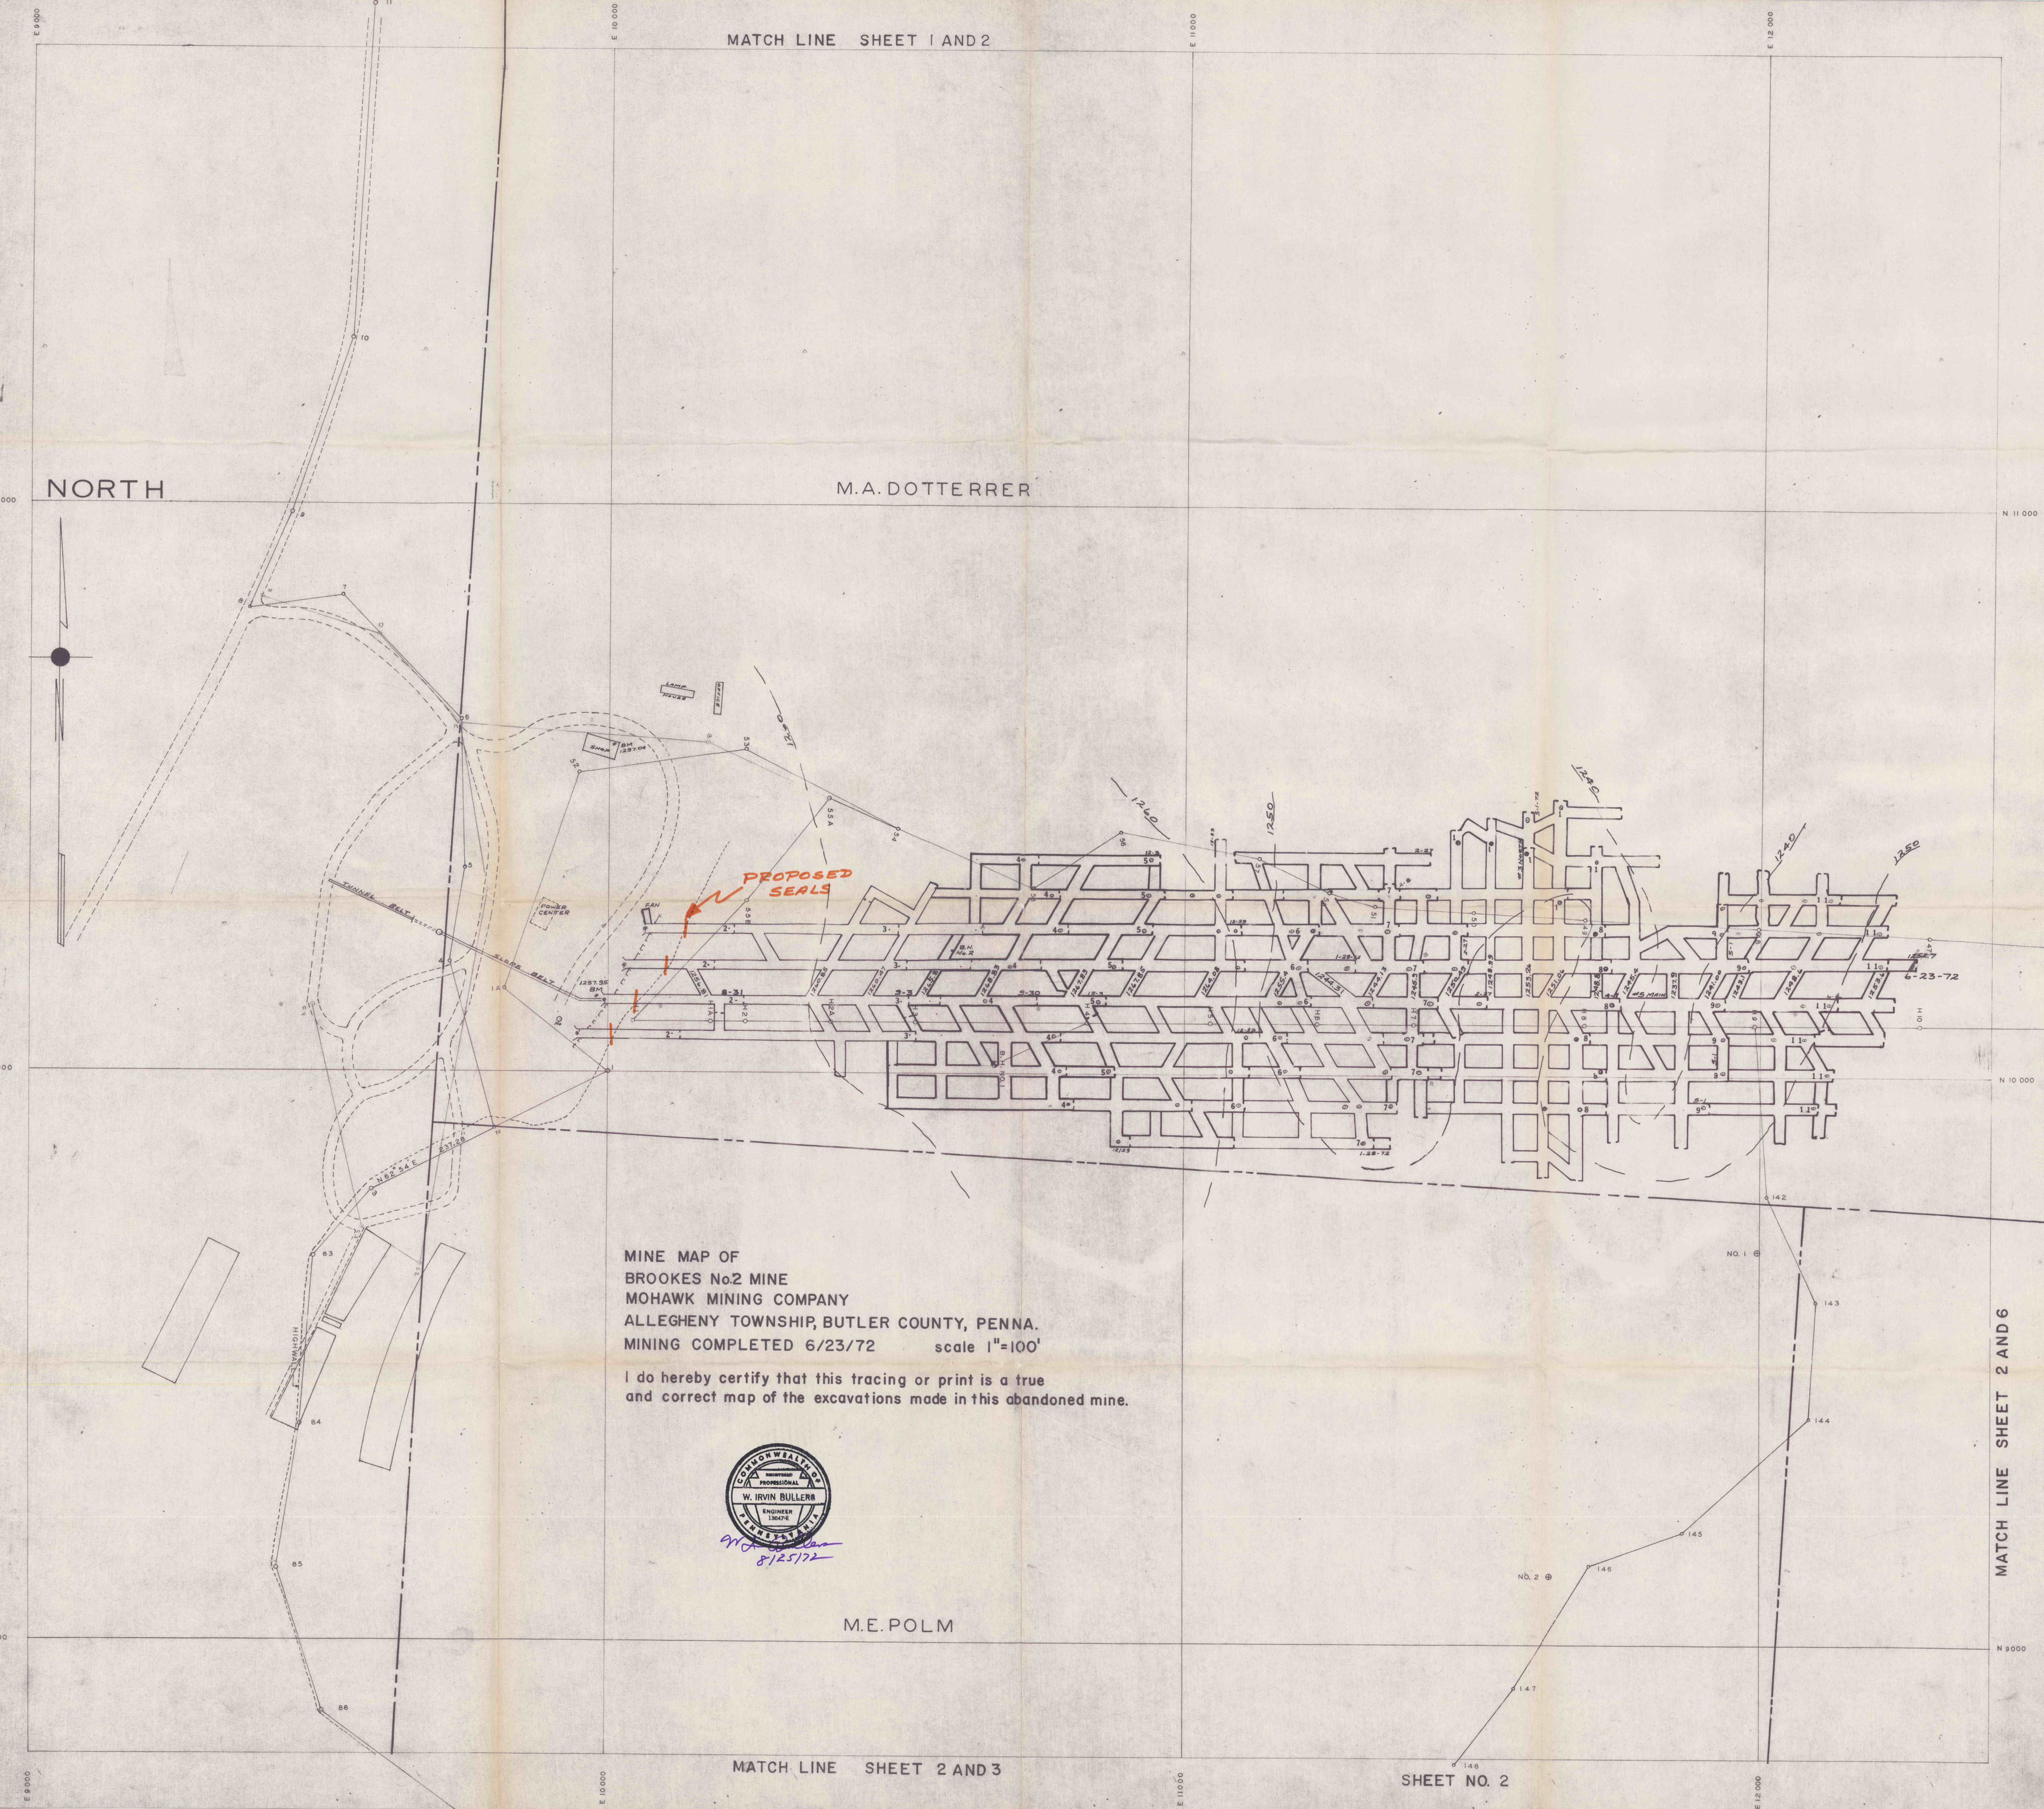



NORTH

M.A. DOTERRER

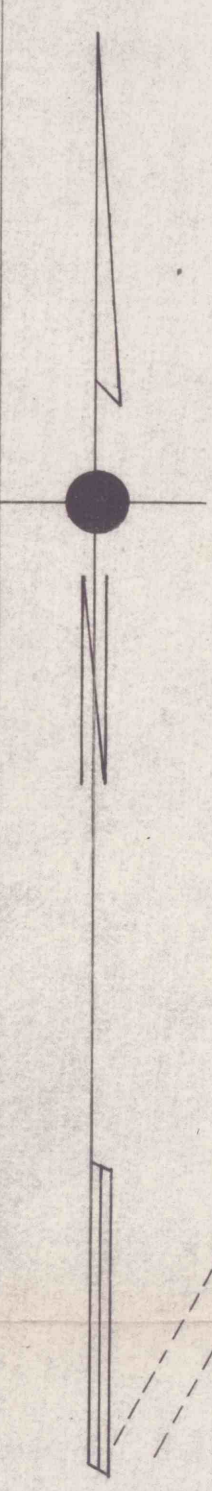

MINE MAP OF
BROOKES No2 MINE
MOHAWK MINING COMPANY
ALLEGHENY TOWNSHIP, BUTLER COUNTY, PENNA.
MINING COMPLETED 6/23/72 scale 1"=100'

I do hereby certify that this tracing or print is a true
and correct map of the excavations made in this abandoned mine.

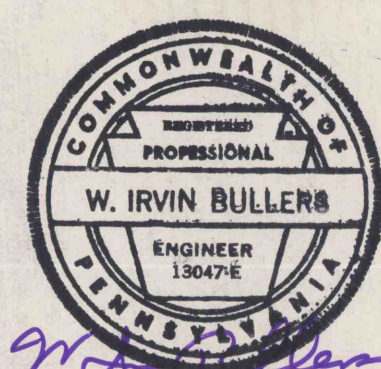

WIC
8/25/72

M.E. POLM