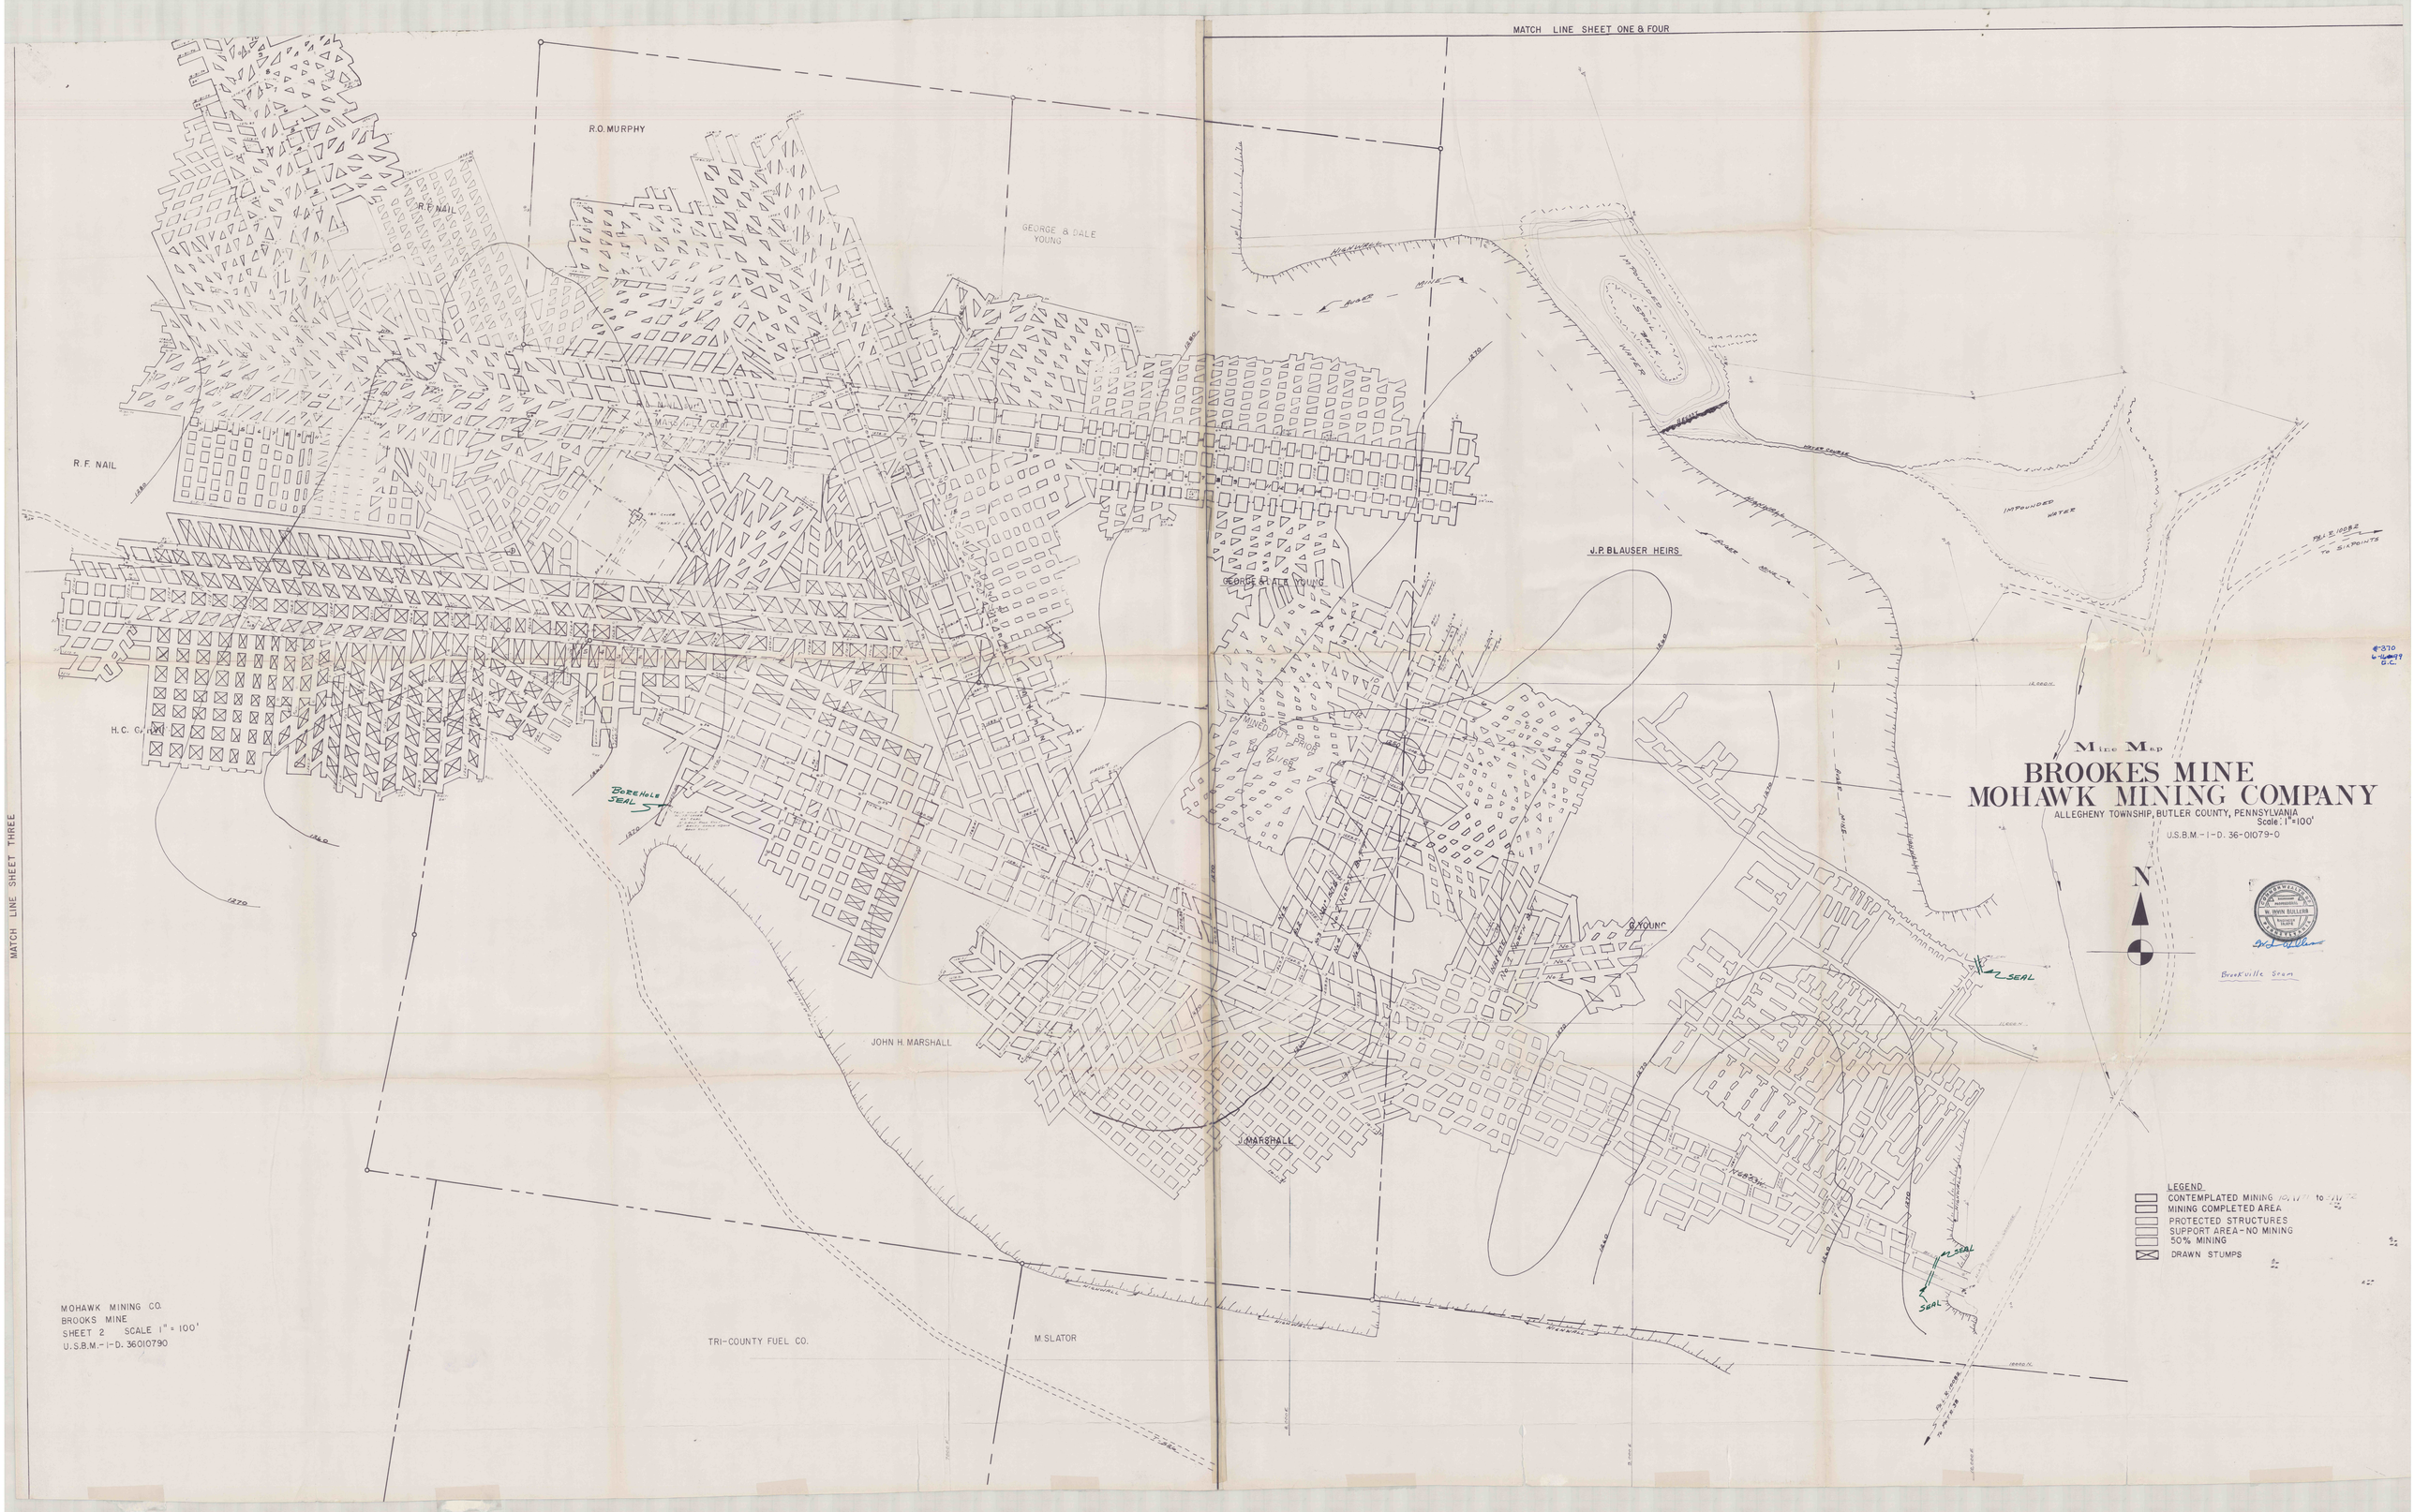
MATCH LINE SHEET ONE & FOUR
MATCH LINE SHEET THREE
R.O. MURPHY
R.F. NAIL
R.F. NAIL
GEORGE & DALE YOUNG
GEORGE & LATE YOUNG
J.P. BLAUSER HEIRS
IMPOUNDED WATER
IMPOUNDED WATER
BOREHOLE SEAL
SEAL
SEAL
SEAL
SEAL
G. YOUNG
JOHN H. MARSHALL
J. MARSHALL
TRI-COUNTY FUEL CO.
M. SLATOR
Mine Map
BROOKES MINE
MOHAWK MINING COMPANY
ALLEGHENY TOWNSHIP, BUTLER COUNTY, PENNSYLVANIA
Scale: 1"=100'
U.S.B.M.-I-D. 36-01079-0
N
LEGEND.
CONTEMPLATED MINING
MINING COMPLETED AREA
PROTECTED STRUCTURES
SUPPORT AREA-NO MINING
50% MINING
DRAWN STUMPS
MOHAWK MINING CO.
BROOKS MINE
SHEET 2 SCALE 1" = 100'
U.S.B.M.-I-D. 36010790