


# P. & N. COAL CO.

## BROWN-MINE No 4

### CANOE TOWNSHIP, INDIANA CO., PA

SCALE 1" = 100'

Walter J. Zimmerman, Surveyor  
Punxsutawney, Pa.

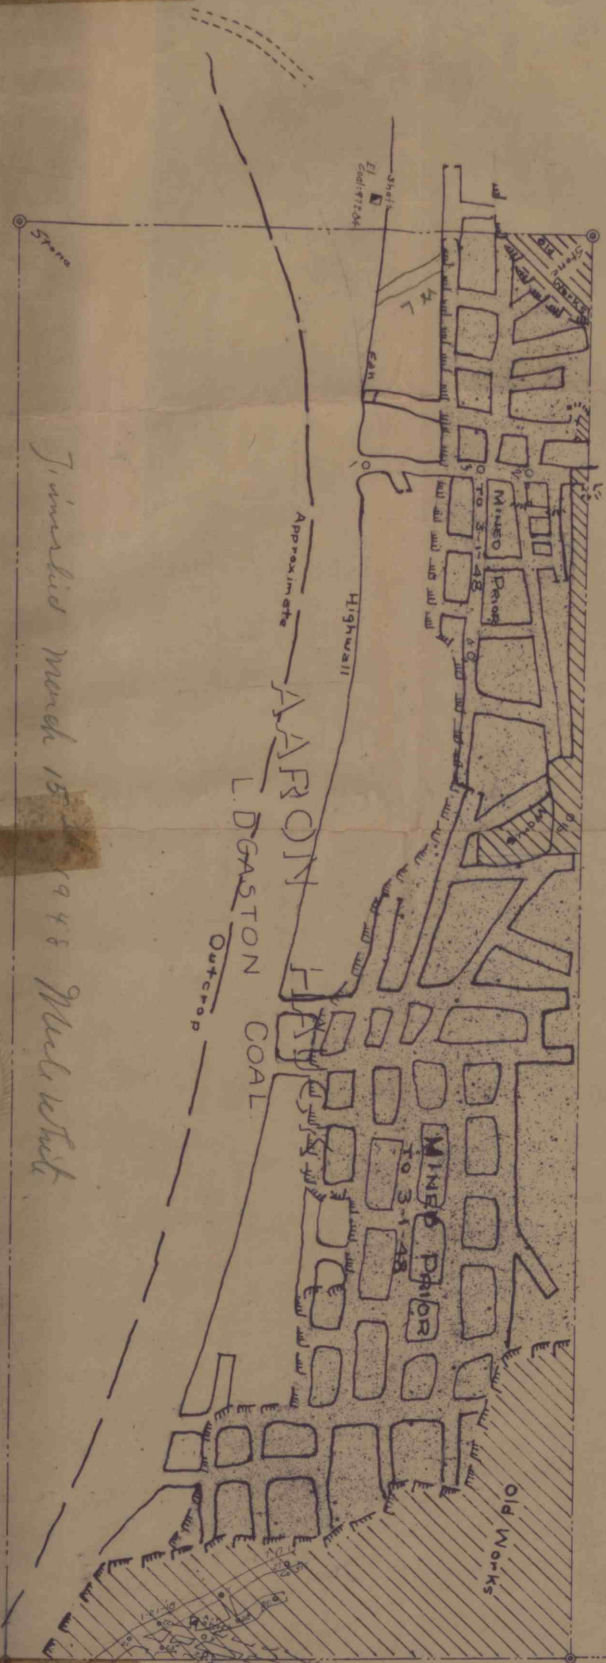


#163  
163  
163