

#382
6-17-99
C.C.





CHERRY RUN

DIET BOARD 7 MI. TO FORCE

PROPOSED WORKINGS

BRUNELLI MINE
FORCE PA
SCALE 1" = 100 FT.
Survey EXTENDED TO BY
MAY - 4 - 1960
JUNE - 18 - 1964
FEB. - 2 - 1966
D.M.B.
J.H.S.

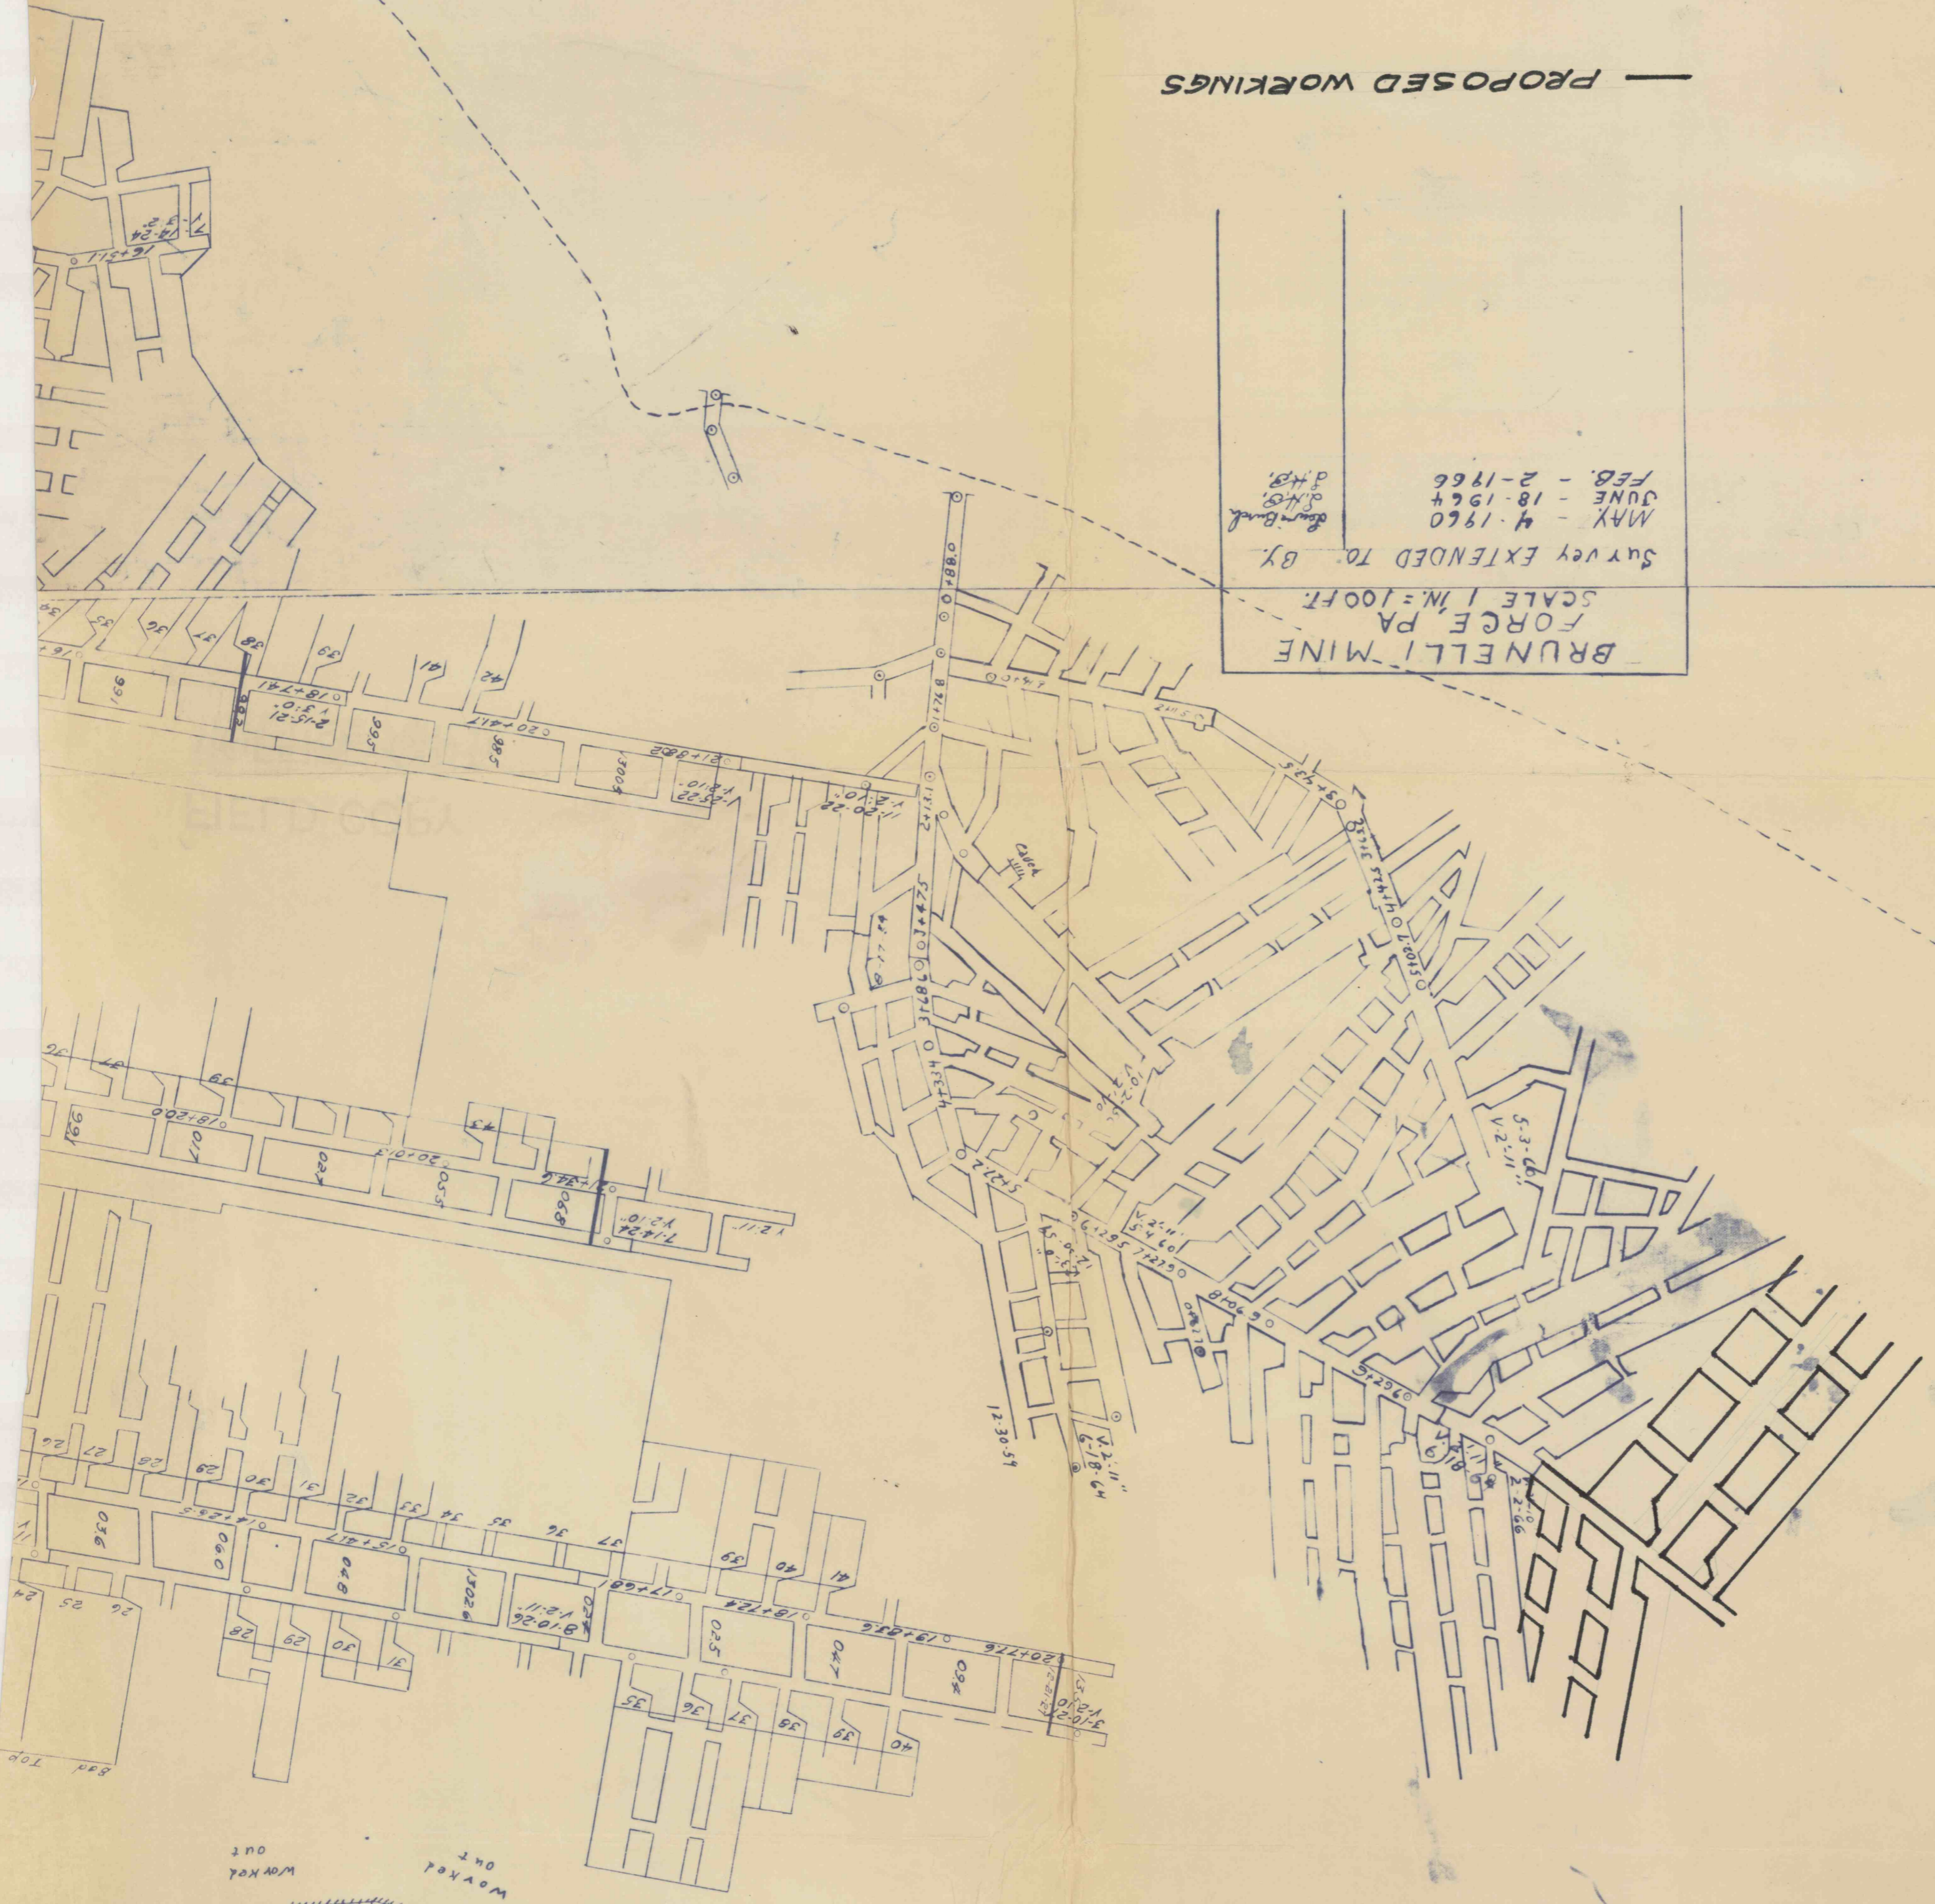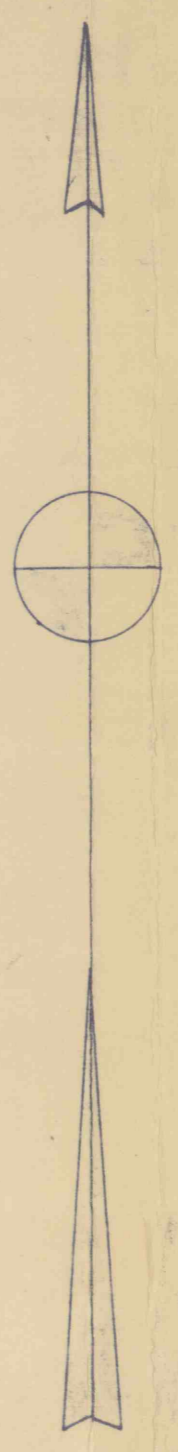

NEW SHAWMUT MINING CO.
COAL & SURFACE

DARL HEWITT

DARL HEWITT
COAL & SURFACE

PALUMBO ESTATE

CITY PALUMBO

M.B. COON

1967