

CHAS FOPE TR

LECHENE

ATP & C PRIME CRCP

Rel. Run

SW OPE


C PRIME CRCP

WM

WAGNER

SW OPE

PROJECTED WORKING AREA
NOV. 9, 66 TO MAY 9, 67

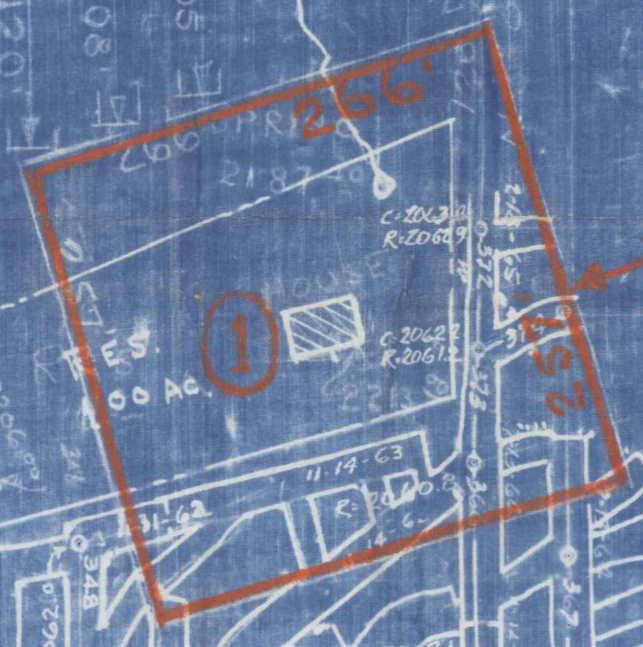


CALCULATED MINE SUPPORT

FIELD COPY

CHAS FOPE TRACT

CHAS FOPE TRACT

NATHAN FOSTER

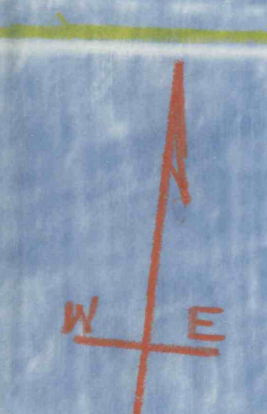

PATTON CLAY MFG CO.

Map of No. 1 MINE

Scale 1:100
C PRIME SEAM

Patton, Pa. Nov. 1933
Mining & Machinery Co.

#384
6-17-67
CC