


Chris Paper Tract
P.C.C. (COPIN LEASE)

Chris Paper Tract

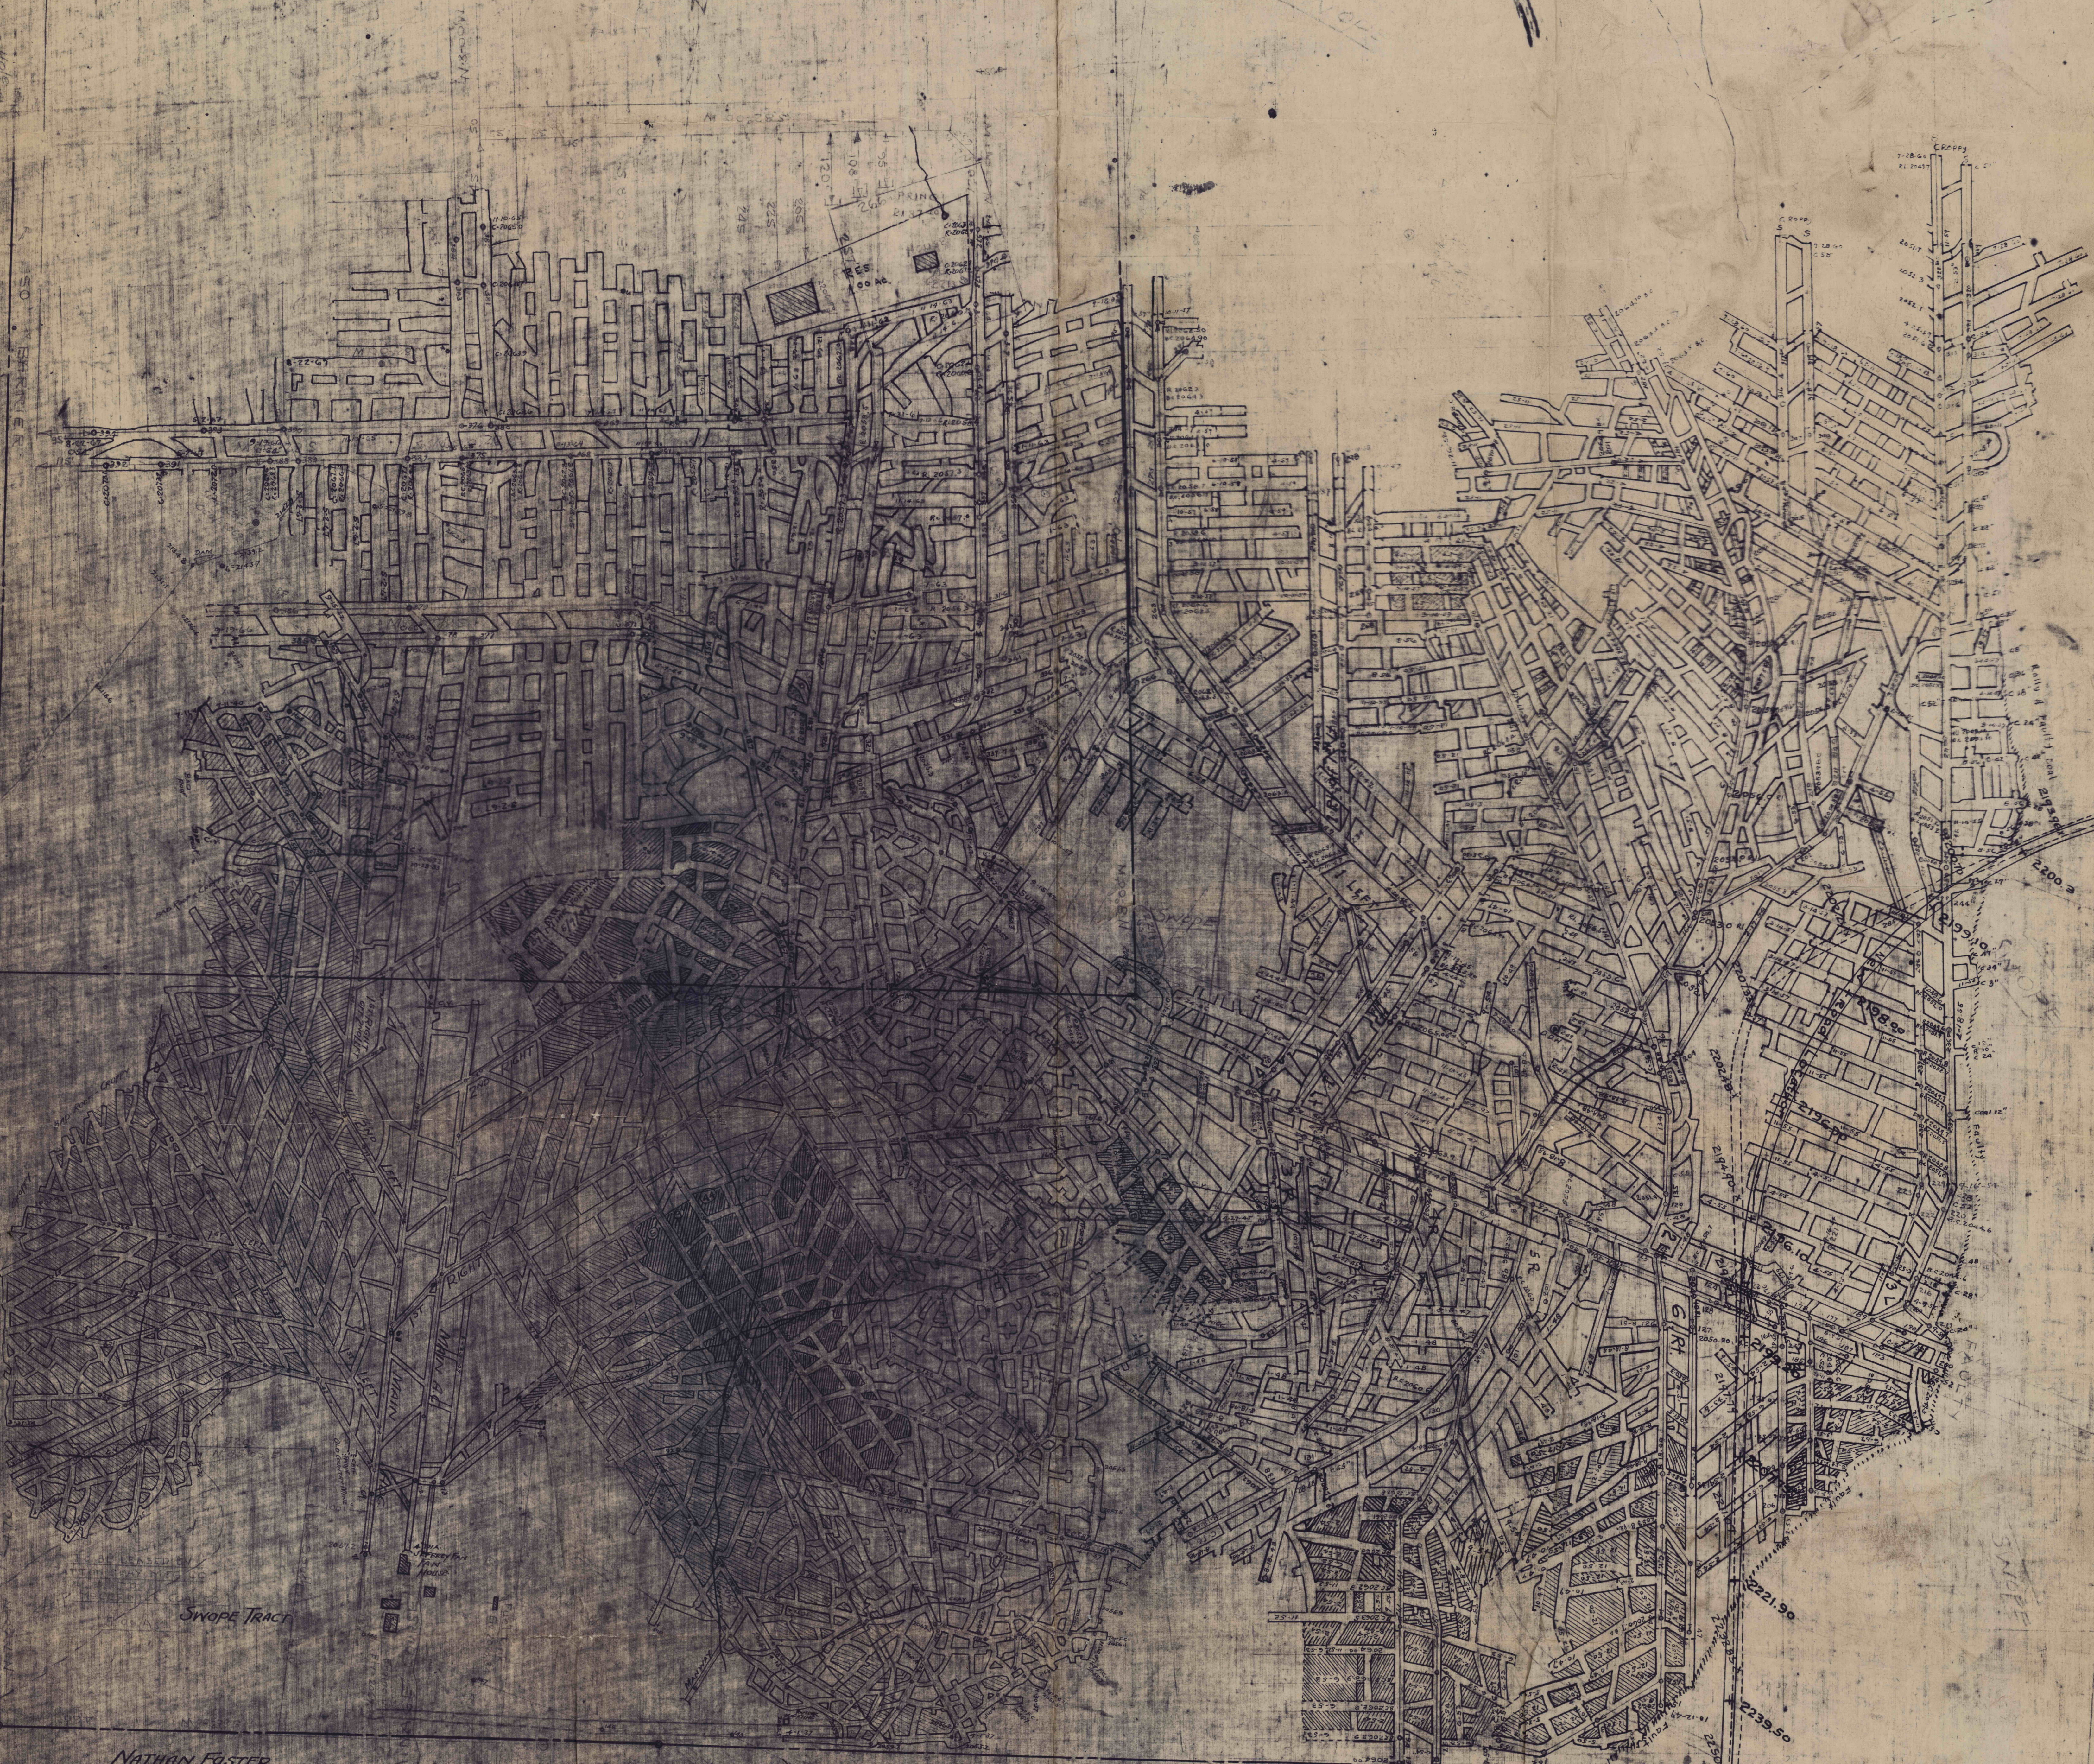

SWOPE TRACT

NATHAN FOSTER
(C.P.C. COPIN LEASE)

PRESENT OPERATOR JAMES HUNTER
PATTON CLAY MFG CO.

MAP OF NO. 1 MINE
PATTON, PA. NOV. 1ST 1933
Martin C. Kirsch, Eng.

SCALE 1"=100'
C PRIME SEAM

385
11-95
C.S.