


D.G. GORMAN

A.D. GORMAN

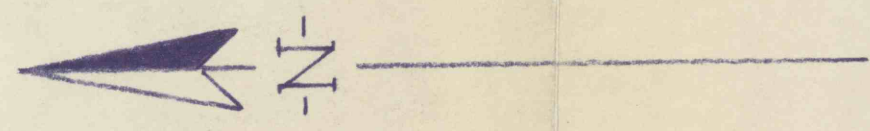

MINE MAP
 ARCADIA COMPANY
 COAL MINE

Montgomery Township, Indiana County, Pa.
 Scale 1" = 100' June 16, 1960.
 Walter J. Zimmerman Registered Engineer Punxsutawney, Pa.

I hereby certify that this is a true and correct copy of the original map of this mine and that the original is a true, complete and correct map and survey of all the excavations made in this abandoned mine.

Walter J. Zimmerman
 Walter J. Zimmerman
 Registered Engineer

#392
 6-17-99
 C.C.