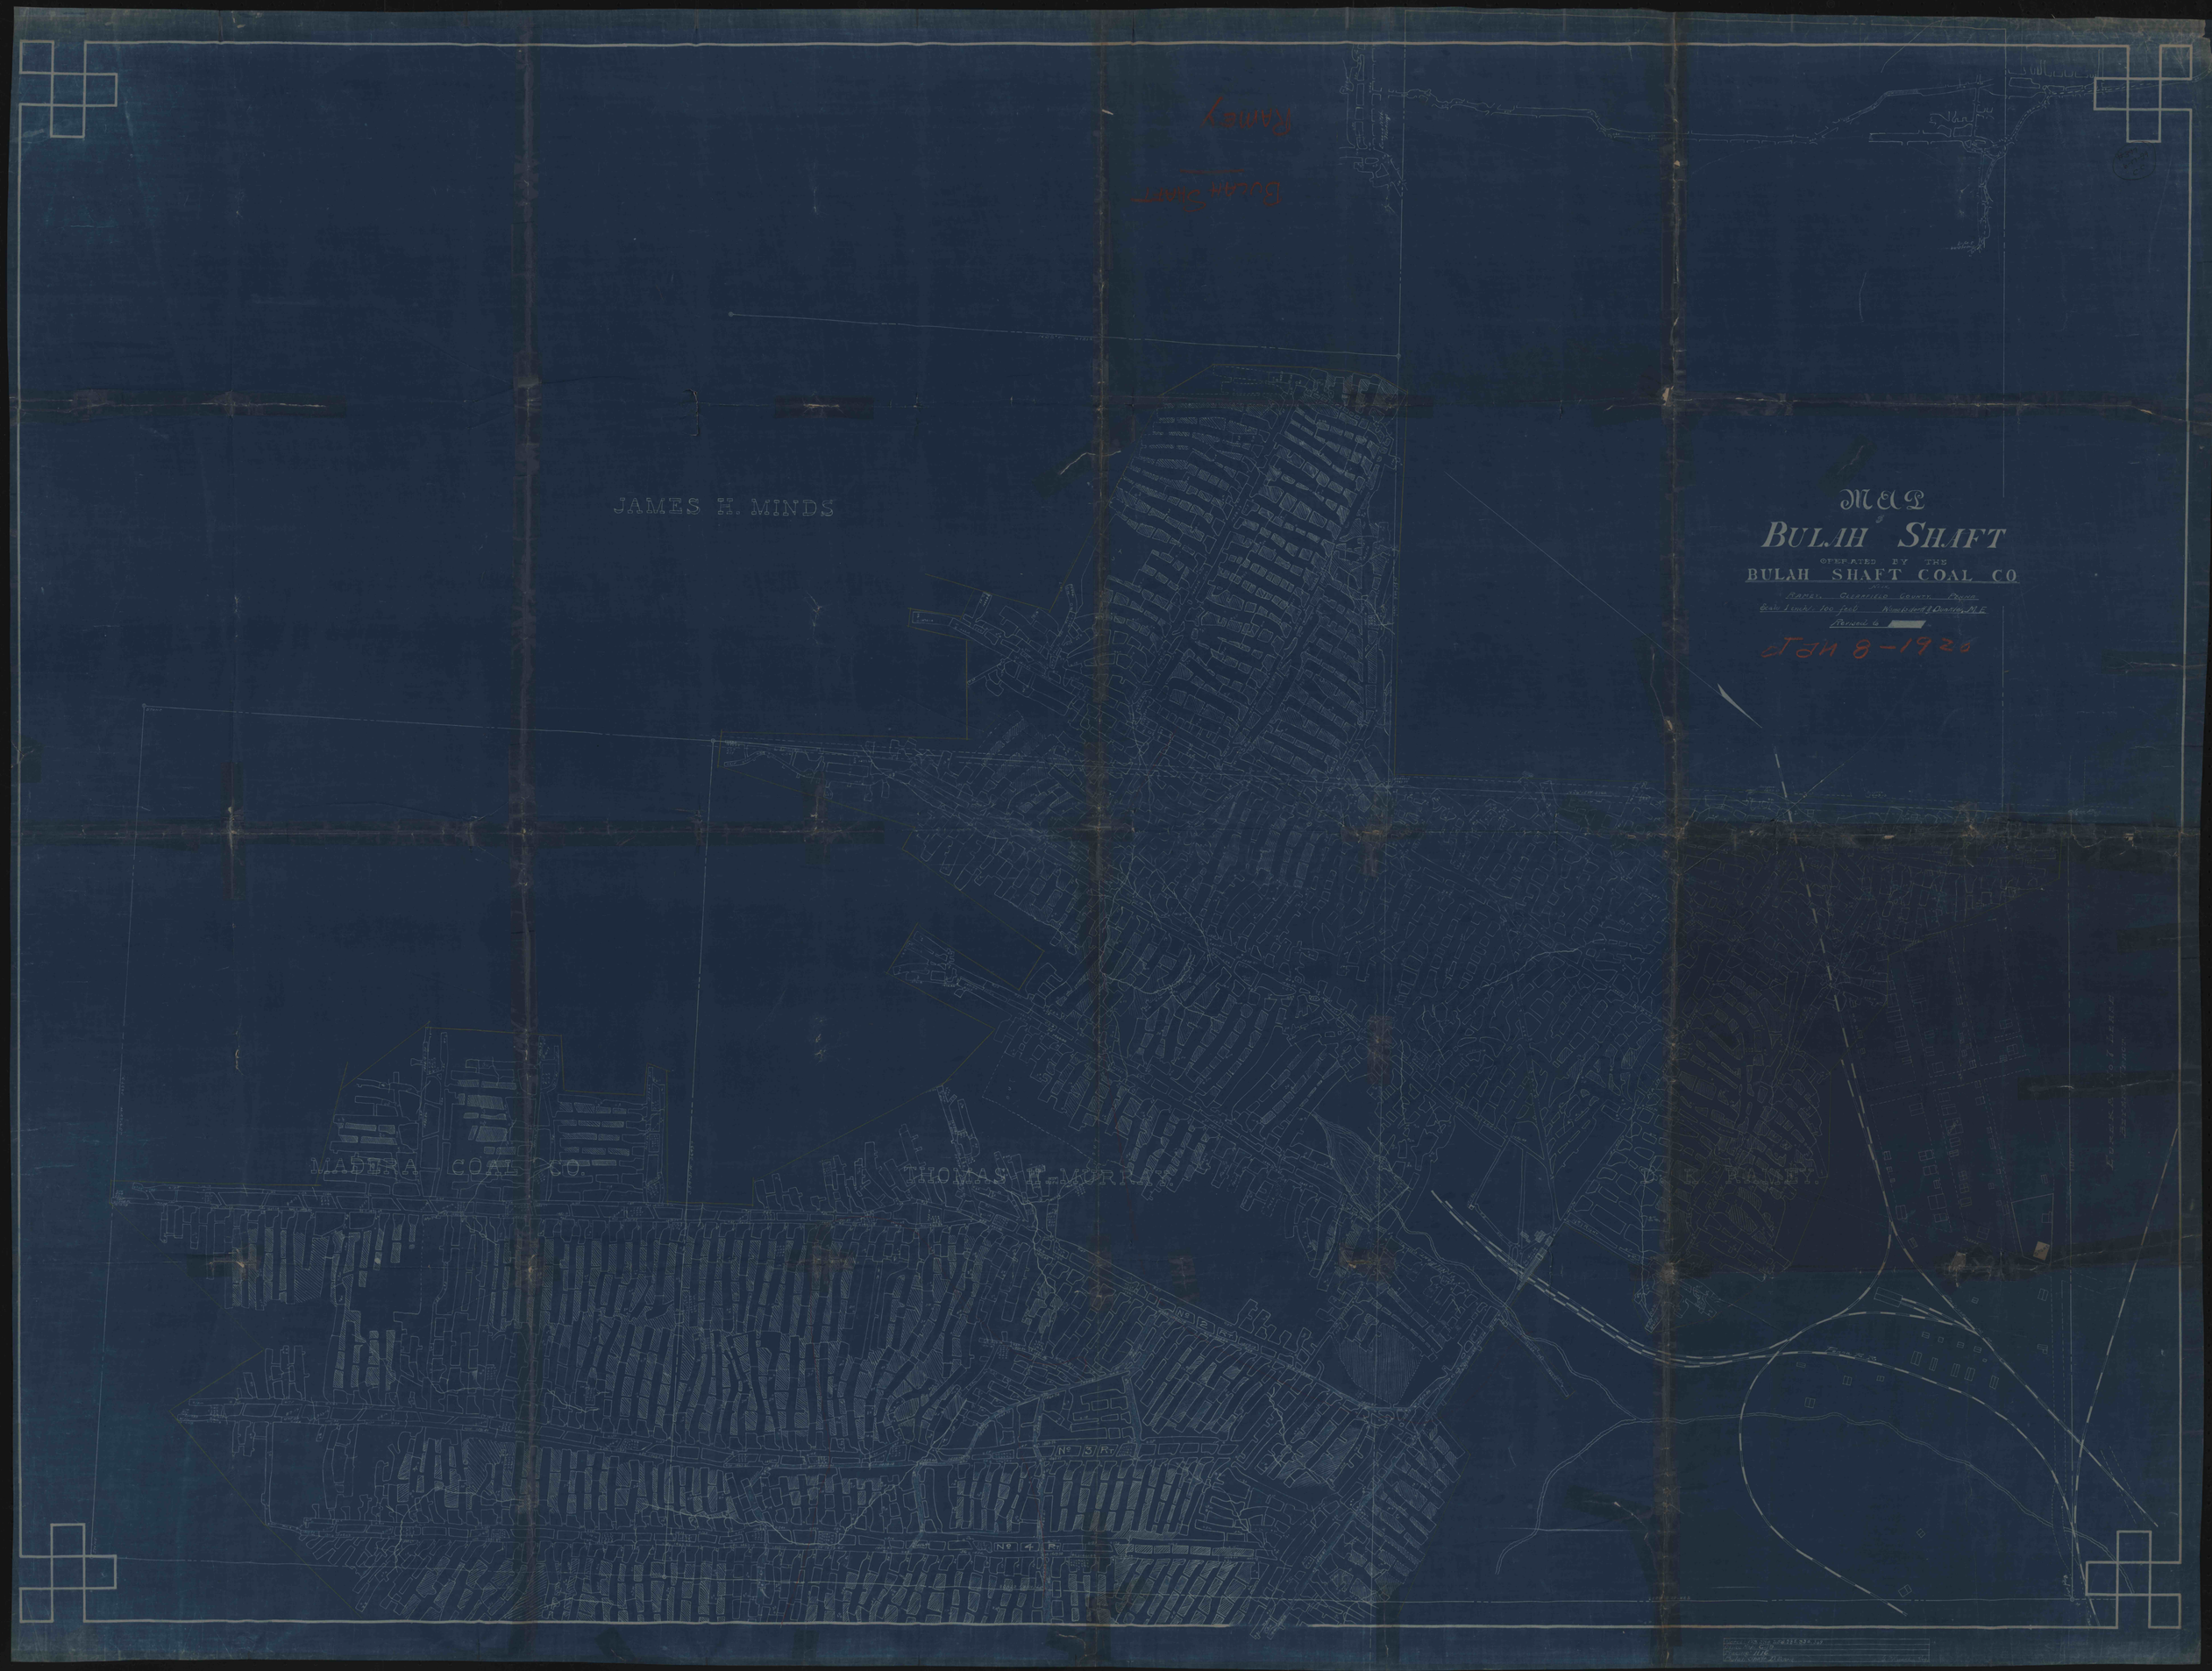

MAP
BULAH SHAFT
OPERATED BY THE
BULAH SHAFT COAL CO
RAMEY, CLEARFIELD COUNTY, PENNA
Scale 1 inch = 100 feet
Revised 6
JAMES H. MINDS
MADERA COAL CO.
THOMAS H. MURRAY
D. R. RAMEY
Nº 3 Rt
Nº 4 Rt