


STATE PARK LAND

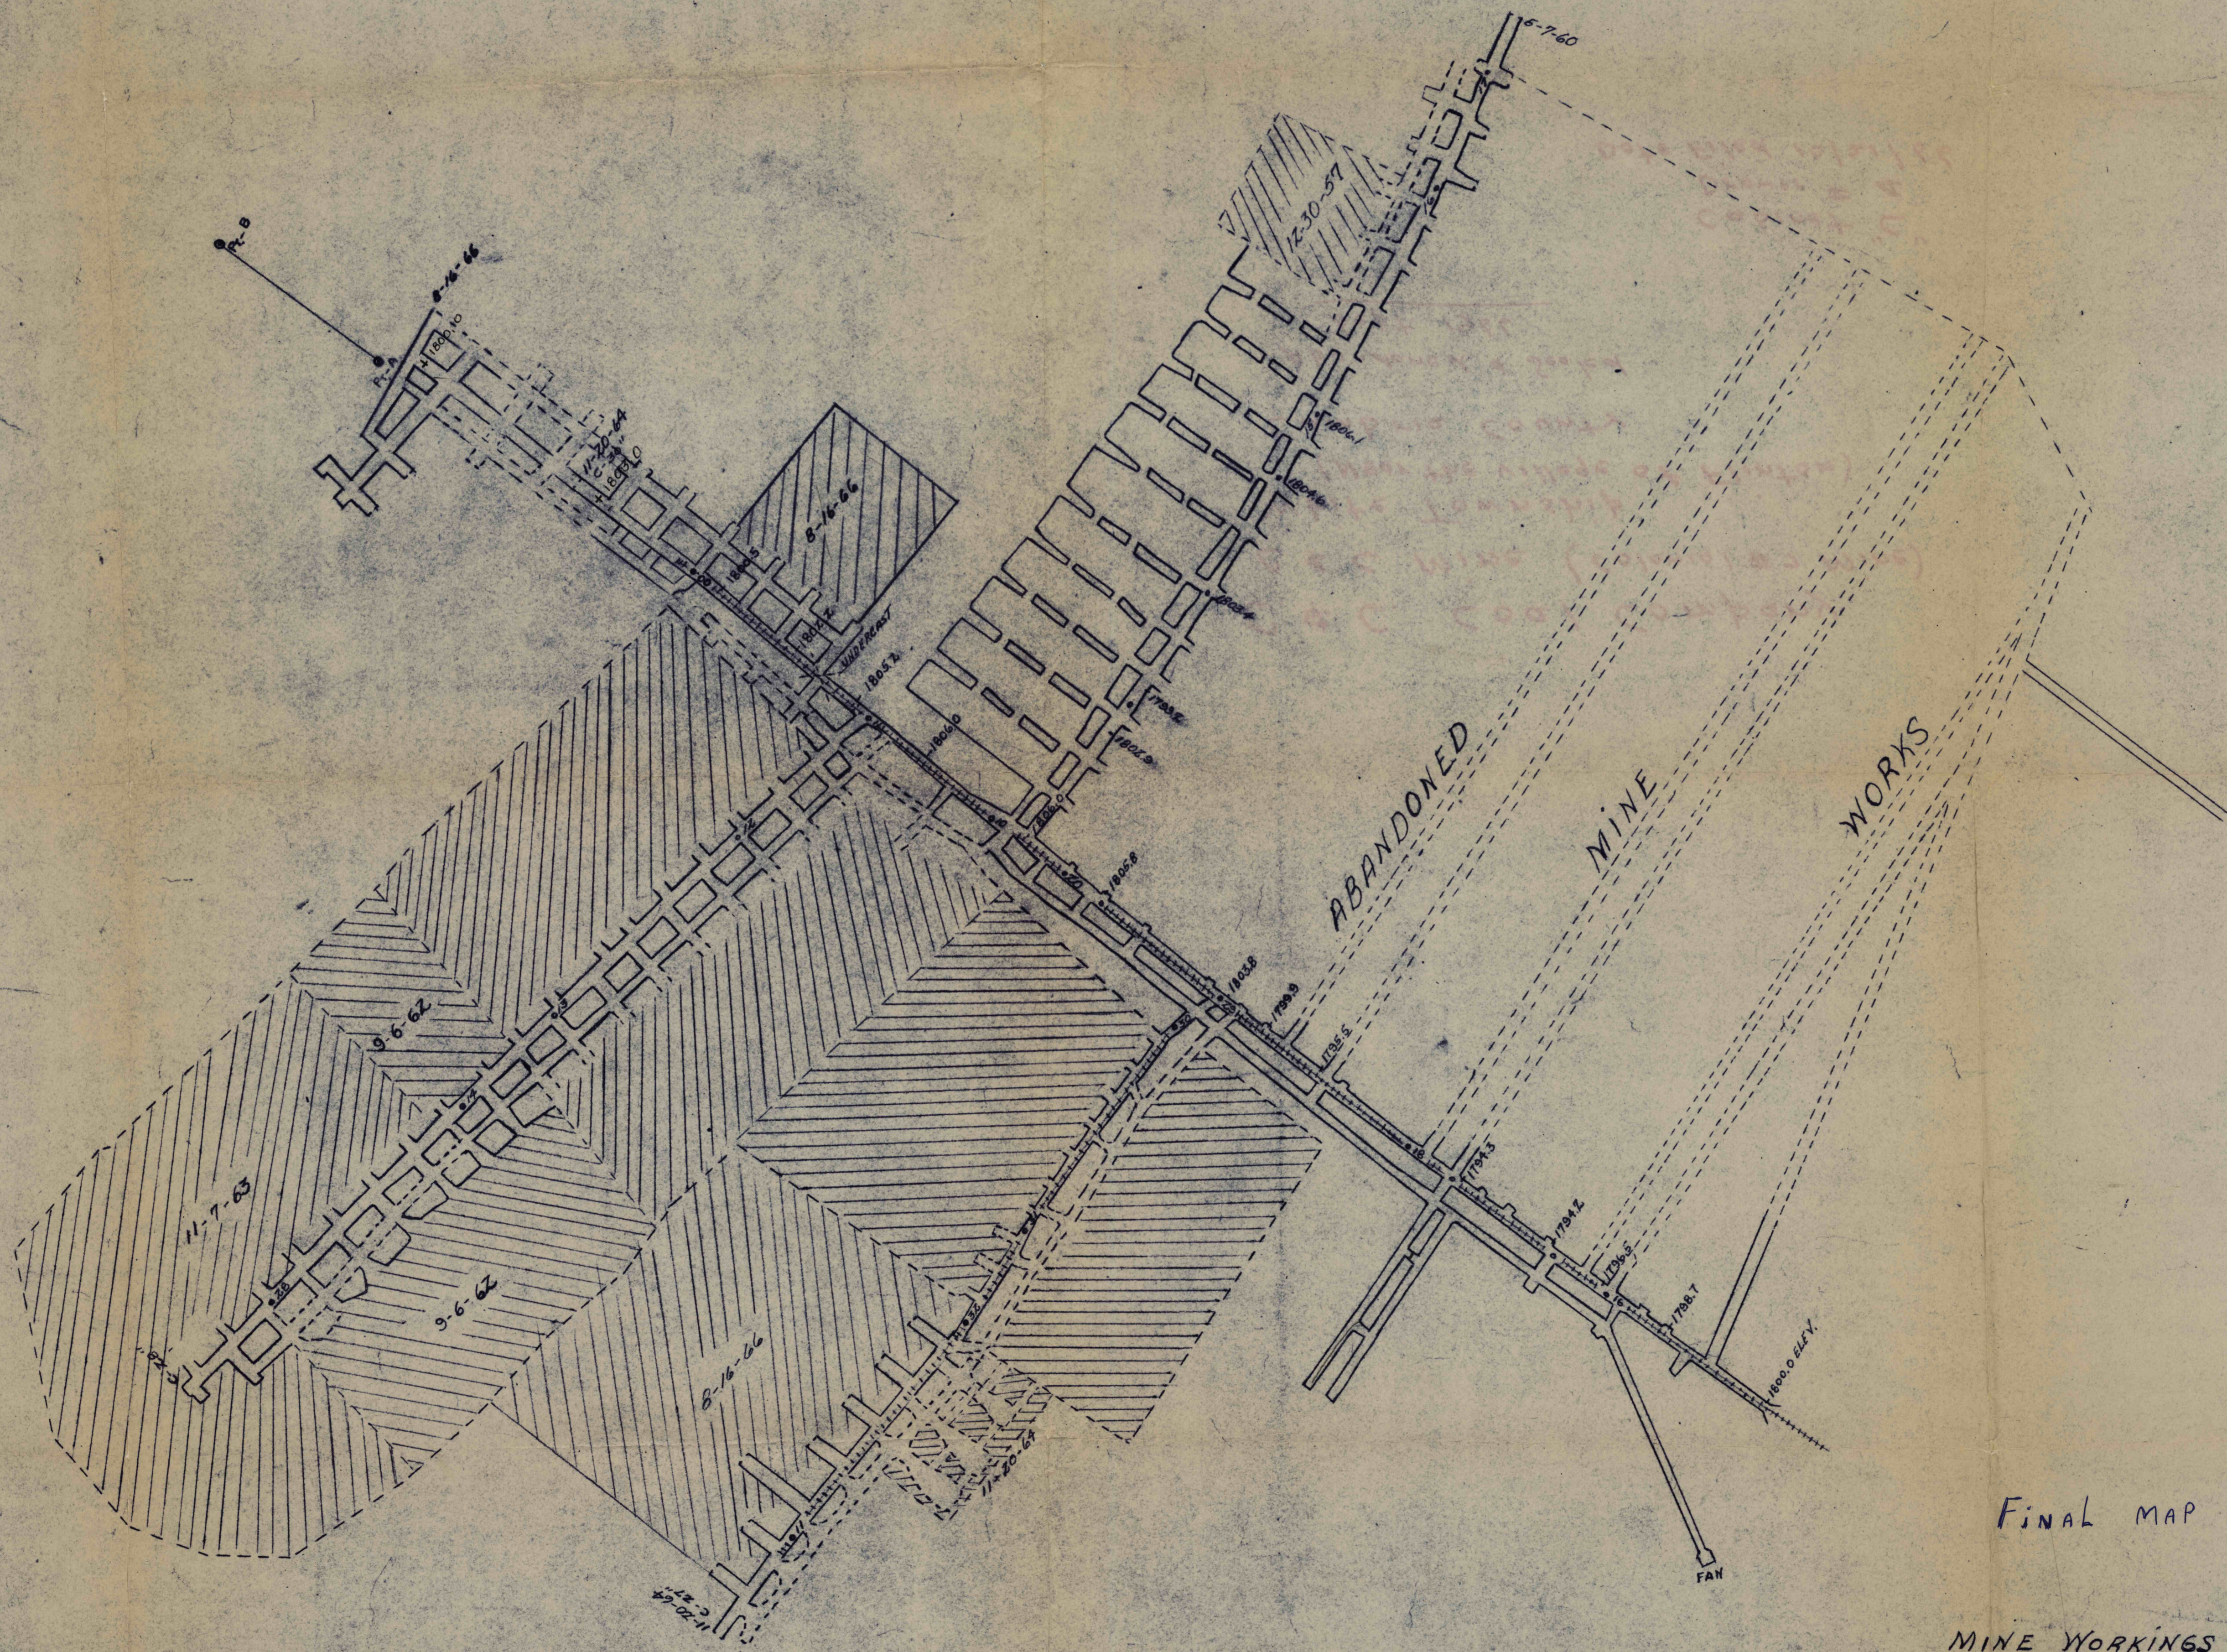

FINAL MAP OF C & C Coal Co.

MINE WORKINGS OF C. AND C. COAL CO.

COLONIAL # 7 MINE

WHITE TWP. - CAMBRIA COUNTY

SCALE - 1" = 100' MAP REVISED TO - 8-16-66

SEAL

#408  
6-17-99  
C.C.