


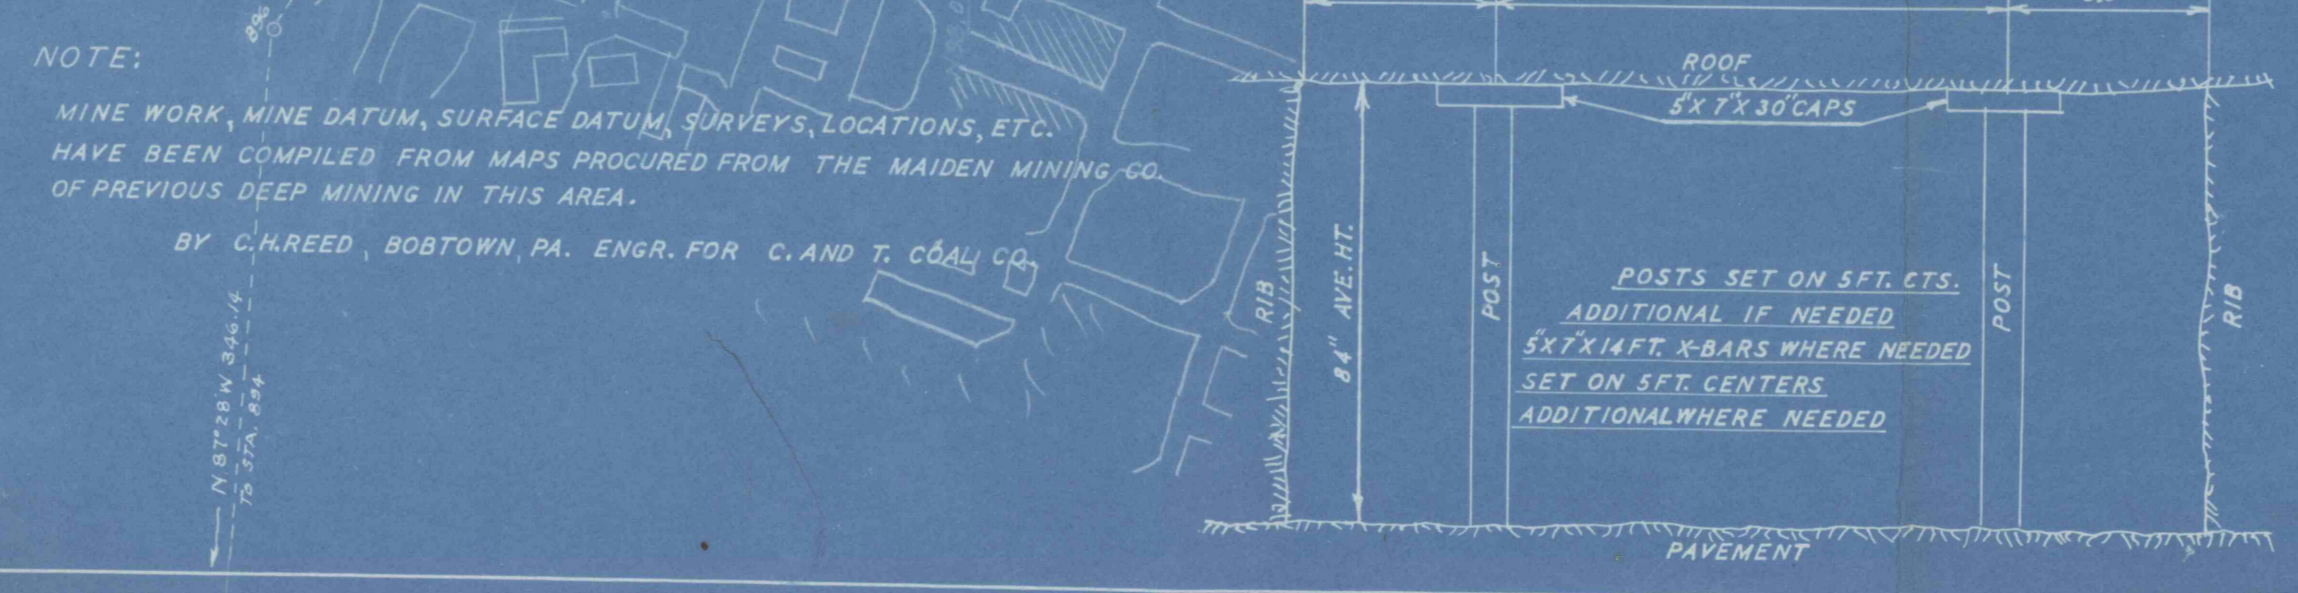

REVISED 3-31-62 C.H. REED
 TO DATE 8-13-62 C.H. REED
 TO DATE 8-24-62 C.H. REED
 TO DATE 11-24-62 William A. Truitt
 TO DATE 12-31-62 William A. Truitt
 TO DATE 4-11-63 William A. Truitt
 TO DATE 4-18-63 William A. Truitt
 TO DATE 6-20-63 Charles H. Reed

NOTE:
 MINE SURVEY BY WILLIAM A. TRUITT
 THIS MAP PREPARED BY CHARLES H. REED, BOXTOWN, PA. JULY 23, 1963

YELLOW LINE = LEAVE LINE



MINE NO 1
 C. AND T. COAL CO.
 DUNKARD TWP. GREENE, CO. PA.
 SCALE 1/100"
 DATE FEB. 5, 1962
 FRANK DOREZI SUPT. TEL. RA. 5-3237
 ADDRESS POINT MARION, PA. R.D. 1 BOX 235
 THIS MAP AND OPENING PROPOSALS PREPARED BY
 CHARLES H. REED, BOXTOWN, PA. ENGINEER FOR C. & T. COAL CO.



441
 6-17-63