


TRACT 142313 Maiden Mining Co.

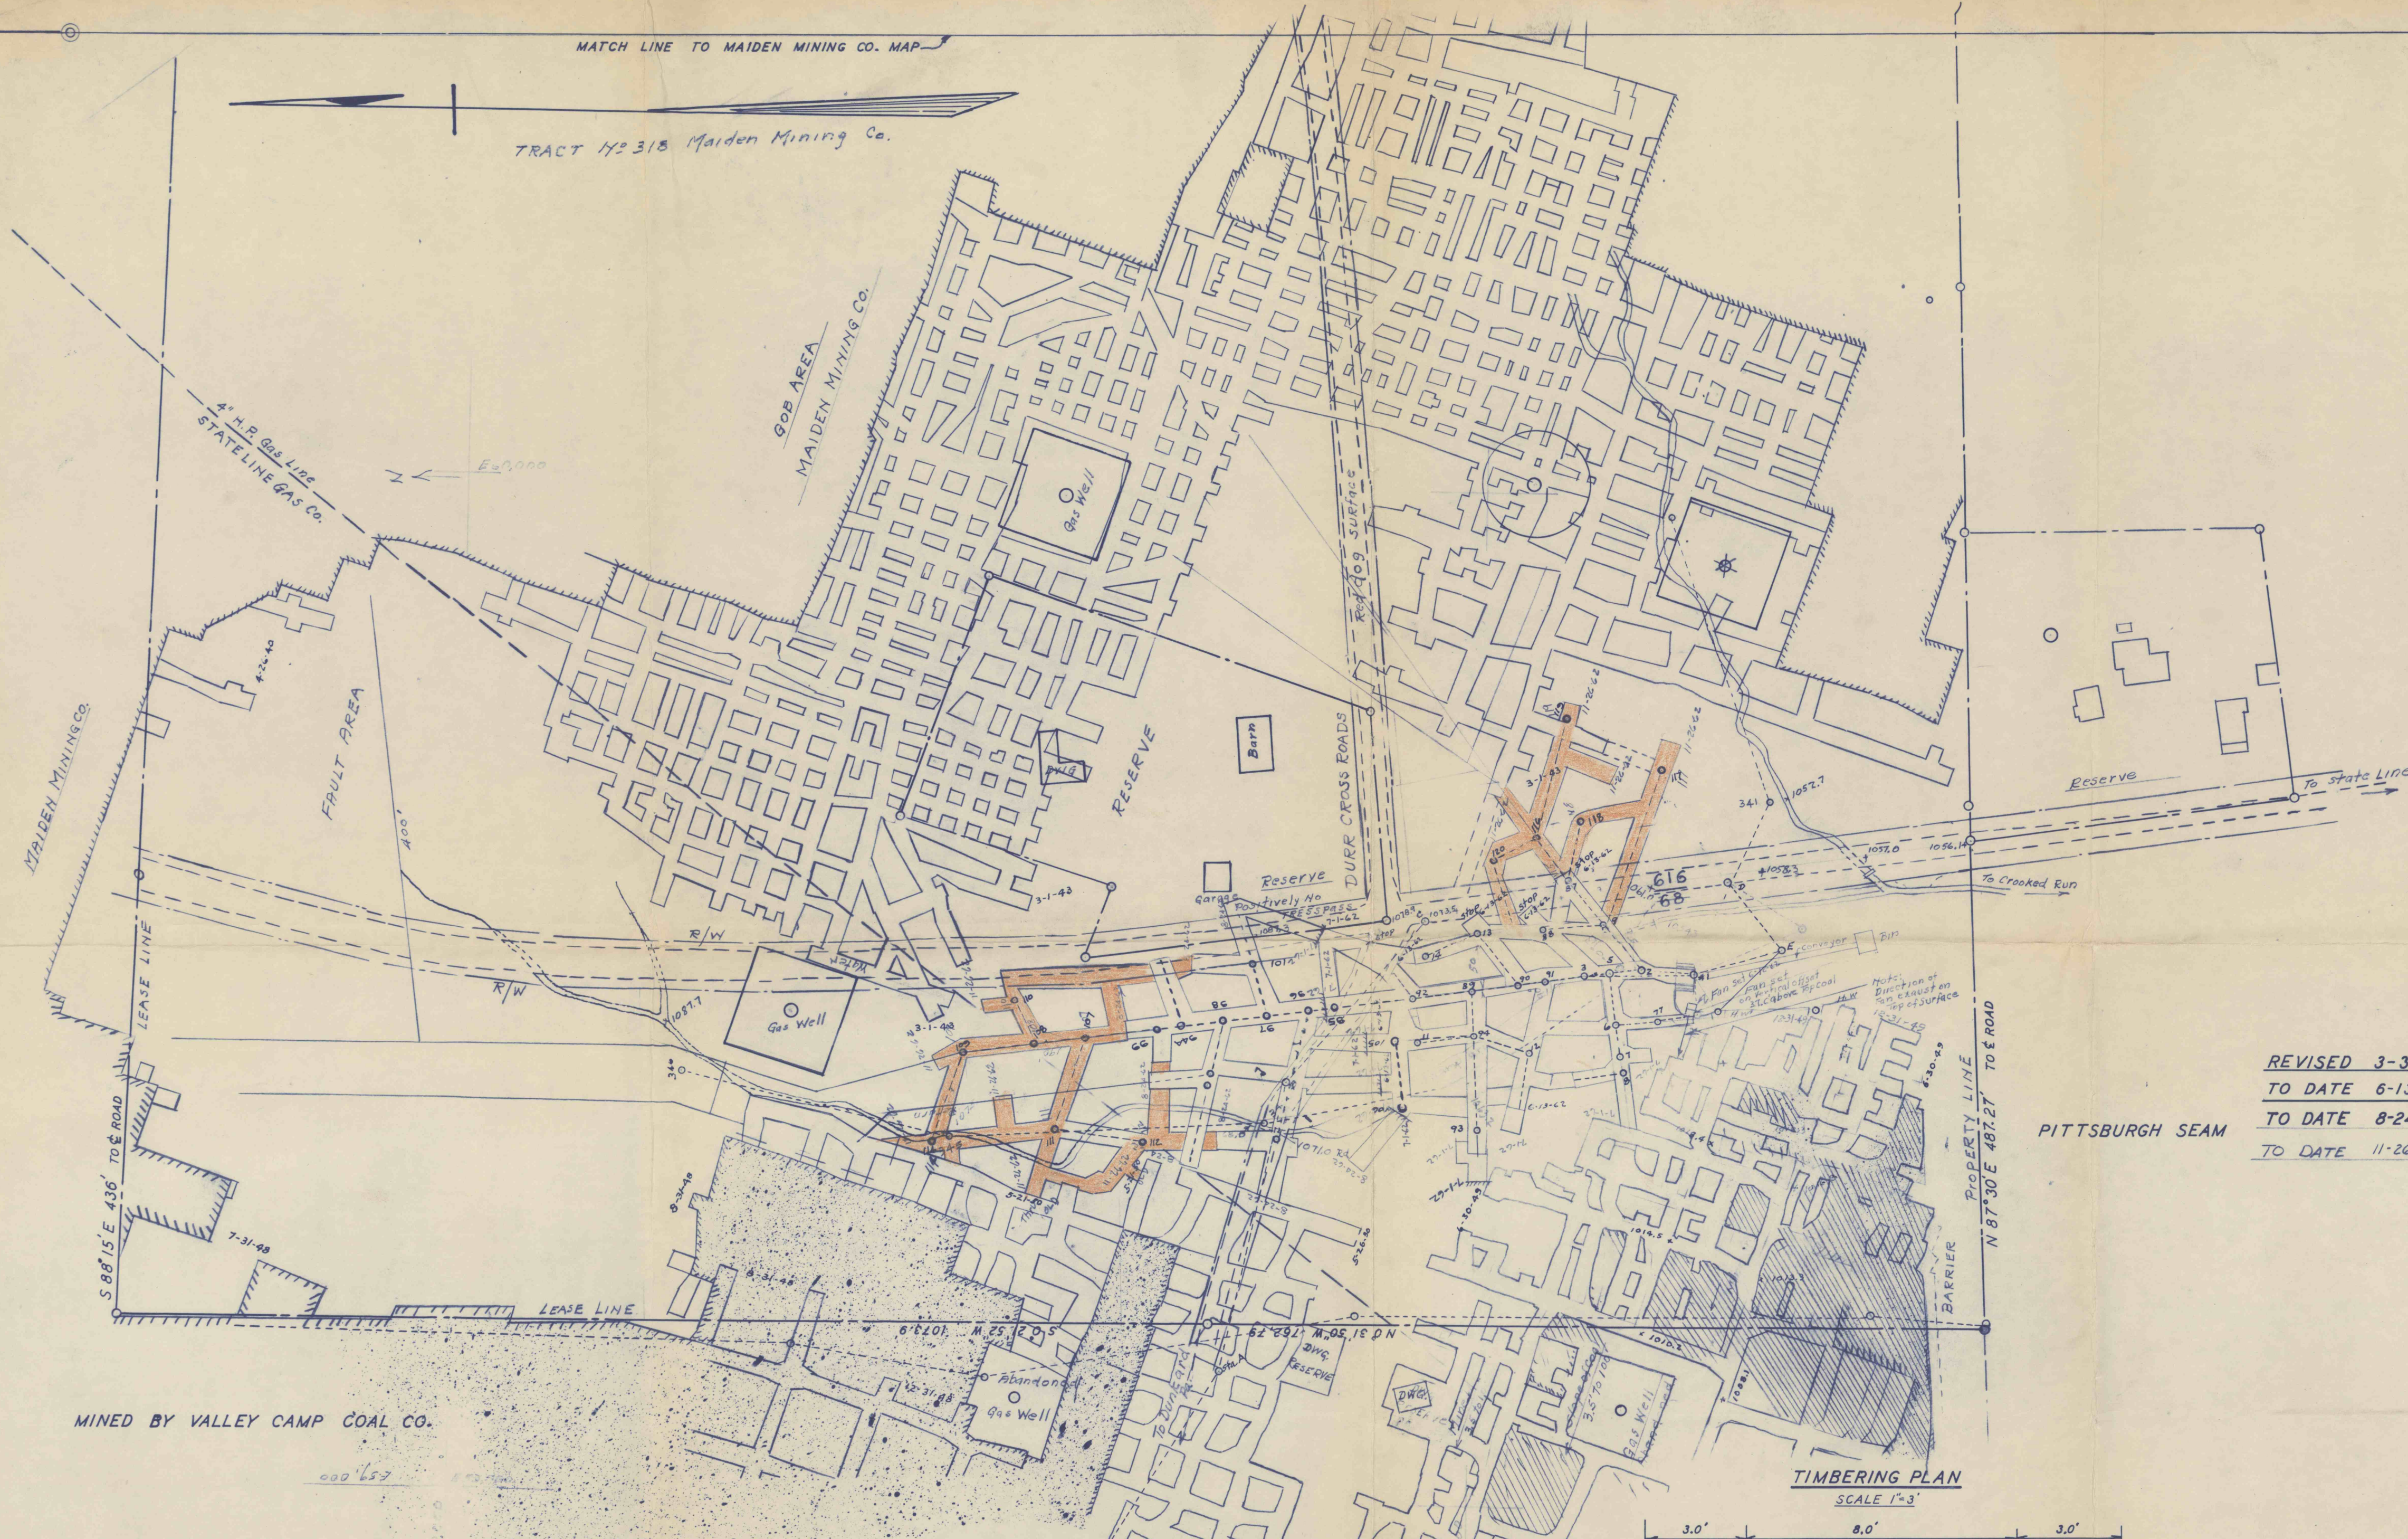


REVISED 3-31-62 C.H. REED
 TO DATE 6-13-62 C.H. REED
 TO DATE 8-24-62 C.H. REED
 TO DATE 11-26-62 William A. Thistlethwaite

PITTSBURGH SEAM

MINED BY VALLEY CAMP COAL CO.

TIMBERING PLAN
SCALE 1"=3'

NOTE:
 MINE WORK, MINE DATUM, SURFACE DATUM, SURVEYS, LOCATIONS, ETC.
 HAVE BEEN COMPILED FROM MAPS PROCURED FROM THE MAIDEN MINING CO.
 OF PREVIOUS DEEP MINING IN THIS AREA.
 BY C.H. REED, BOBTOWN, PA. ENGR. FOR C. AND T. COAL CO.

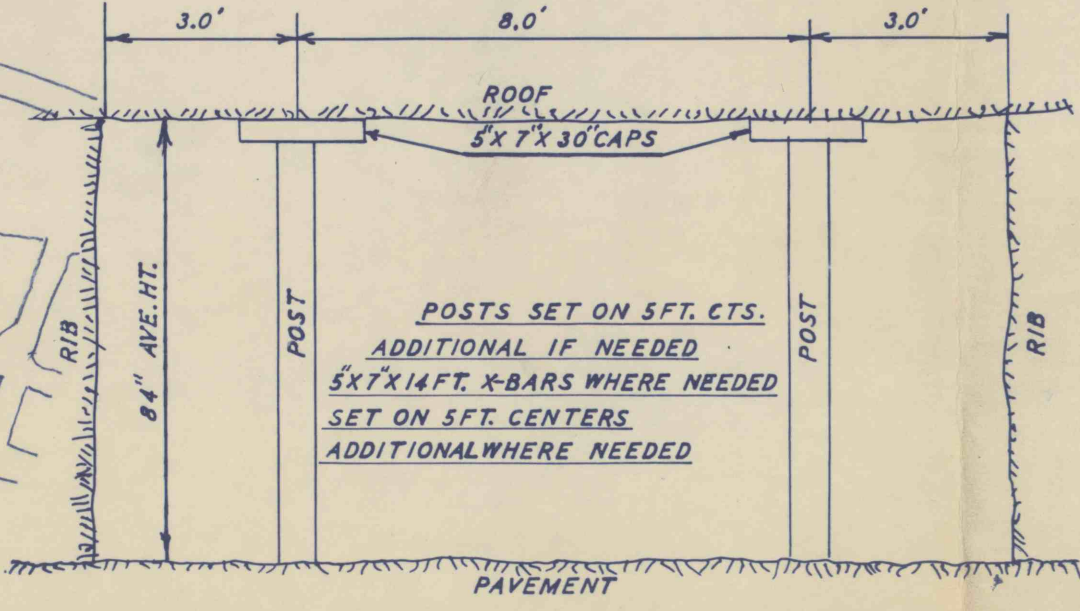

MINE NO 1	
C. AND T. COAL CO.	
DUNKARD TWP	GREENE, CO. PA.
SCALE 1"=100 FT.	DATE FEB. 5, 1962
FRANK DORENZI SUPT.	TEL. RA. 5-3237
ADDRESS POINT MARION, PA. R.D. 1 BOX 235	
THIS MAP AND OPENING PROPOSALS PREPARED BY	
CHARLES H. REED BOBTOWN, PA. ENGINEER FOR C. & T. COAL CO.	