

ALLEGHENY RIVER MINING CO.
KITTANNING PA.

CADOGAN No. 2 MINE

TWR South Buffalo
CO. Armstrong

SCALE: 1" = 100'



SURVEY DATE 6-1-68

James Sprout
R. S. 8414-V

LEGEND

CONTEMPLATED MINING	
SUPPORT AREA	
PROTECTED STRUCTURES	
MINING COMPLETED AREA	

FORMERLY
WILLIAM STE...
NOW
WILLIAM C. WISE

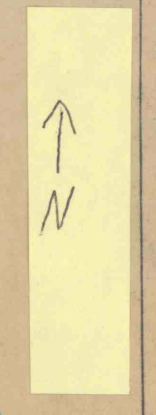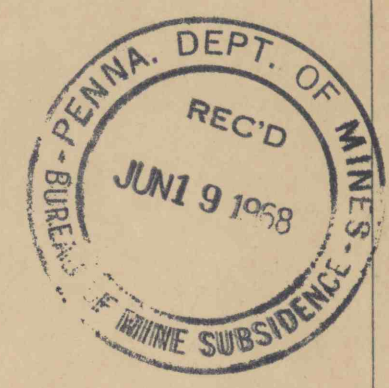

N 22,926° E
L 23,130 SL

2070
103-8-H

94-2-H

94-1-H

2072

2071

2074

2073

2075

1126.5

1131.0

1135.5

1139.0

1144.4

1148.4

1152.4

1157.4

1162.4

1167.5


















2061

2062

2063

2076

20

26

12

19