


D.D. NO. 613

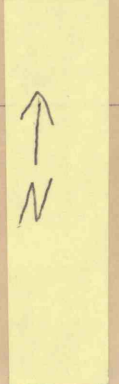

ALLEGHENY RIVER MINING CO.
KITANNING, PA.
CADOGAN N-2
TWP. SOUTH BUFFALO
CO. ARMSTRONG PA.
SCALE 1" = 100'
SURVEY DATE 12-1-67
James Sprout
R.S. 8444-E

LEGEND
12-1-67
Contemplated Mining 6-1-68
Support Area
Protected Structures
Mining Completed Area

