


FORMERLY
JAMES HILL
NOW
D. RICHARD HILL

FORMERLY
H. S. & W. M. FERGUSON
NOW
MYRON A. SHOFFNER

FORMERLY
THOMAS FERGUSON
NOW
MYRON A. SHOFFNER

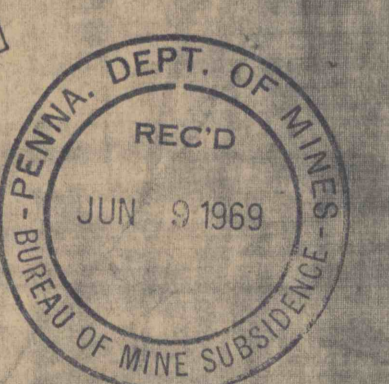

ALLEGHENY RIVER MINING CO. KITTING PA.	
CANON No. 2 MINE	
TWR	South Buffalo
CO.	Armstrong
SCALE:	1" = 100'
SURVEY DATE:	6-1-69
<i>James Sprout</i> R. S. 8414-1	
LEGEND	6-1-69 12-1-69
CONTEMPLATED MINING	
SUPPORT AREA	
PROTECTED STRUCTURES	
MINING COMPLETED AREA	

