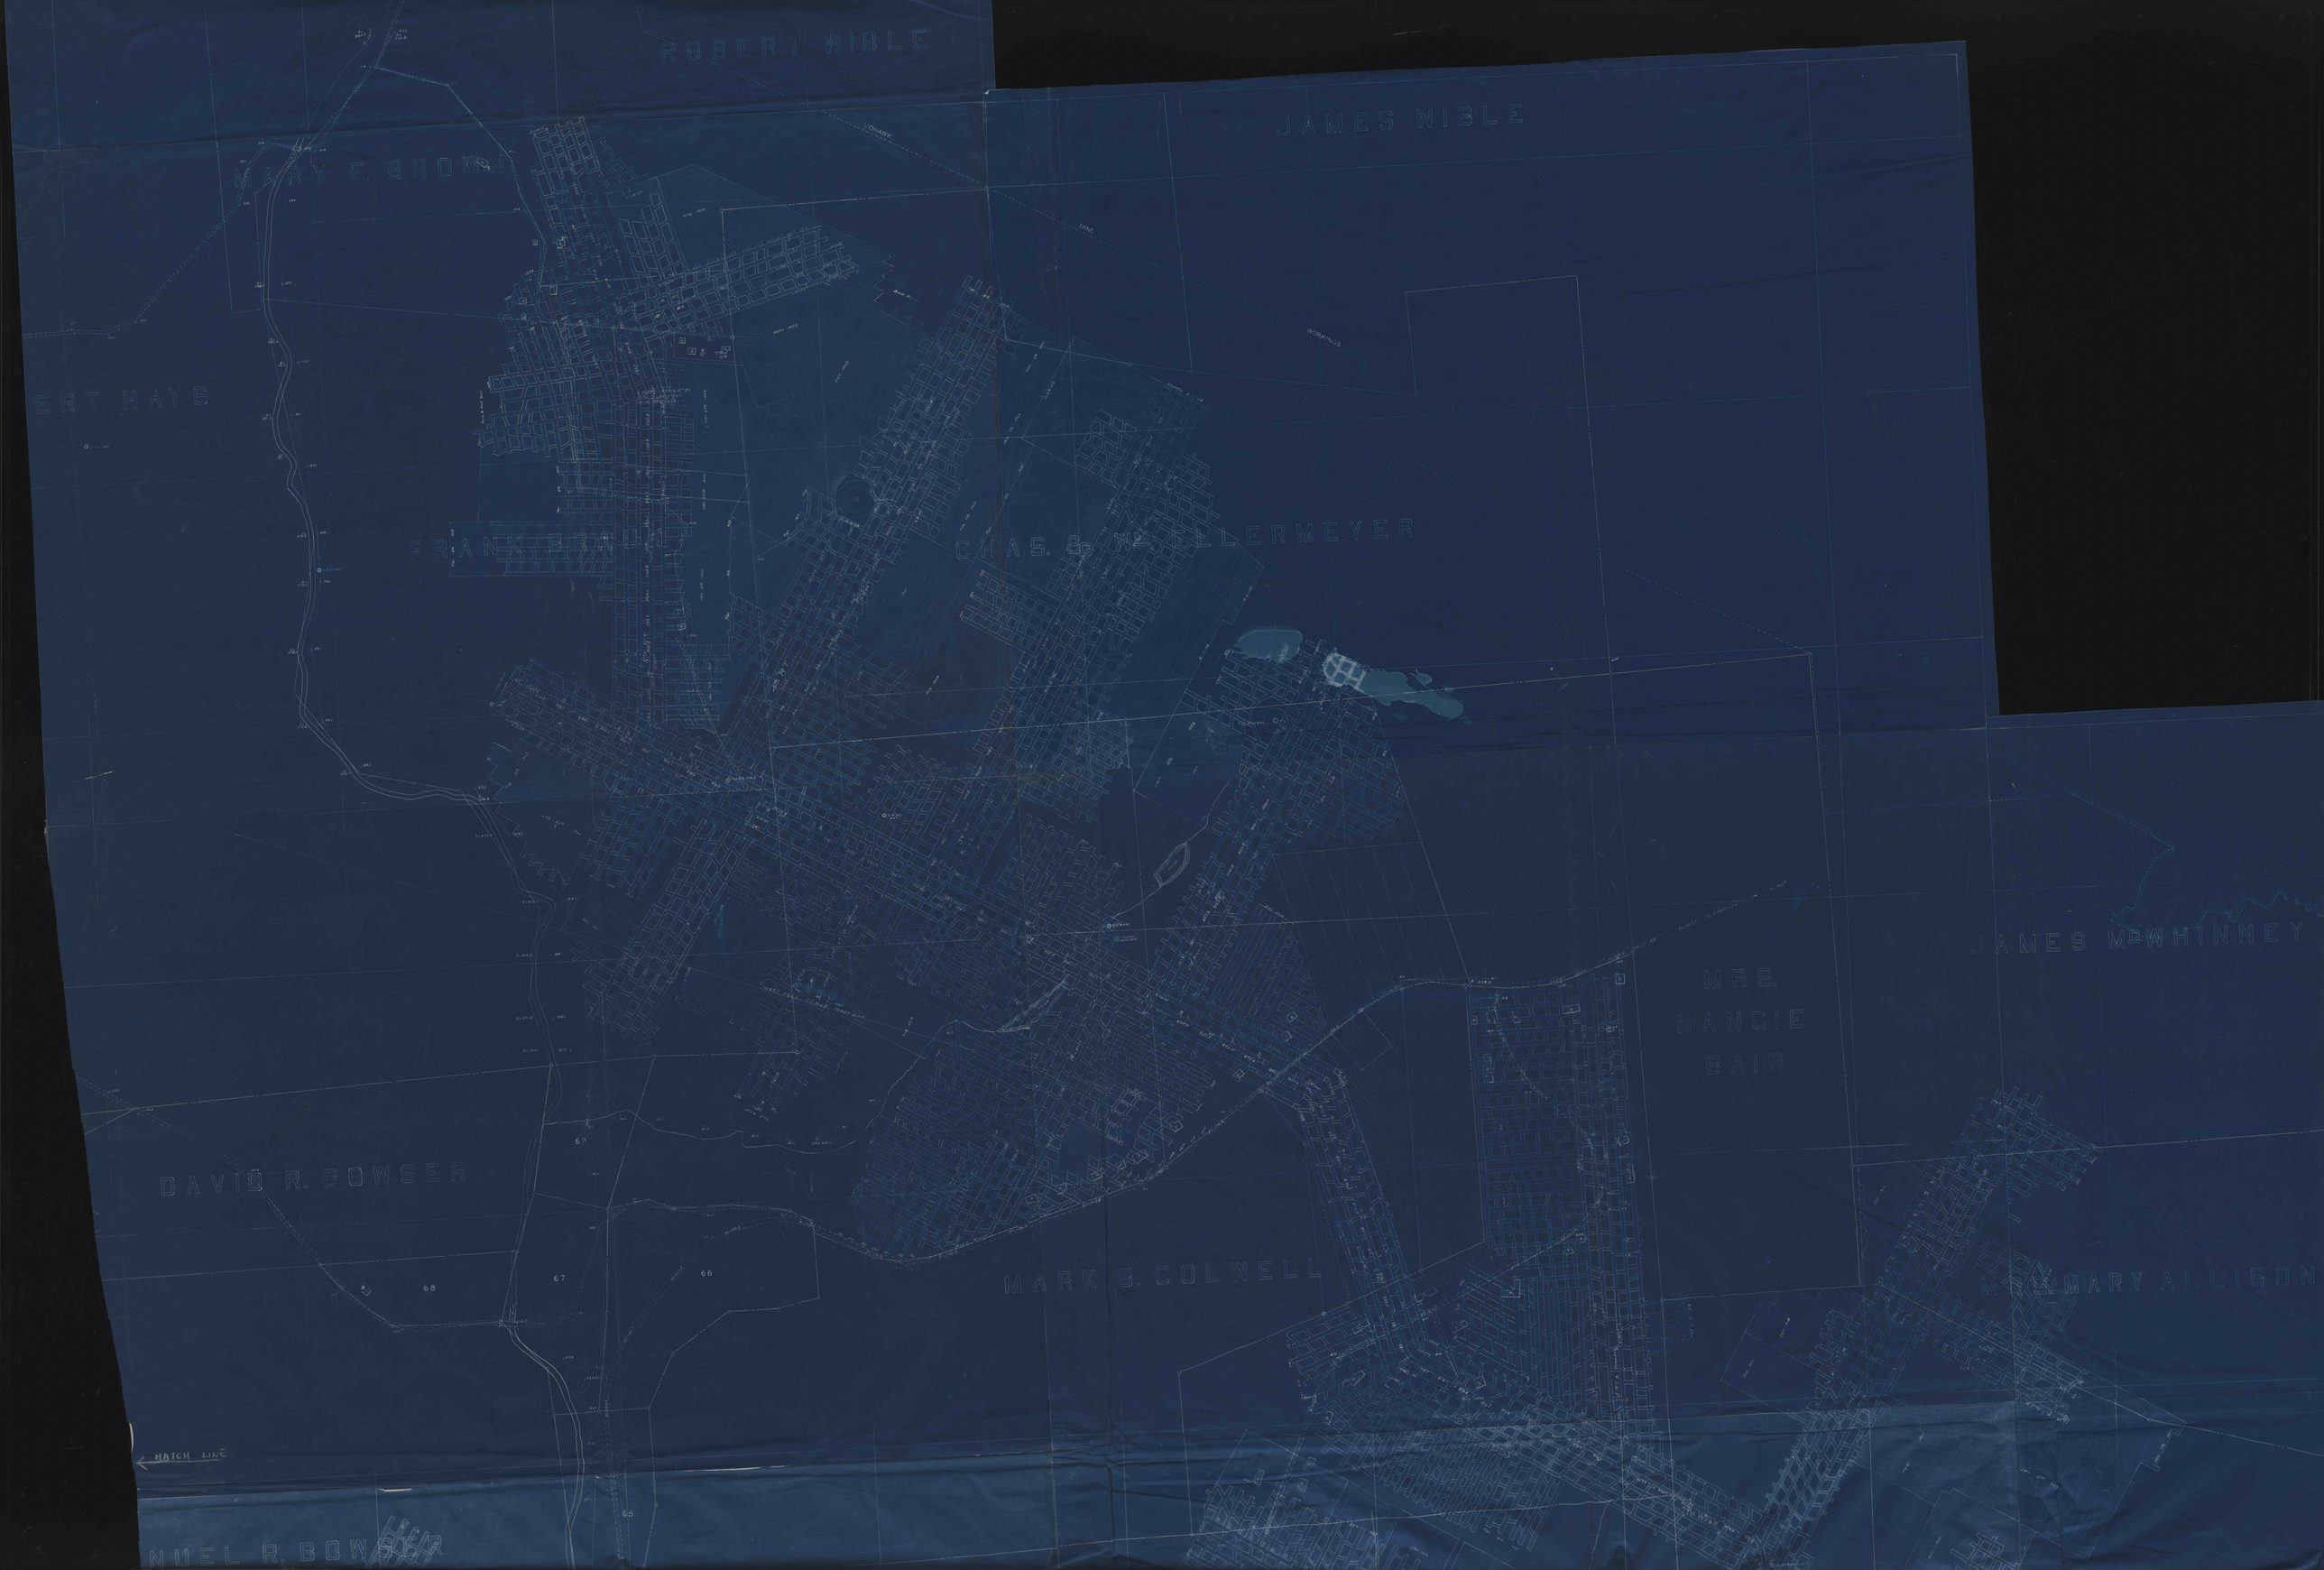
ROBERT WIBLE
JAMES WIBLE
MARY E. BROWN
ERT HAYS
FRANK BAIR
CHAS. & WM. ILLERMEYER
JAMES McWHINNEY
MRS. NANCIE BAIR
DAVID R. BOWSER
MARK B. COLWELL
MARY ALLISON
MATCH LINE
NUEL R. BOWSER