


H A L E E S T A T E

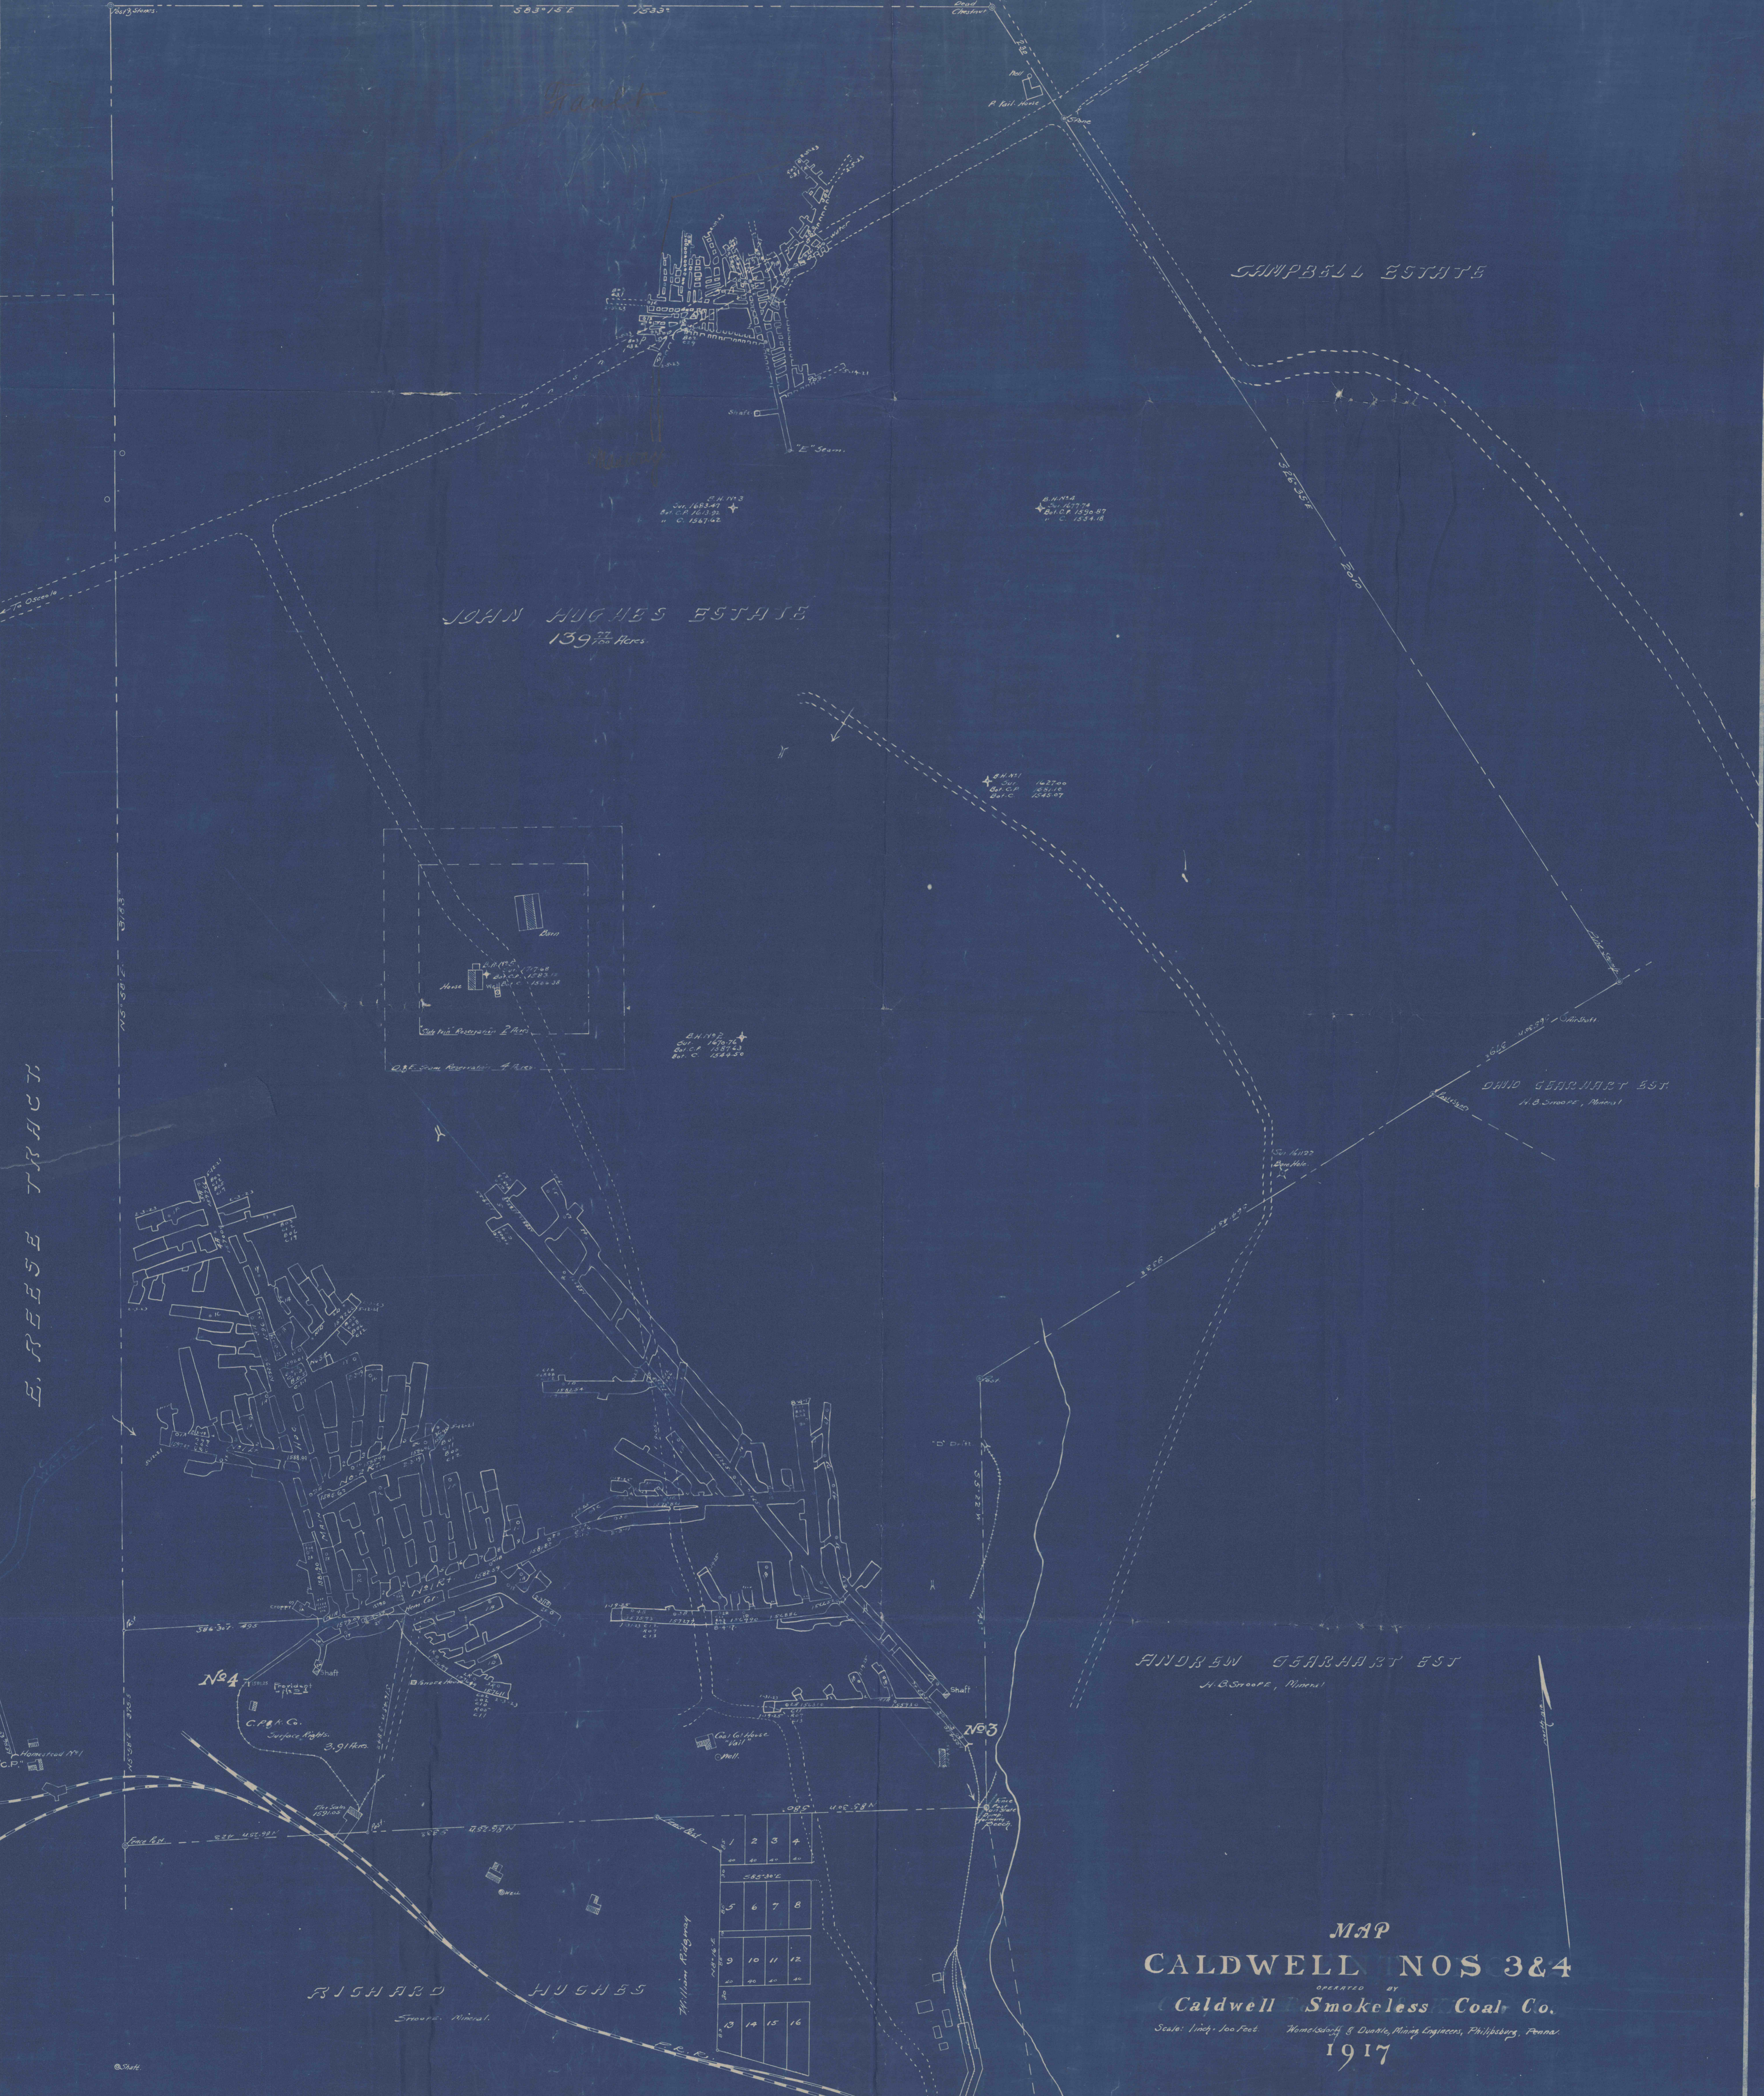

JOHN HUGHES ESTATE
139⁷² Acres

CAMPBELL ESTATE

E. REESE TRACT

AND GARHART EST
W.B. SPOFF, Minn.

ANDREW GARHART EST
W.B. SPOFF, Minn.

RICHARD HUGHES
SPOFF, Minn.

MAP
CALDWELL NOS 3&4
 OPERATED BY
Caldwell Smokeless Coal Co.
 1917

1	2	3	4
5	6	7	8
9	10	11	12
13	14	15	16